


OVERLAP  
 1  
 2  
 4  
 5  
 6

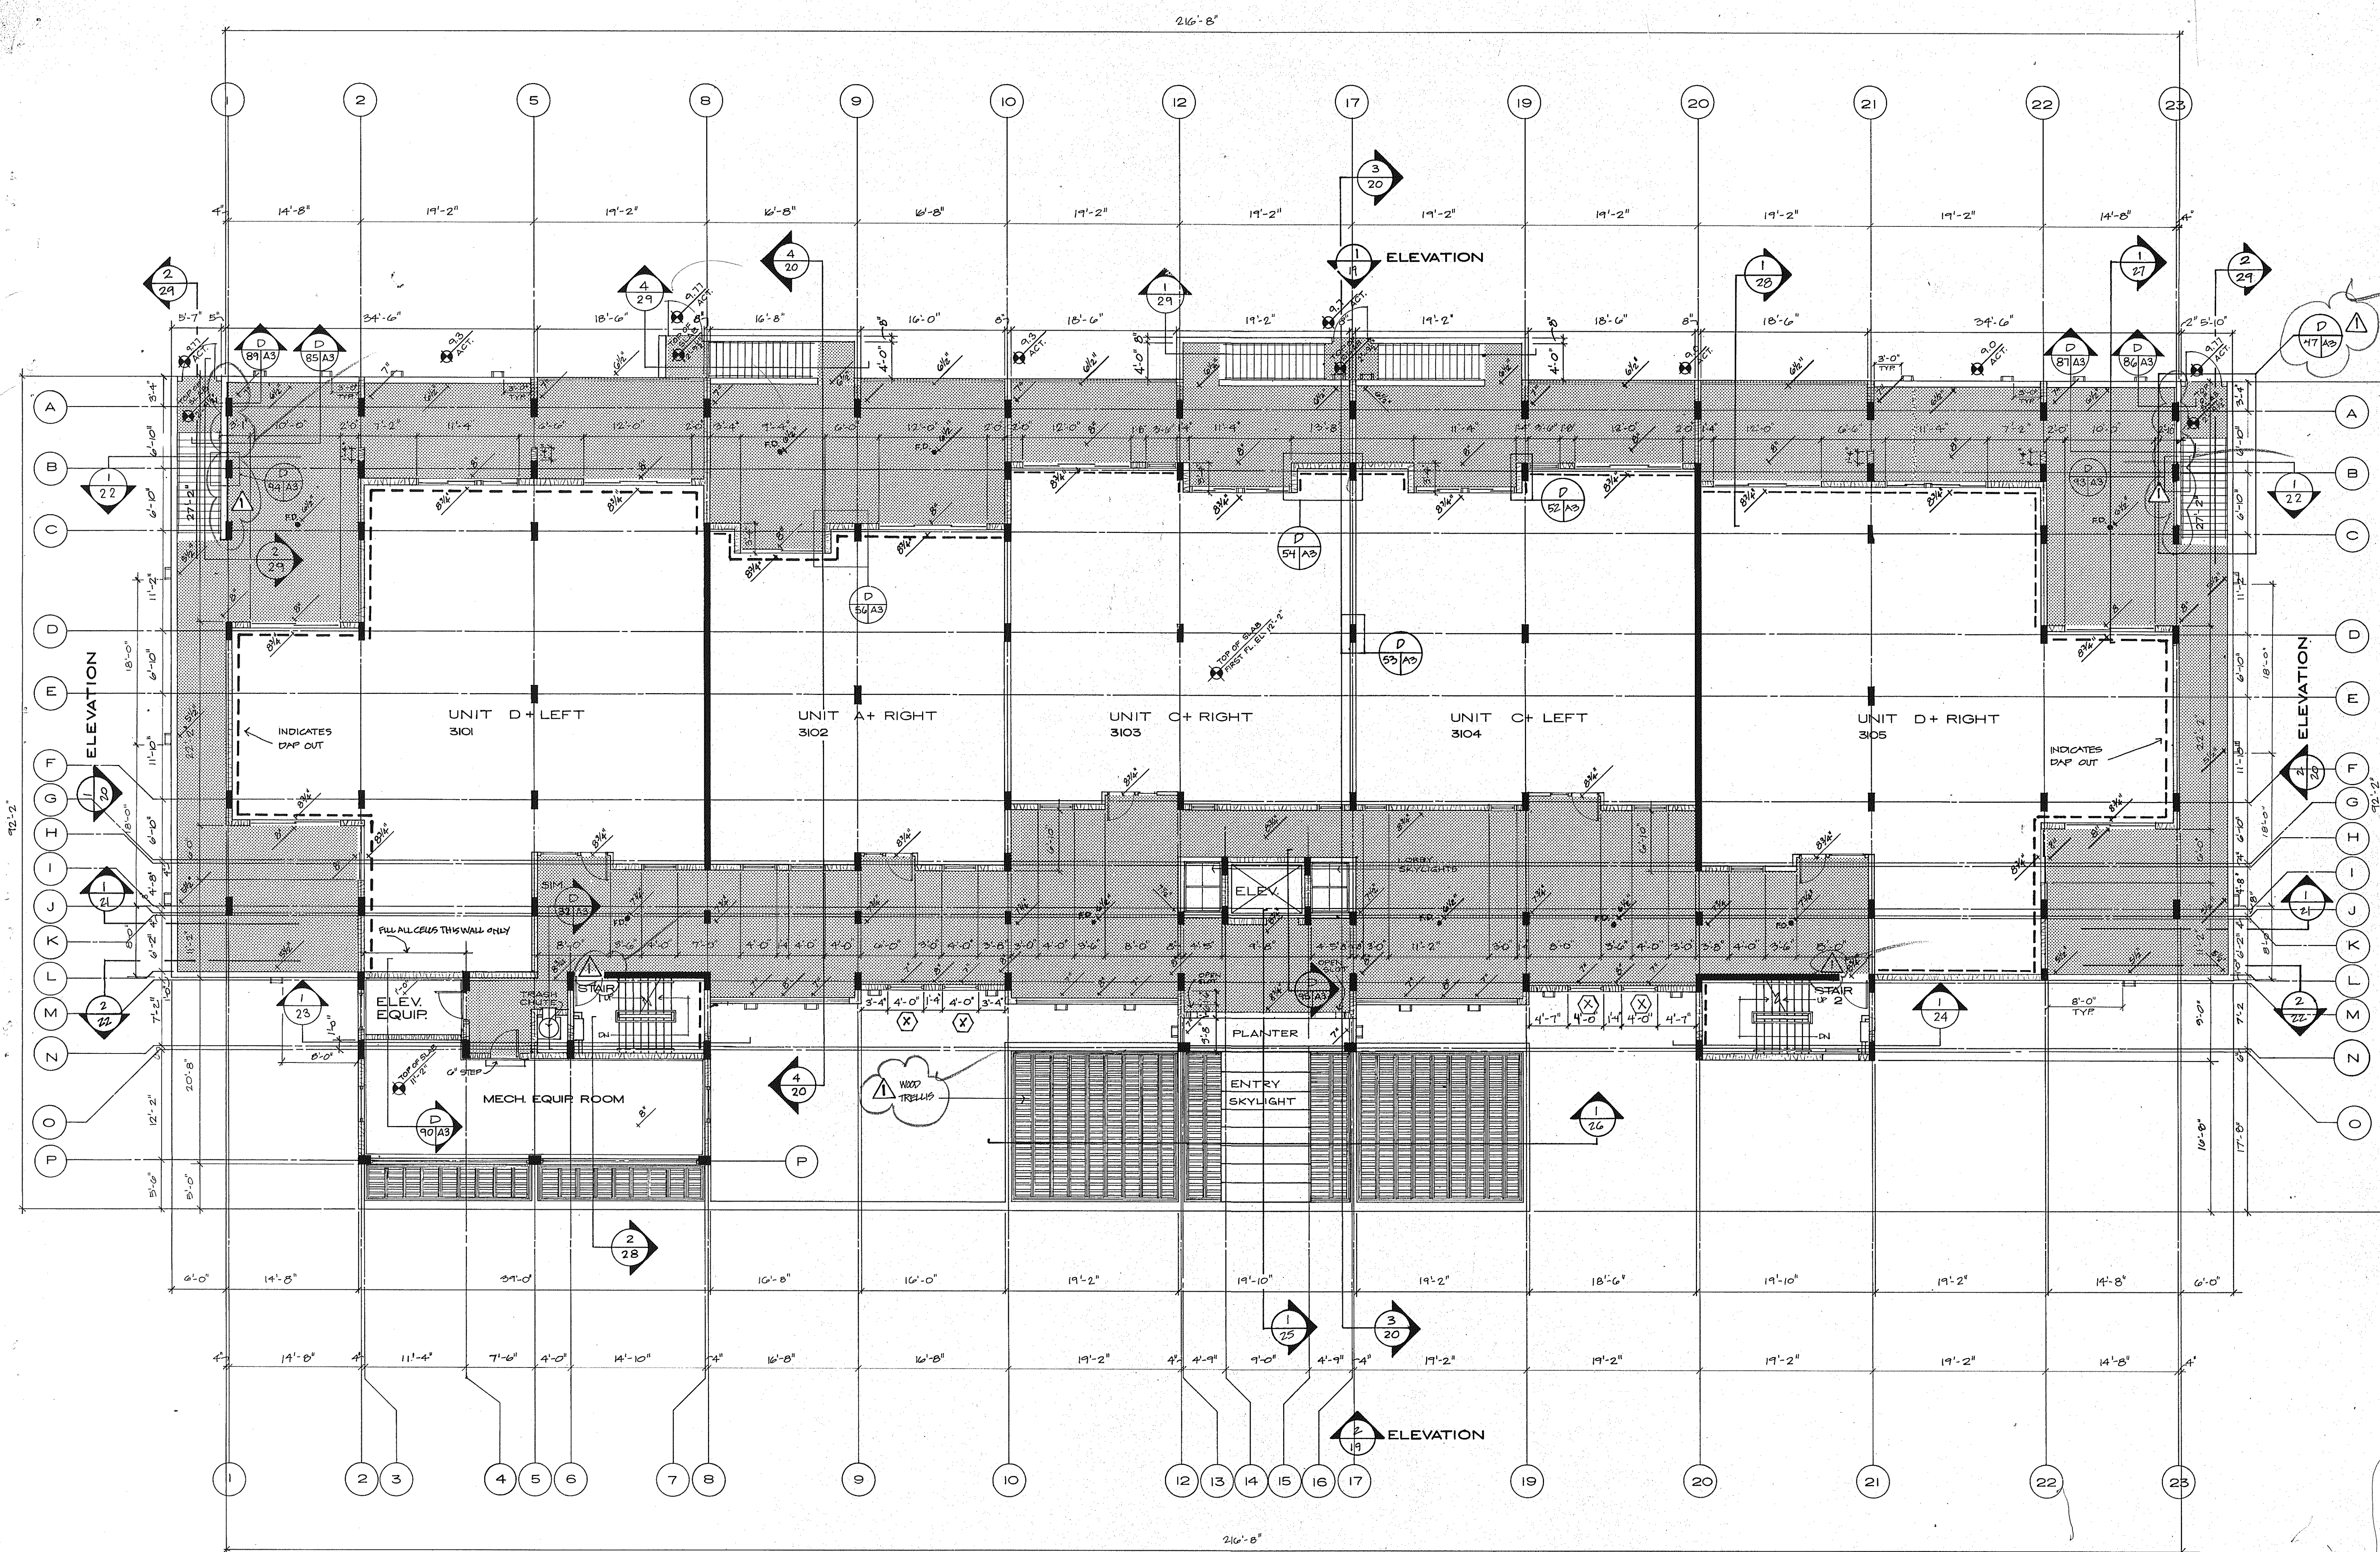

**SUNSET BEACH**  
 SOFLO N G BOAT KEY  
 BUILDING 3 FIRST FLOOR PLAN 1/8" = 1'-0"  
 ARVIDA CORPORATION · EDWARD J. SUBERT AIA ARCHITECT & PLANNER PA · THE SWA GROUP  
 ABRAHAM KUHN'S DEBAY CONSULTING ENGINEERS · OLSEN WHITE & ASSOCIATES STRUCTURAL ENGINEERS · BENNETT & BISHOP INC CONSULTING ENGINEERS & SURVEYORS  
 ISSUED 10 DEC. 82  
 REVISED 4-1-83  
 SHEET A.3 OF