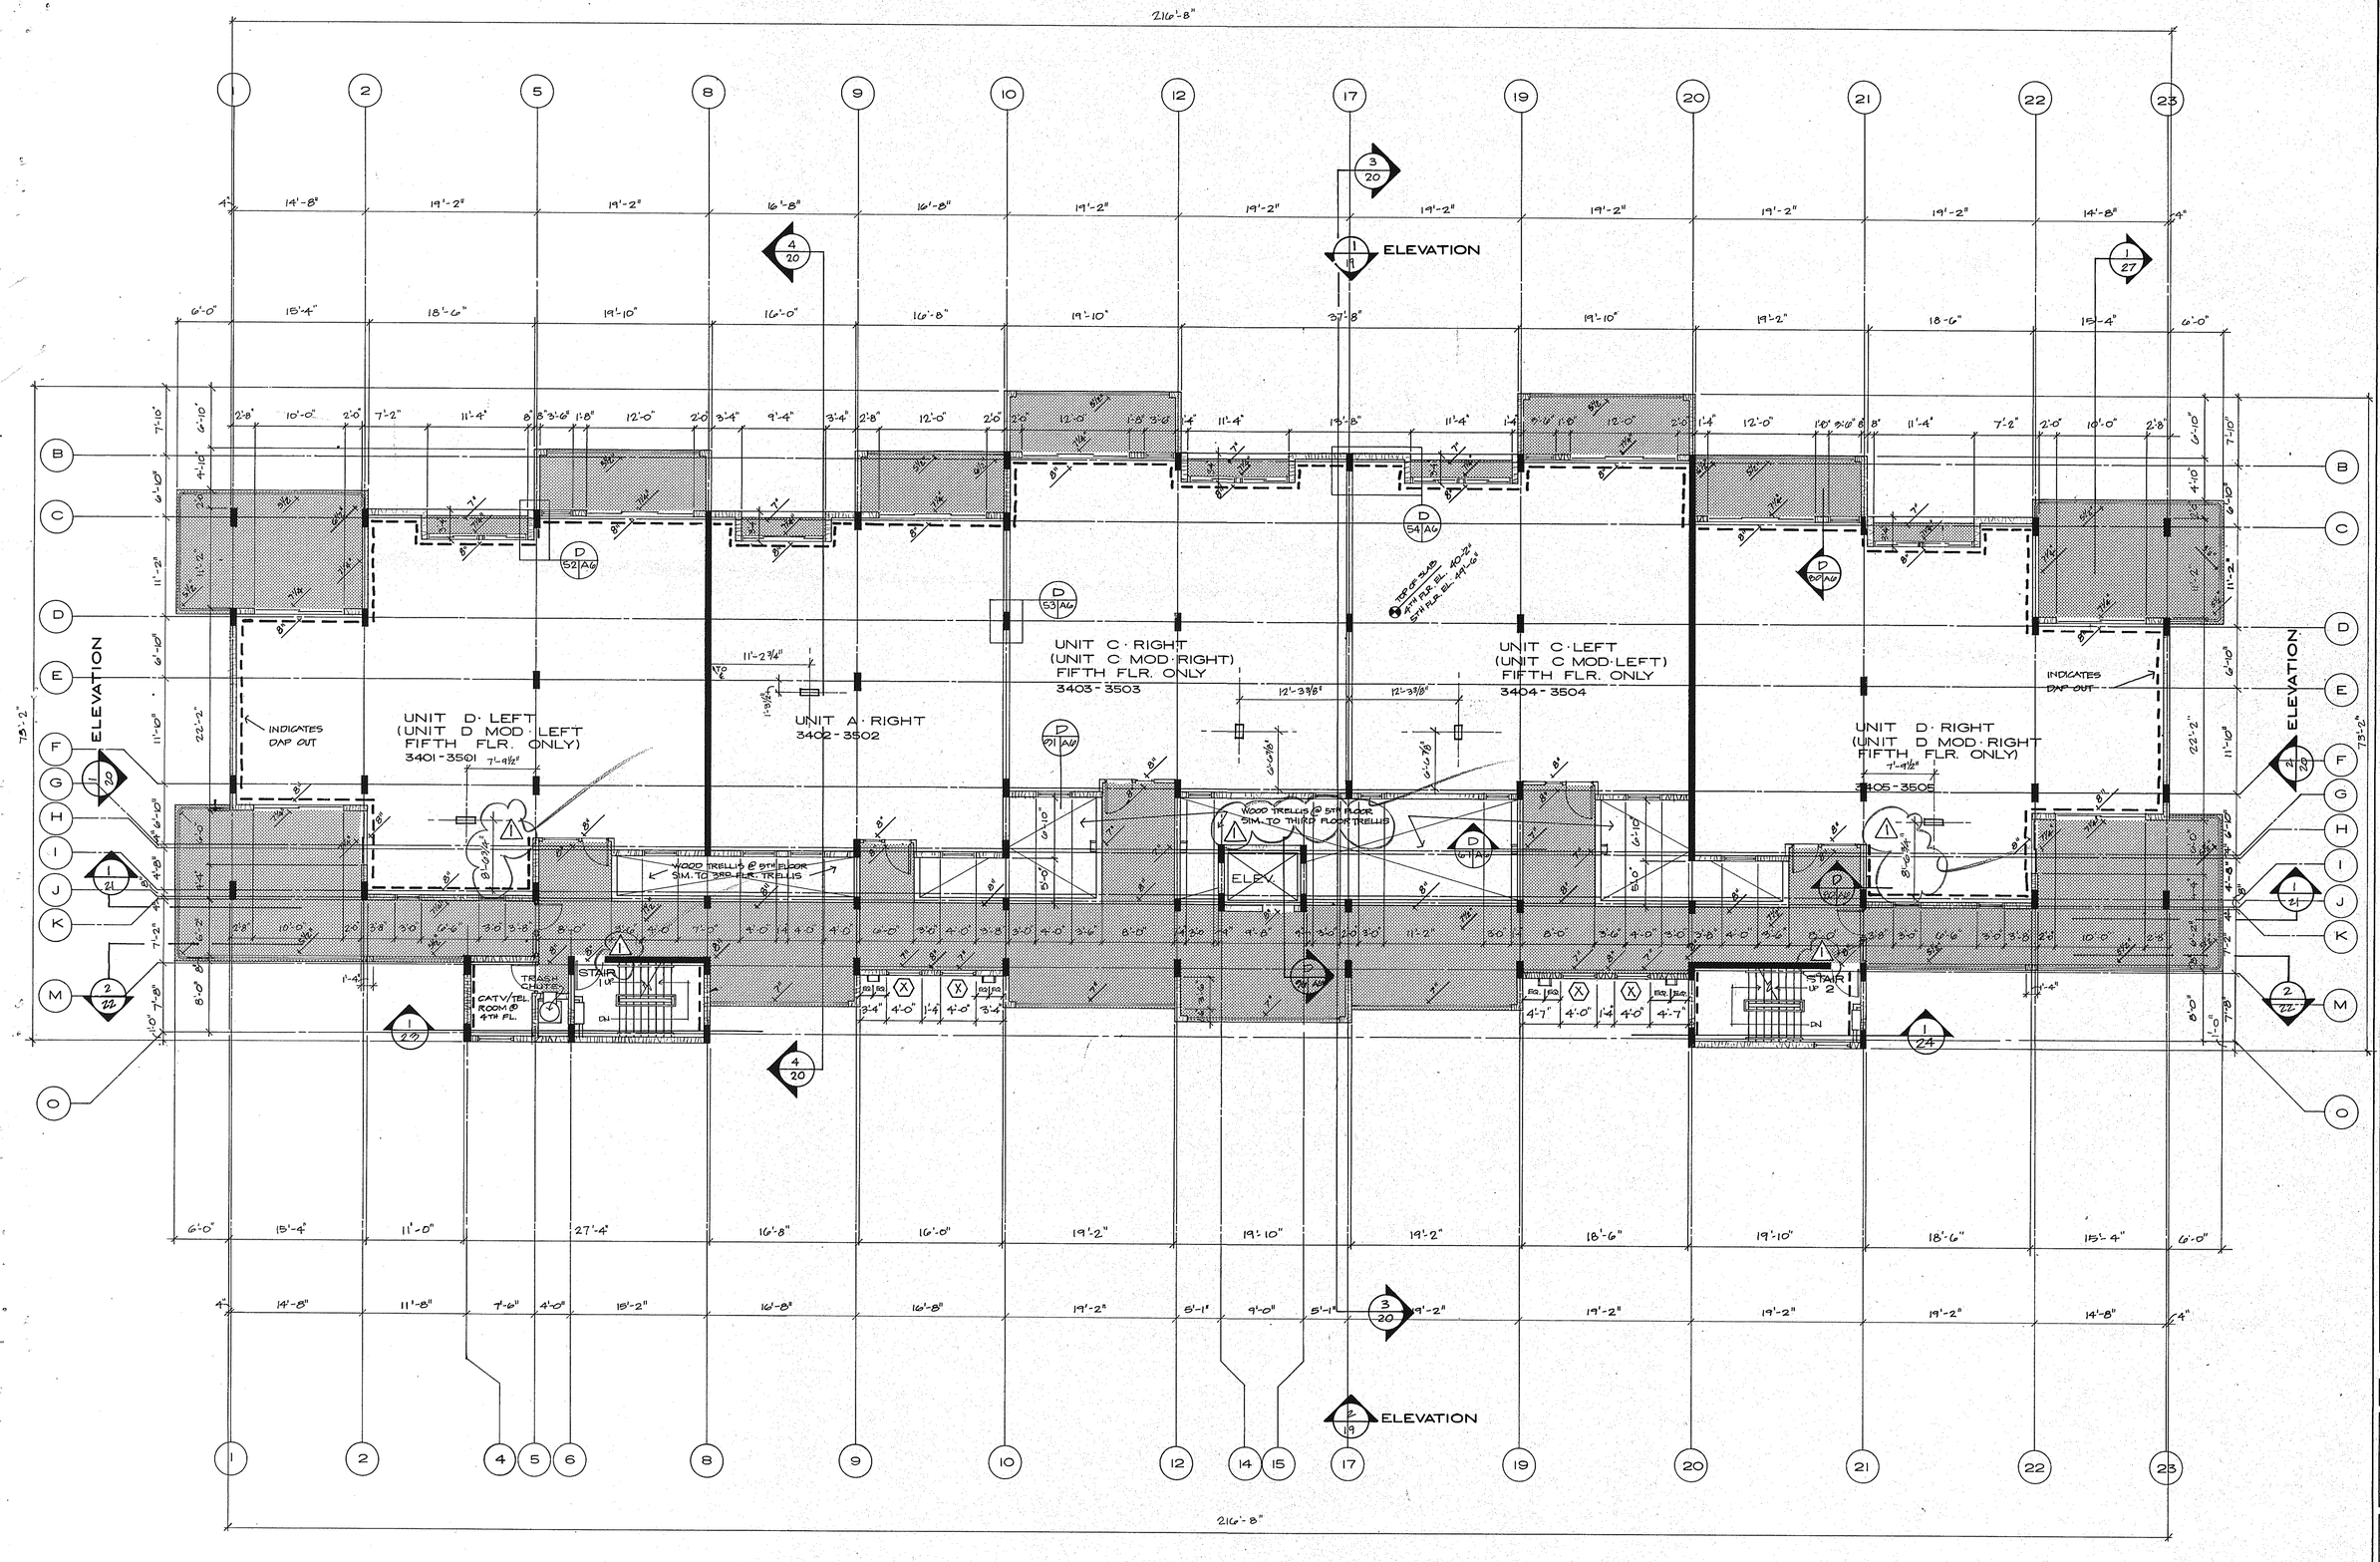

SUNSET BEACH OF LONGBOAT KEY

BUILDING 3 FOURTH & FIFTH FLOOR PLAN

1/8" = 1'-0"

ARVIDA CORPORATION · EDWARD J SEIBERT, AIA ARCHITECT & PLANNER PA · THE SWA GROUP · BRABHAM KUHNS DEBAY CONSULTING ENGINEERS · BENNETT & BISHOP INC CONSULTING ENGINEERS & SURVEYORS · OLSEN WHITE & ASSOCIATES STRUCTURAL ENGINEERS

ISSUED
10 DEC. 82

REVISED
1 4-1-83

SHEET

A·6

OF 37