


OVERLAYS  
 13 13  
 2 2  
 3 3  
 4 4  
 5 5  
 6 6  
 7 7  
 8 8  
 9 9  
 10 10  
 11 11  
 12 12  
 13 13  
 14 14  
 15 15  
 16 16  
 17 17  
 18 18  
 19 19  
 20 20  
 21 21  
 22 22  
 23 23

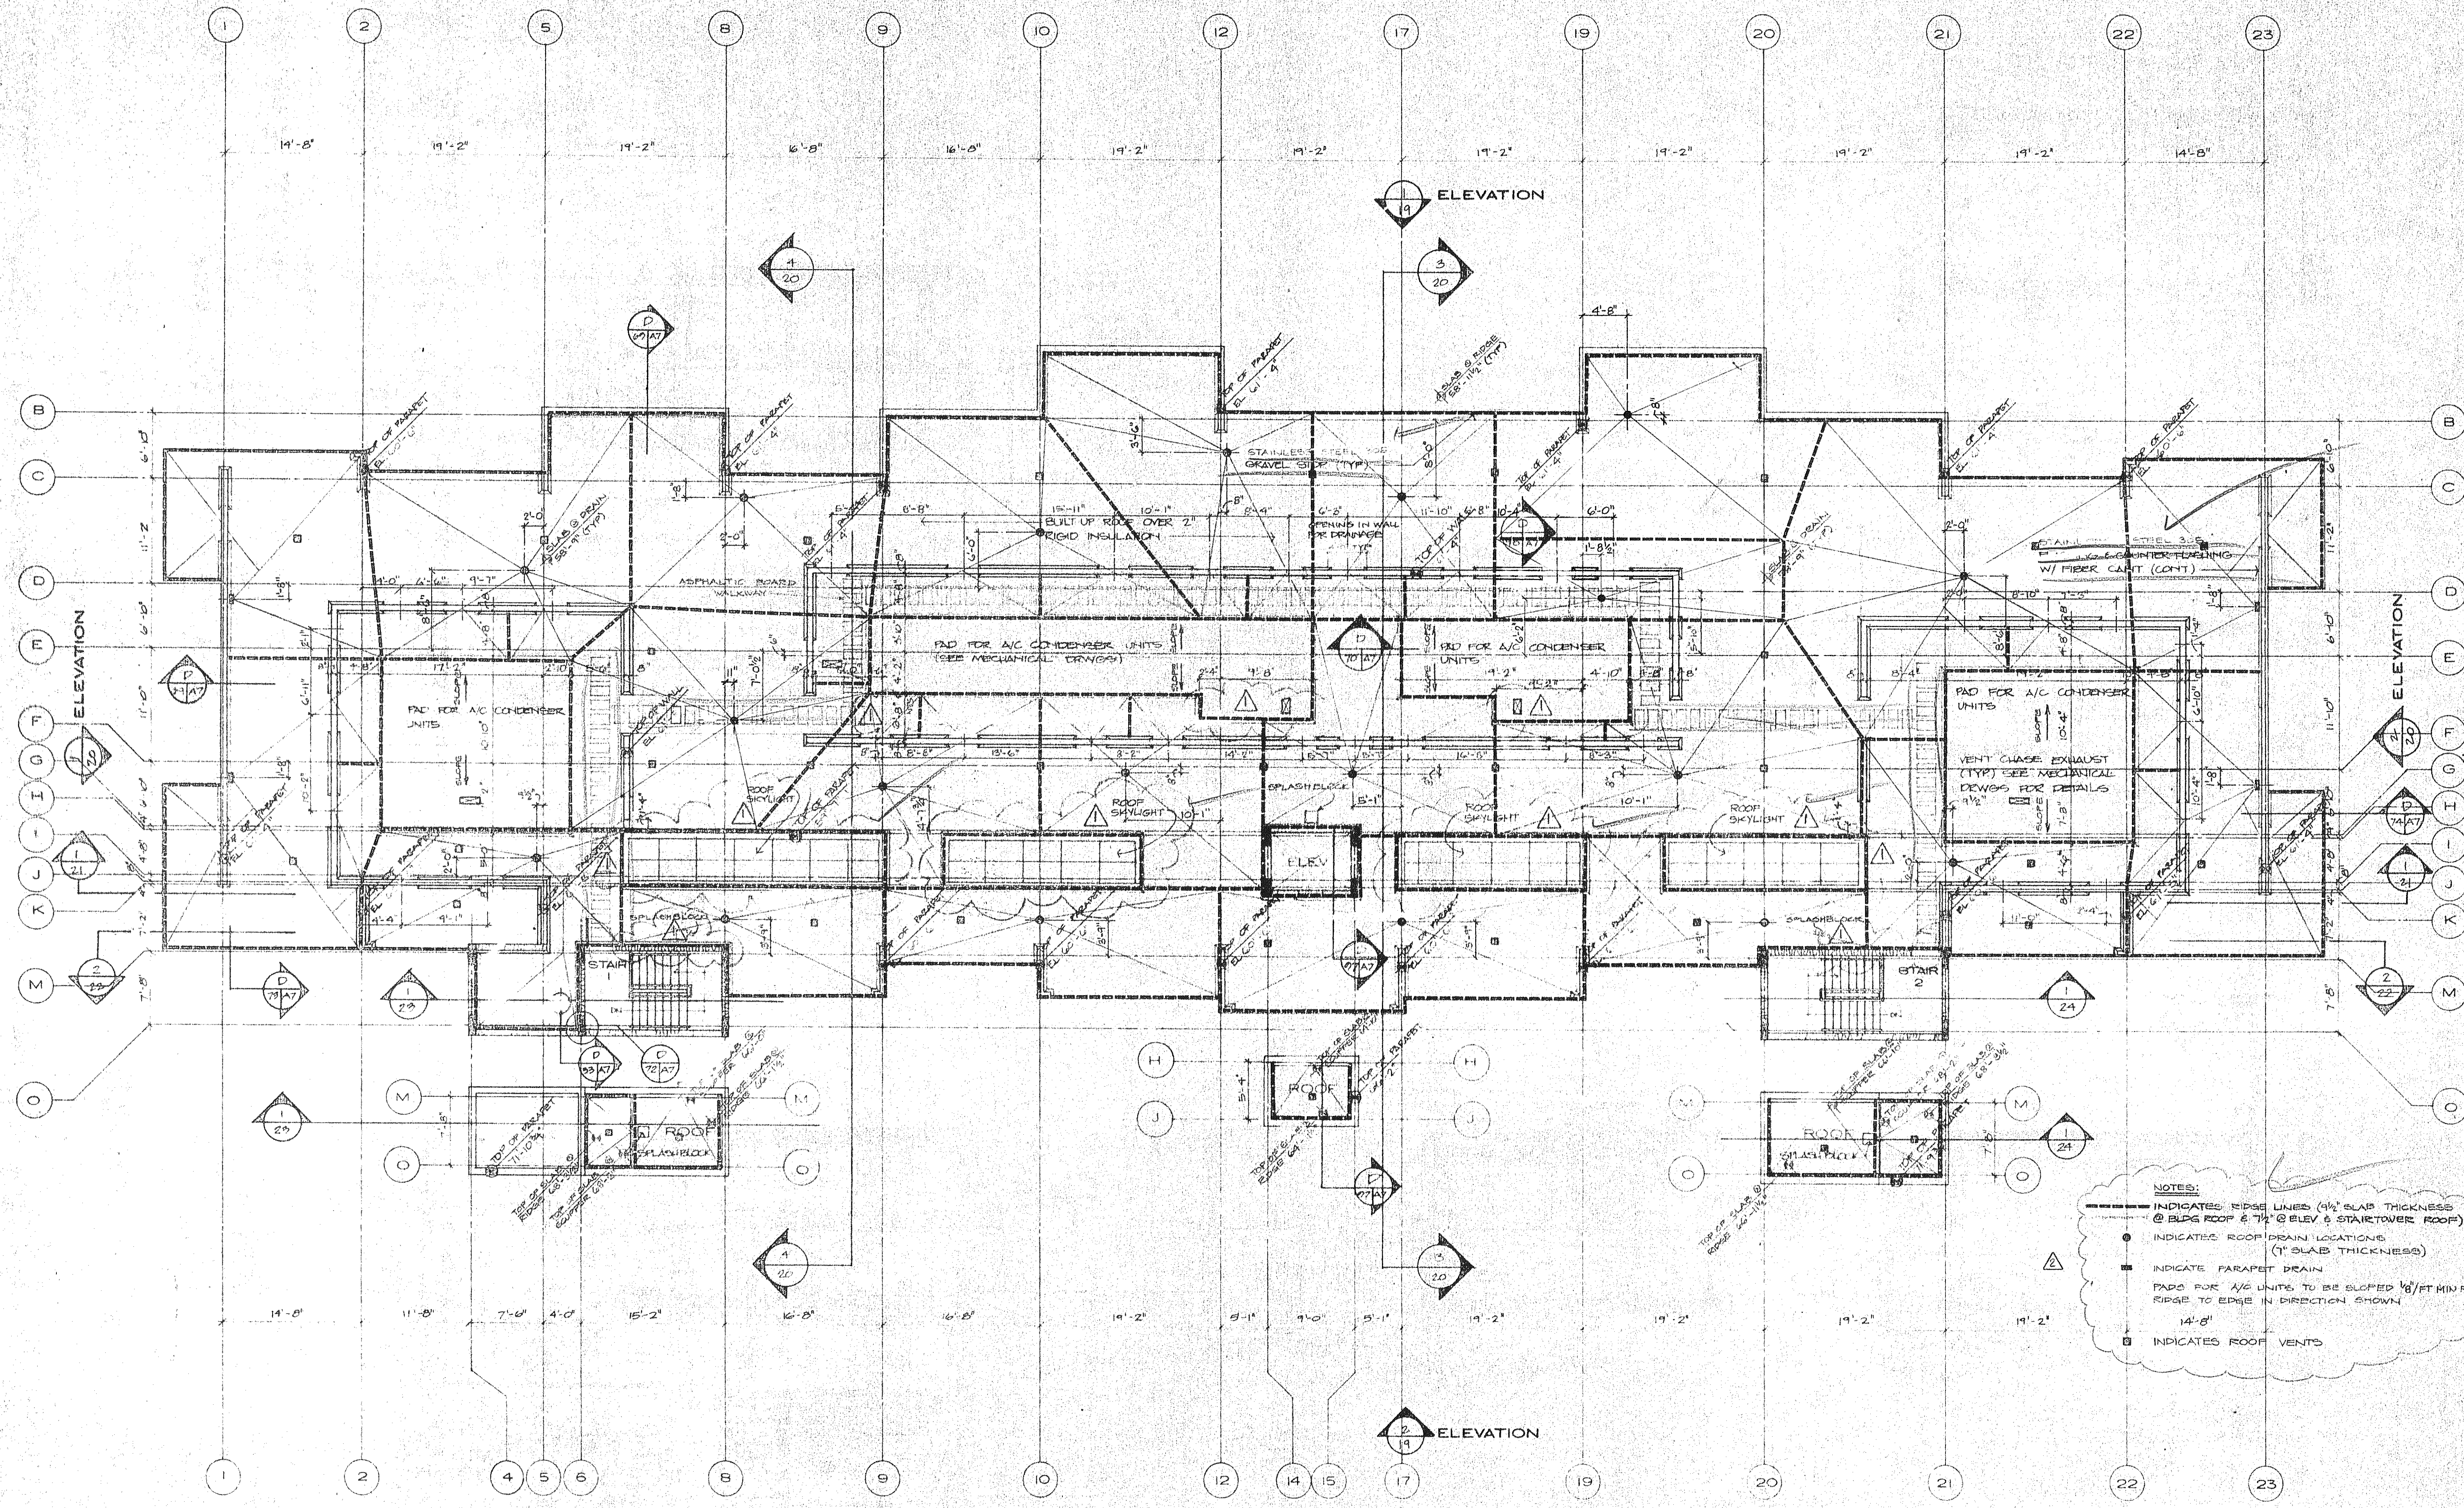

NOTES:  
 - - - - - INDICATES EDGE LINES (4 1/2" SLAB THICKNESS @ BLDG ROOF & 7 1/2" @ ELEV & STAIR TOWER ROOF)  
 ○ INDICATES ROOF DRAIN LOCATIONS (1" SLAB THICKNESS)  
 ■ INDICATE PARAPET DRAIN PADS FOR A/C UNITS TO BE SLOPED 1/8" FT MIN FROM RISE TO EDGE IN DIRECTION SHOWN  
 □ INDICATES ROOF VENTS

SUNSET BEACH BOAT KEY  
 OF LONG BEACH  
 BUILDING 3 ROOF PLAN 1/8" = 1'-0"  
 ISSUED 10 DEC 82  
 REVISED 4-1-83  
 2-1-84  
 SHEET A-7 OF 37  
 ARVADA CORPORATION, EDWARD J. SEIBERT, AIA, ARCHITECT & PLANNER, P.A., THE SVA GROUP  
 BRABHAM, KUHNS, DEBAY CONSULTING ENGINEERS, OLSEN, WHITE & ASSOCIATES' STRUCTURAL ENGINEERS, BENNETT & BISHOP, INC. CONSULTING ENGINEERS & SURVEYORS