




FIRST FLOOR PLAN

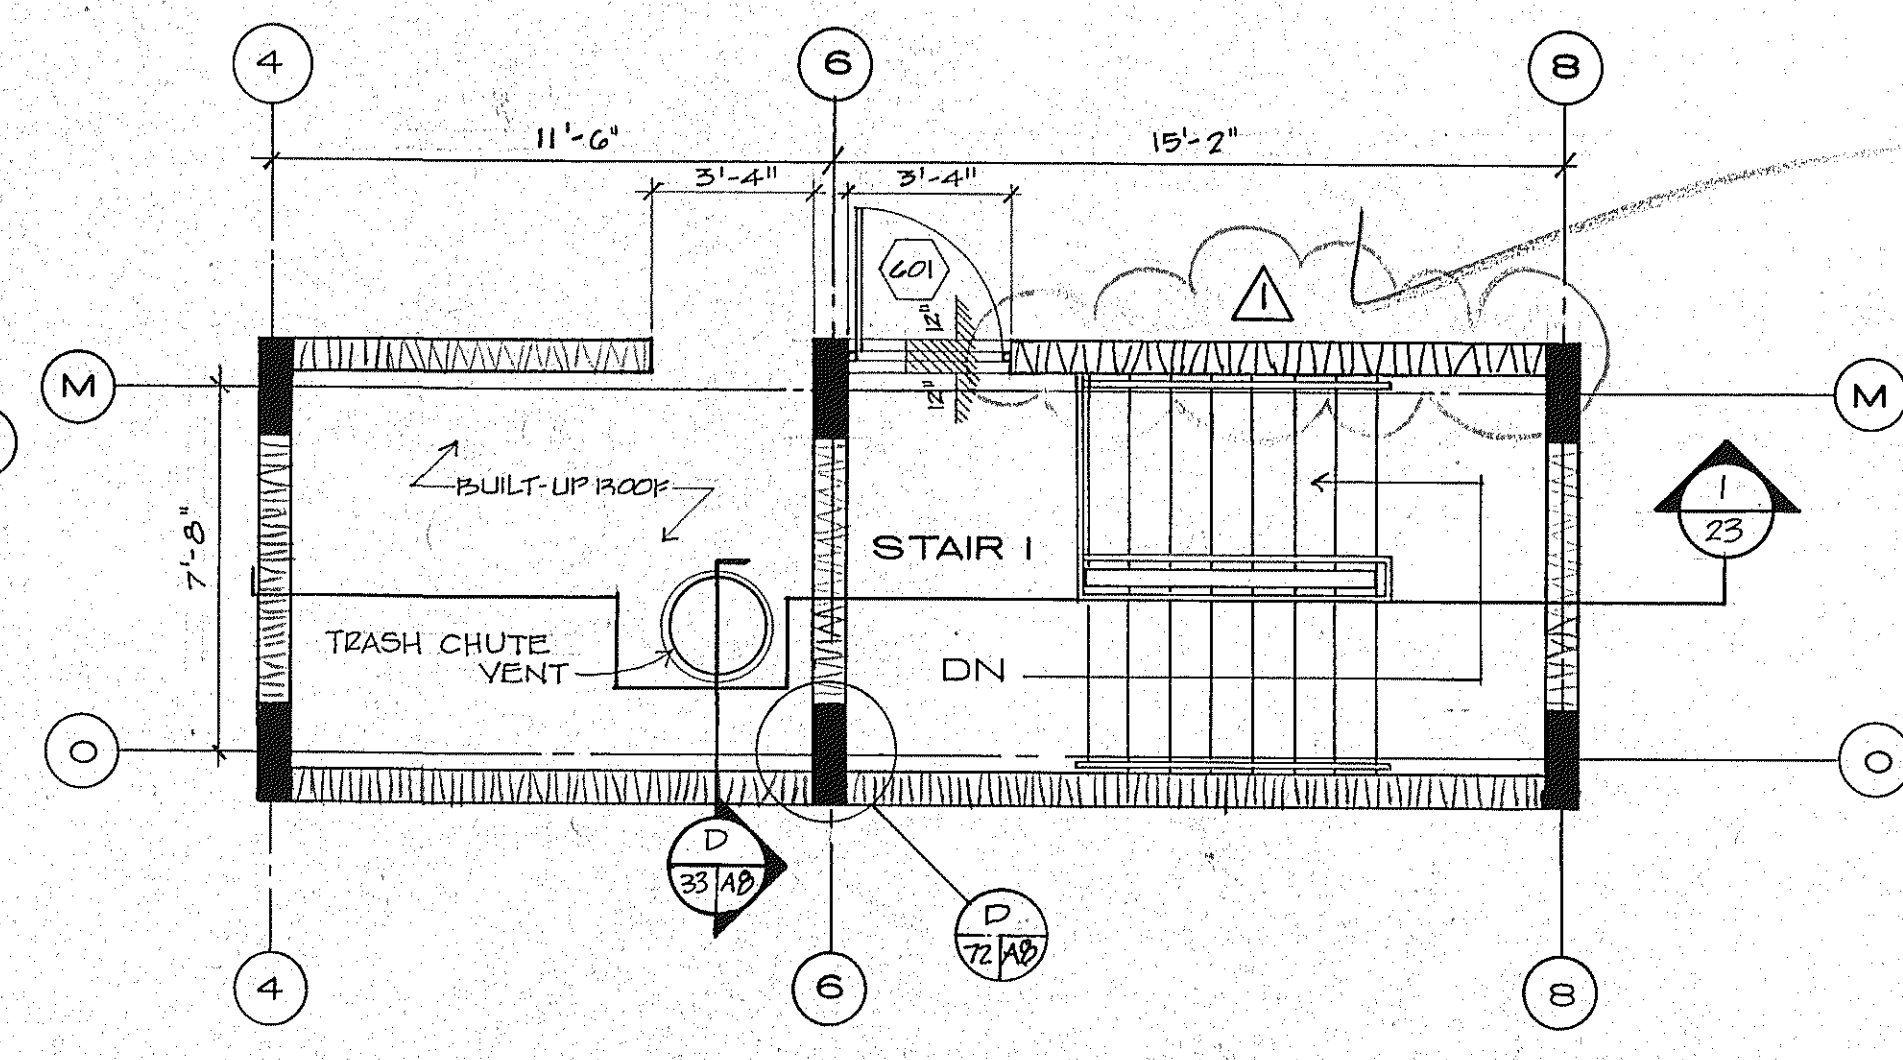


ROOF FLOOR PLAN

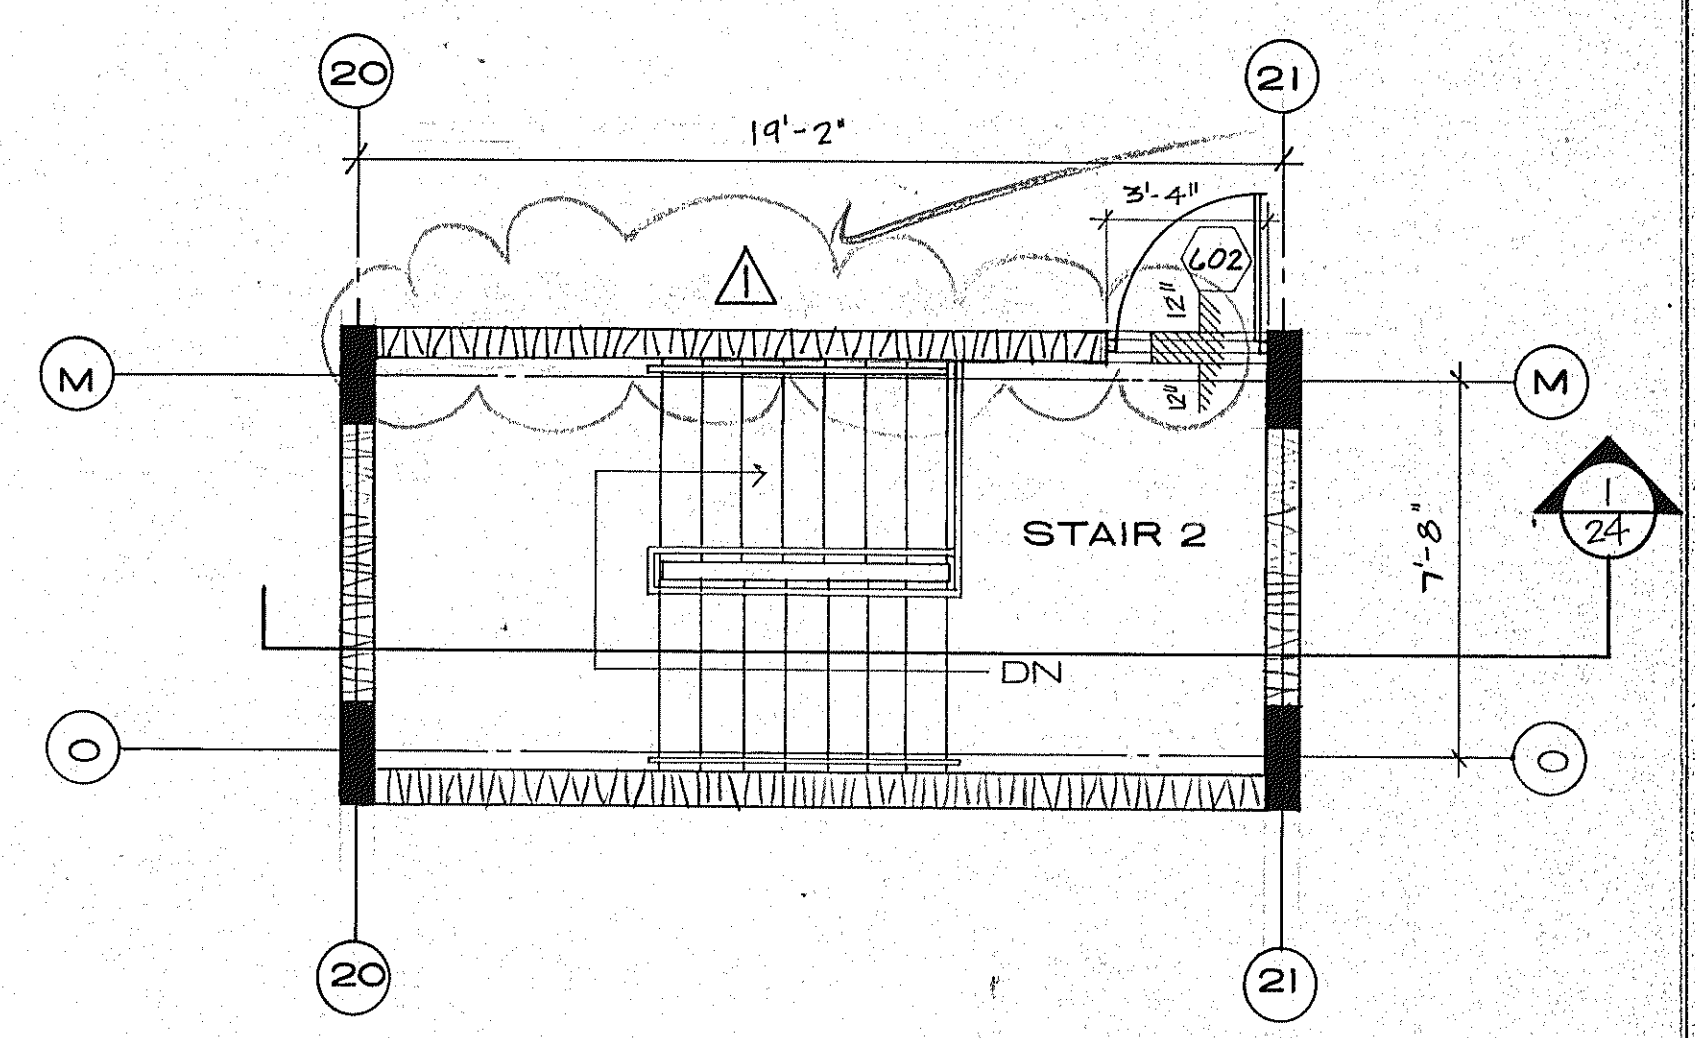


ROOF FLOOR PLAN

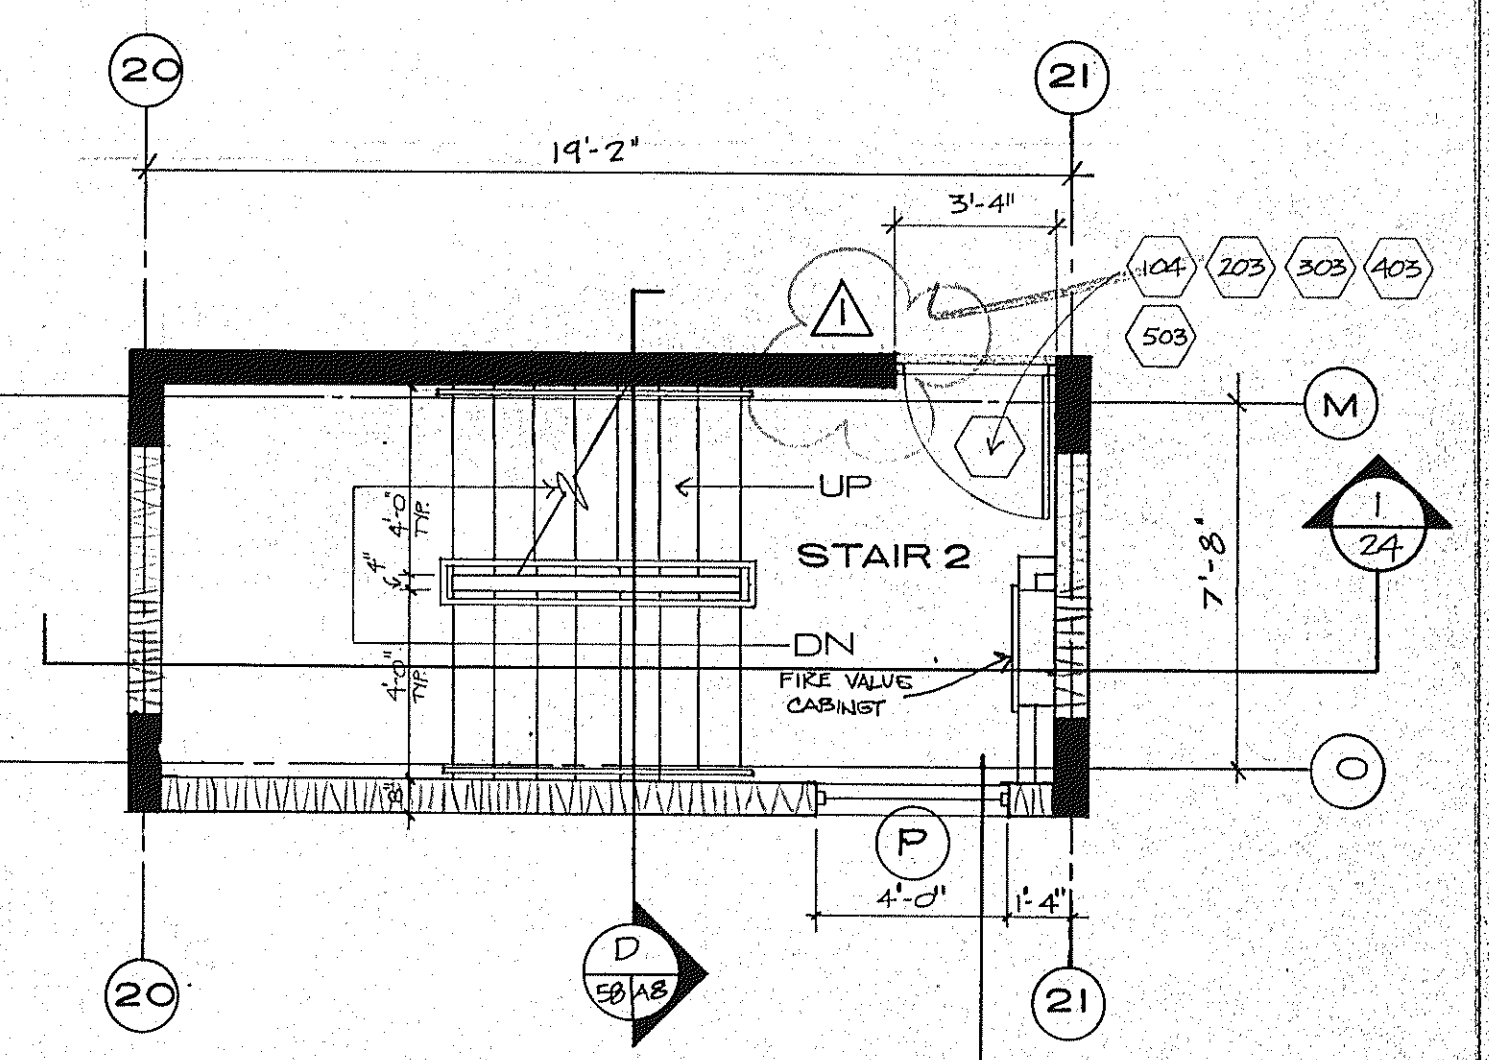


TYPICAL FIRST THRU FIFTH FLOOR PLAN

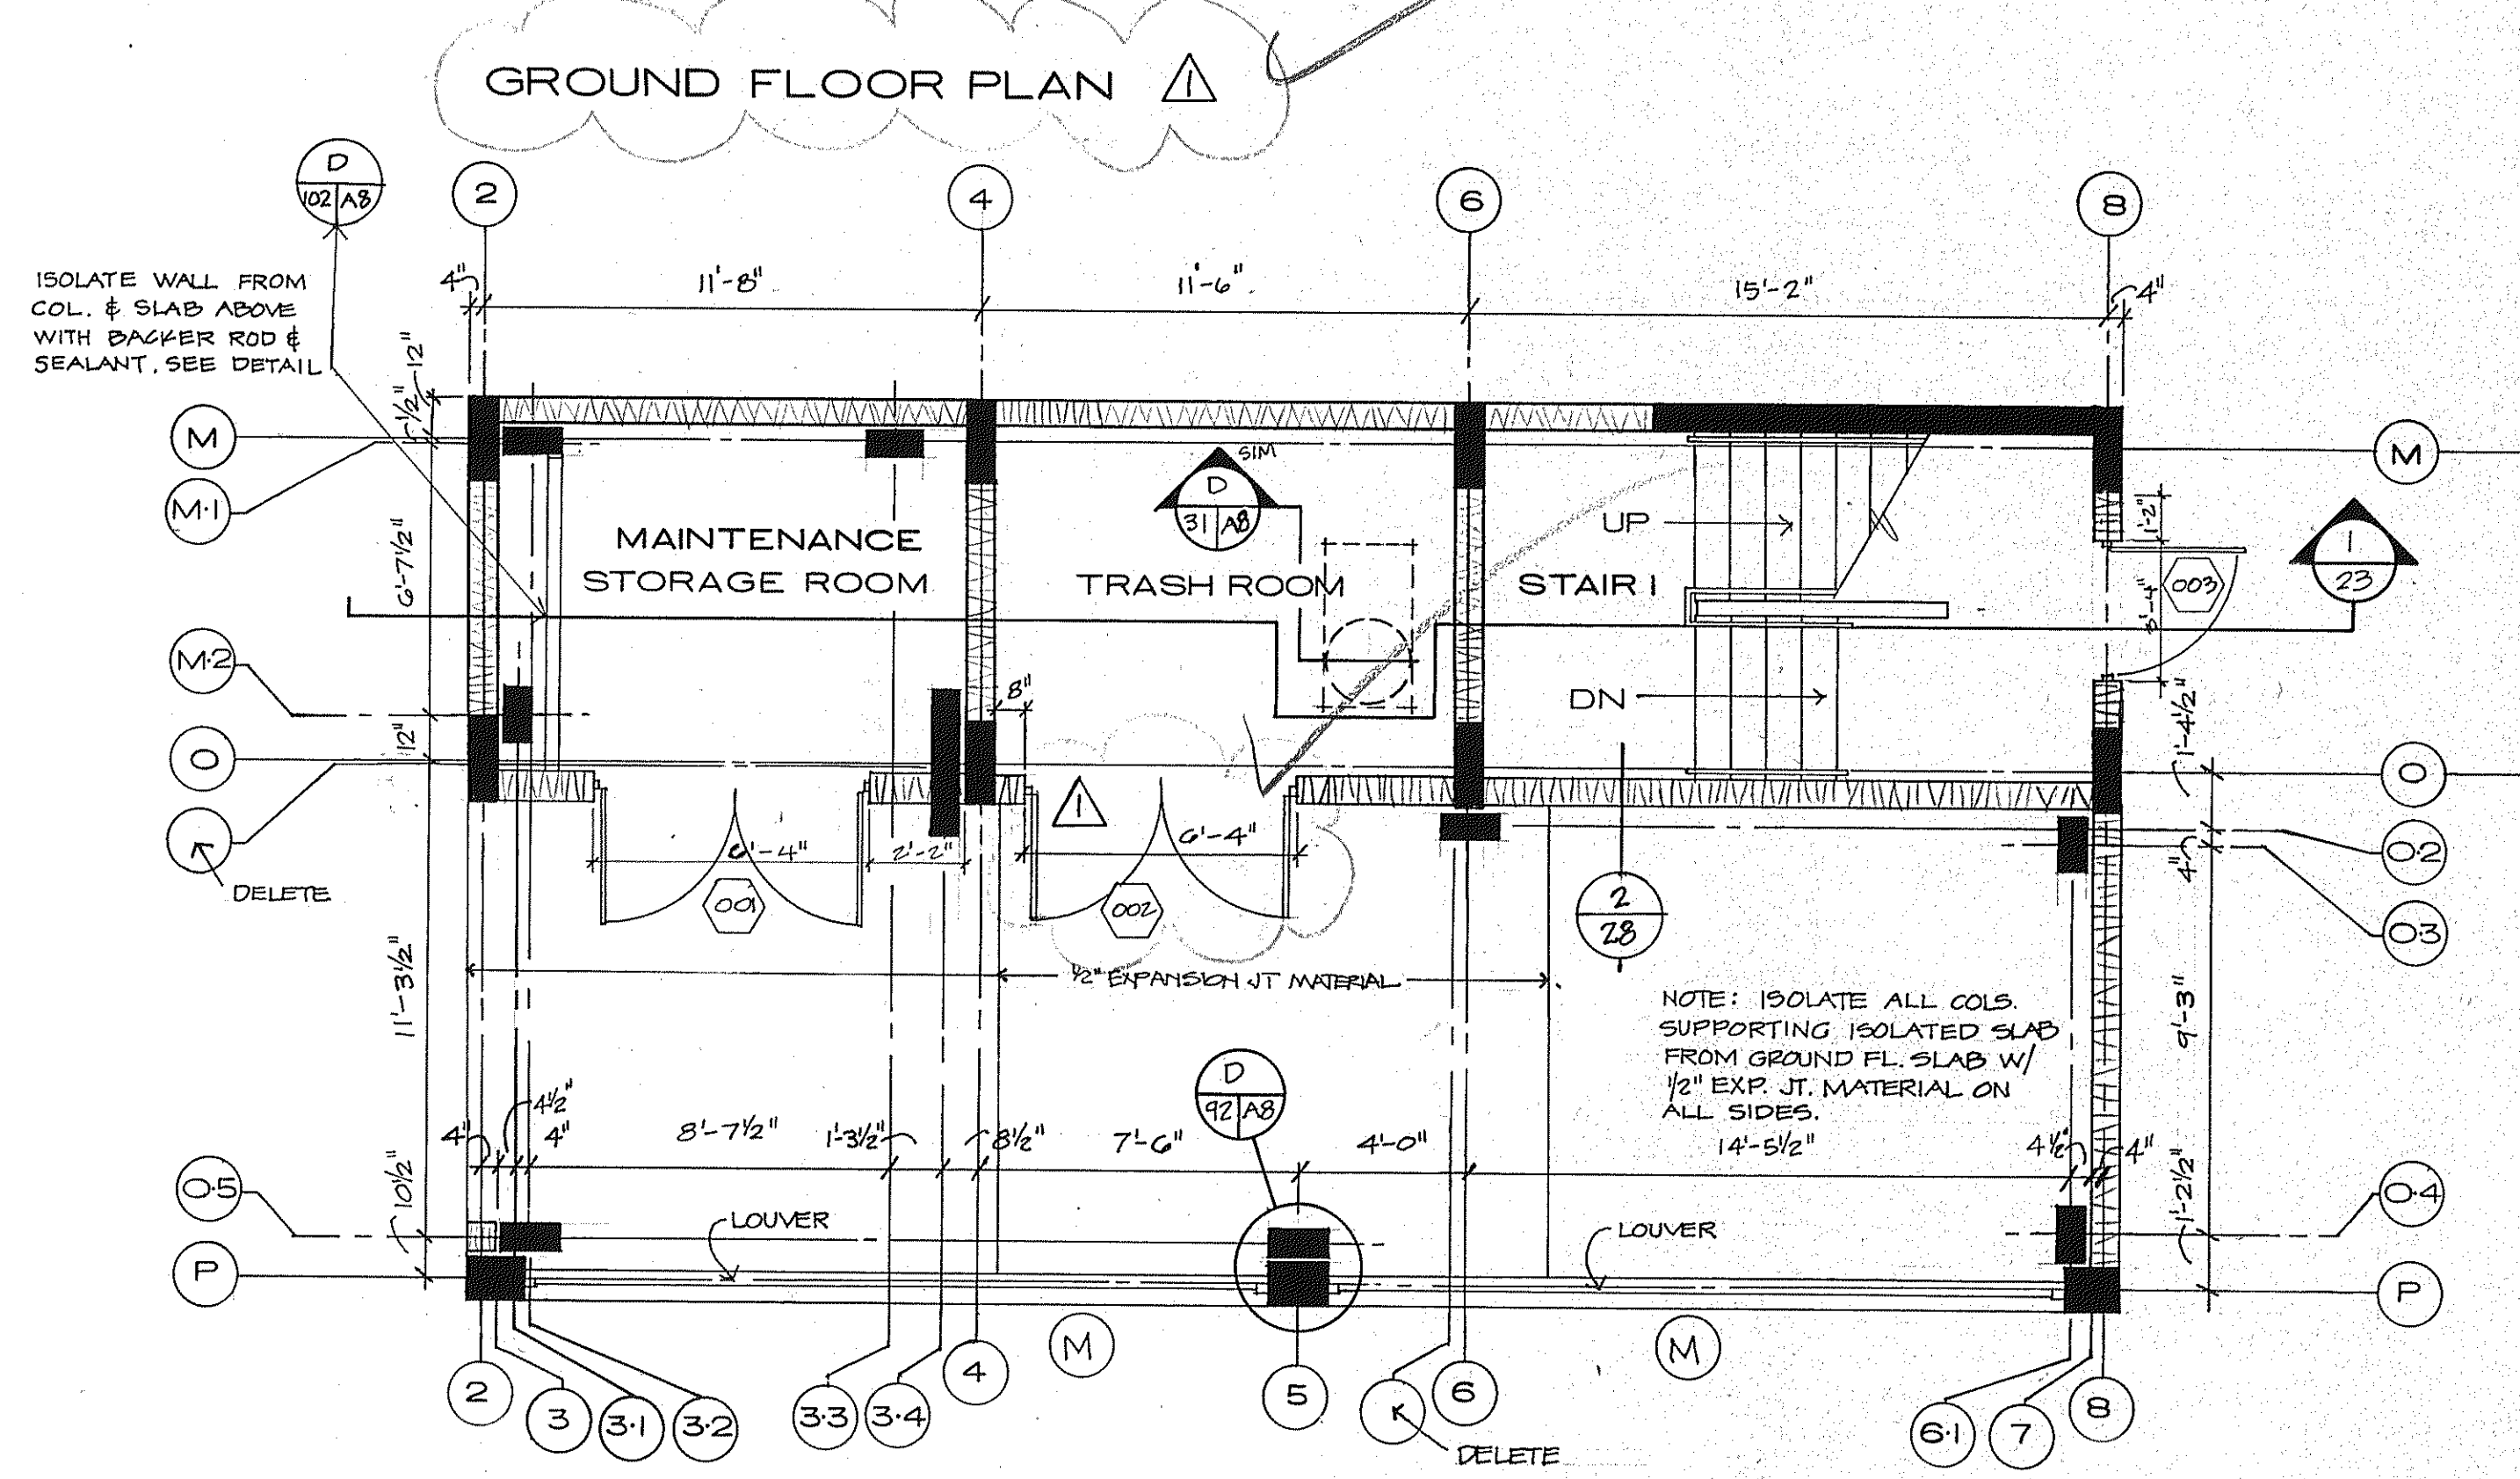

GROUND FLOOR PLAN

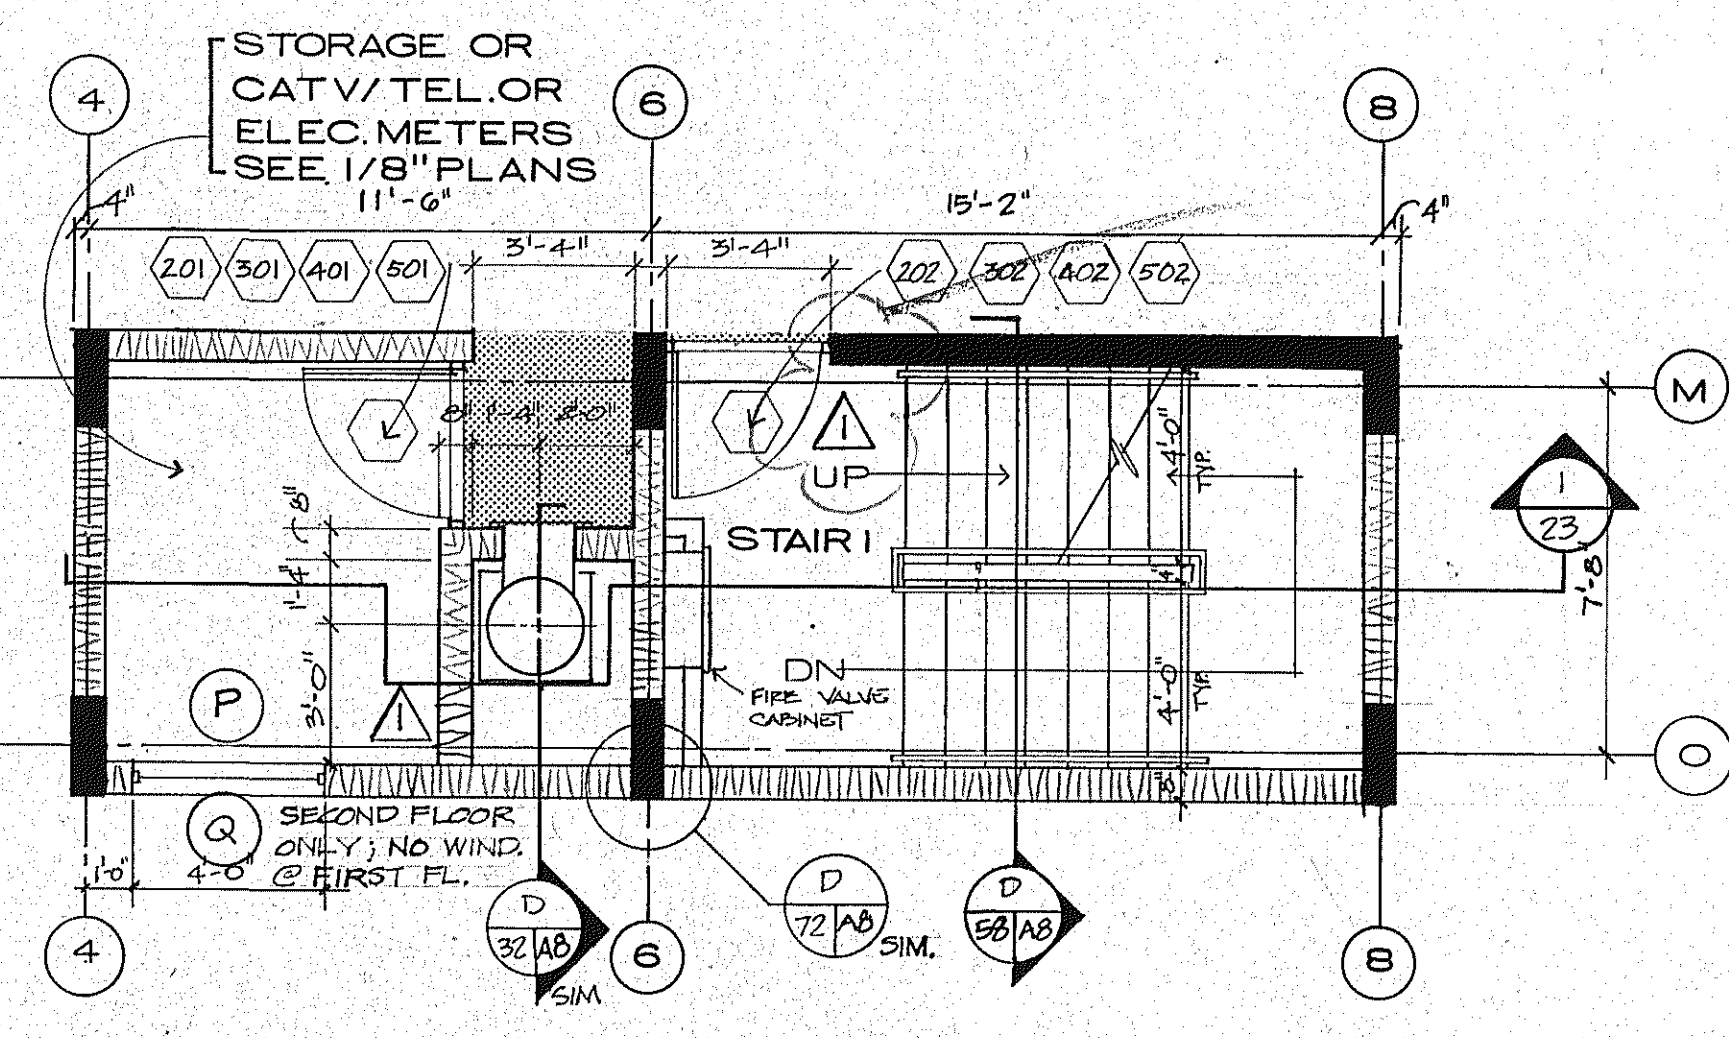

TYPICAL SECOND THRU FIFTH FLOOR PLAN TOWER 1

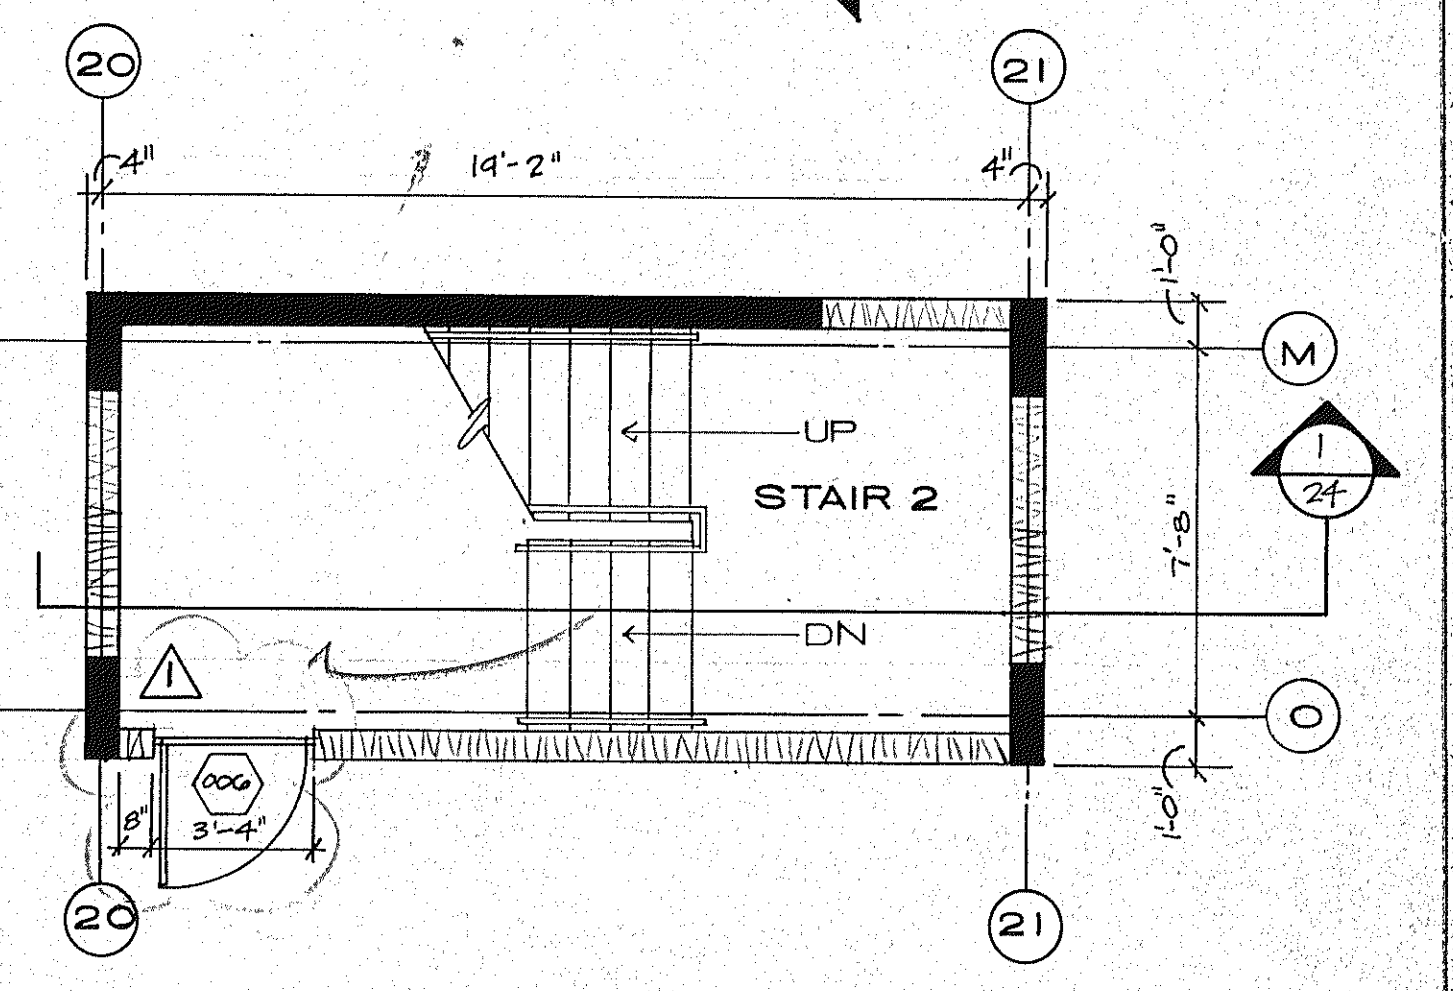

GROUND FLOOR PLAN TOWER 2

**SUNSET BEACH**  
 CONSULTING ENGINEERS & SURVEYORS  
 BENNETT & BISHOP INC.  
 BUILDING 3 STAIR TOWERS 1/4" = 1'-0"  
 ARVADA CORPORATION EDWARD J. SEBERT AIA ARCHITECT & PLANNER P.A. THE SWA GROUP  
 BRABHAM KURNS DEBAY CONSULTING ENGINEERS OLSEN WHITE & ASSOCIATES STRUCTURAL ENGINEERS

ISSUED	10 DEC 82
REVISED	4-1-83
SHEET	A-8
OF	37