NOTE:
BALCONY DEPTHS DIFFER FROM THIS DRAWING ON FLOORS 4 & 5. SEE 1/8" BLDG. PLANS.
END WALLS OCCUR ON BALCONIES @ FLOORS 3, 4, & 5. SEE 1/8" BLDG. PLANS.

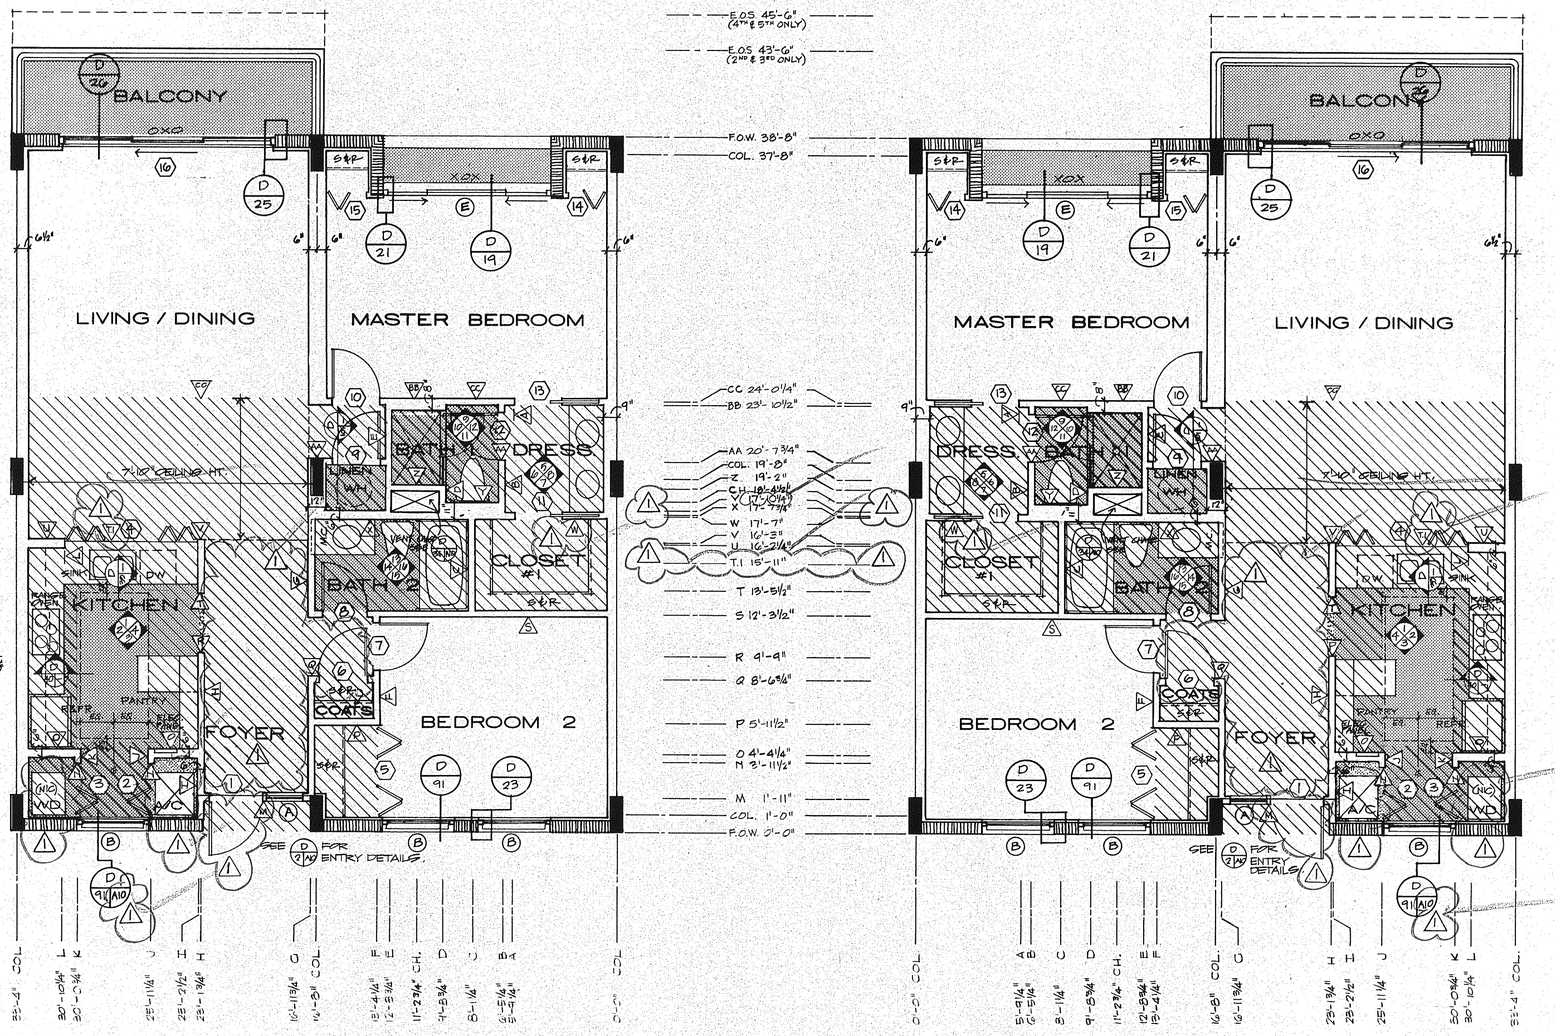

UNIT A LEFT

UNIT A RIGHT

NOTES

1. SEE 1/8" BLDG. PLANS FOR COL. & SHEAR WALL LOCATIONS.
2. ALL DROPPED CEILINGS ARE 7'-0" UNLESS OTHERWISE NOTED.
3. ALL DIMENSIONS ARE FROM CENTERLINE OF WALL.
4. SEE DETAIL BOOKLET FOR DOOR, WINDOW & FINISH SCHEDULES
5. SCREEN DOT TEXTURE DENOTES PAVERS, CERAMIC TILE, VINYL TILE & VAT. SEE FINISH SCHEDULES FOR EXACT LOCATIONS
6. VERIFY EXACT LOCATION OF LAVATORIES W/ ARCHITECT
7. SEE SHEET A-9 FOR PLAN DIMENSIONING KEY.

SUNSET BEACH OF LONGBOAT KEY

UNIT A PLANS

1/4" = 1'-0"

ARVIDA CORPORATION · EDWARD J. SEIBERT AIA ARCHITECT & PLANNER PA · THE SWA GROUP
BRASHAM KUHNS DEBAY CONSULTING ENGINEERS · OLSEN WHITE & ASSOCIATES STRUCTURAL ENGINEERS · BENNETT & BISHOP INC CONSULTING ENGINEERS & SURVEYORS

ISSUED
10 DEC. 82

REVISED
1 4-1-83

SHEET
A-10
OF 37