


OVERLAP
COMPOSITE

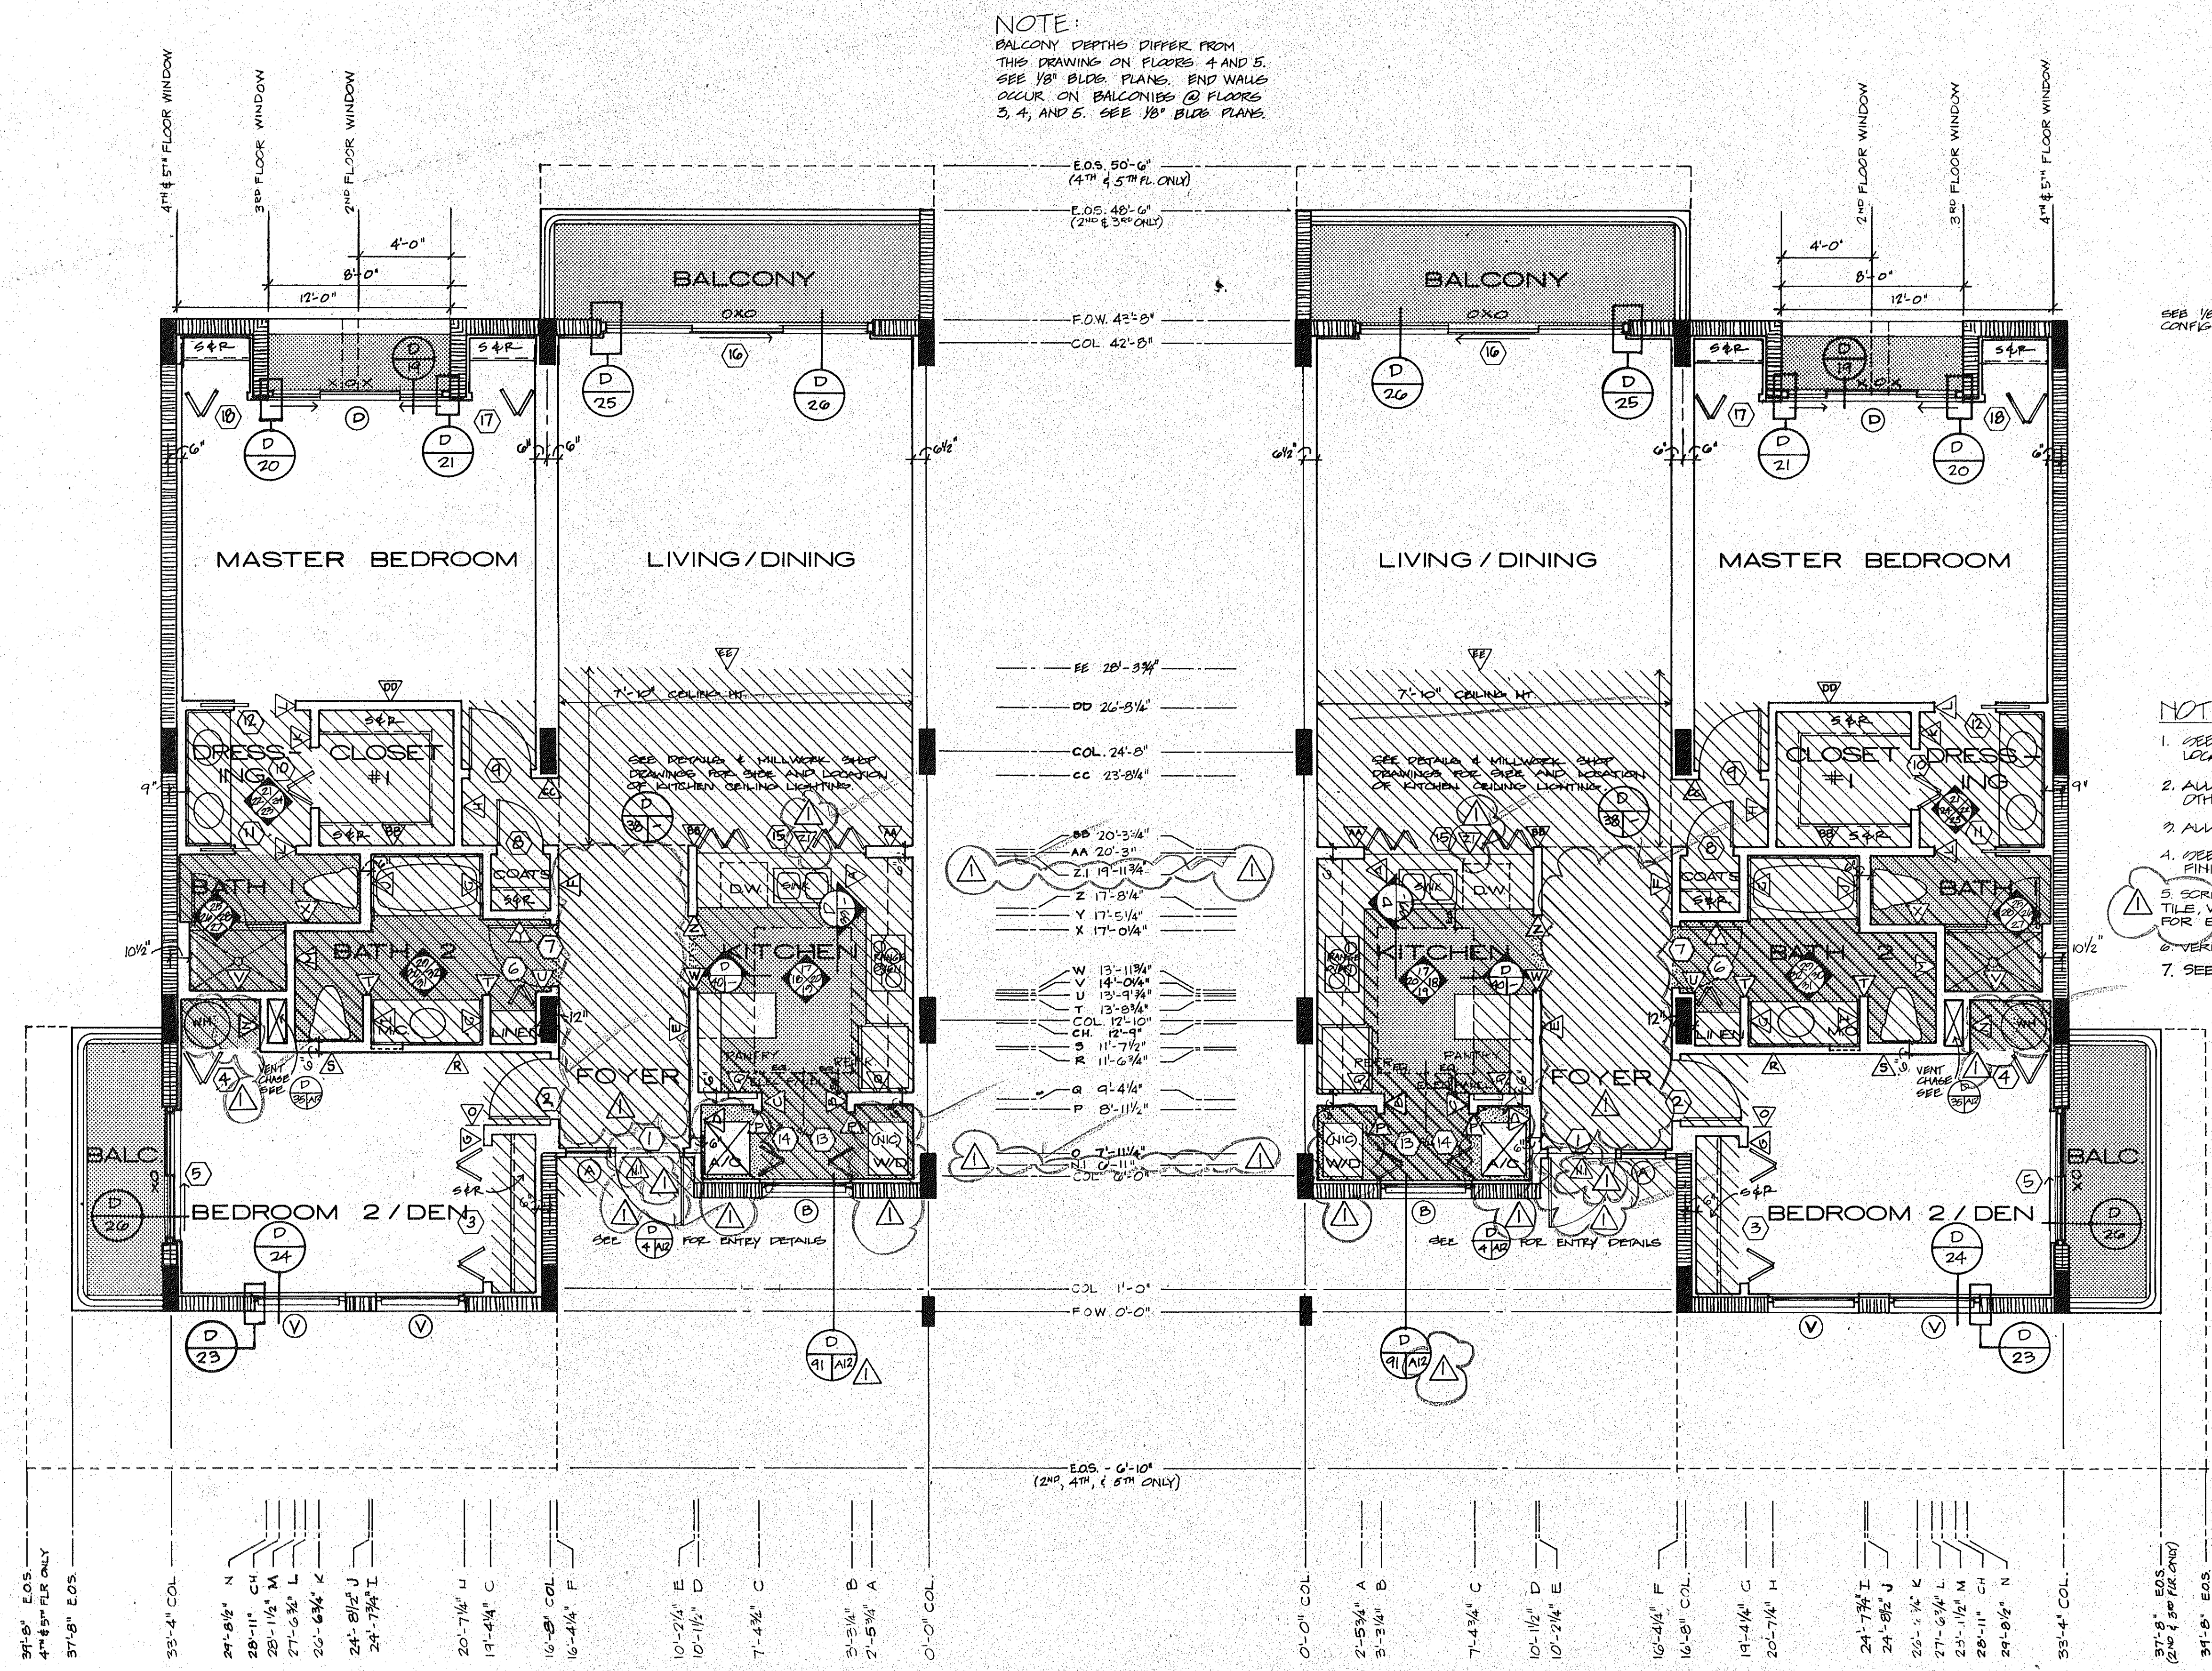

NOTE:
BALCONY DEPTHS DIFFER FROM THIS DRAWING ON FLOORS 4 AND 5. SEE 1/8" BLDG. PLANS. END WALLS OCCUR ON BALCONIES @ FLOORS 3, 4, AND 5. SEE 1/8" BLDG. PLANS.

SEE 1/8" BLDG. PLANS FOR WINDOW CONFIGURATION OF B UNITS.

NOTES:

1. SEE 1/8" BLDG. PLANS FOR COL. & SHEAR WALL LOCATIONS.
2. ALL DROPPED CEILING ARE 7'-0" UNLESS OTHERWISE NOTED.
3. ALL DIMENSIONS ARE FROM CENTERLINE OF WALL.
4. SEE DETAIL BOULET FOR DOOR, WINDOW & FINISH SCHEDULES.
5. SCREEN DOT TEXTURE DENOTES PAVERS. SEE TILE VINYL TILE & VAT. SEE FINISH SCHEDULES FOR EXACT LOCATION.
6. VERIFY EXACT LOCATION OF LANS. W/ ARCH.
7. SEE SHEET A-9 FOR PLAN DIMENSIONING KEY.

UNIT B LEFT

UNIT B RIGHT

37'-8" E.O.S.
4" & 5" FLR ONLY
37'-8" E.O.S.

- 33'-4" COL
- 24'-8 1/2" J
- 24'-7 7/8" I
- 20'-7 1/2" H
- 19'-4 1/4" C
- 16'-8" COL
- 16'-4 1/4" F
- 10'-2 1/4" E
- 10'-1 1/2" D
- 7'-4 3/4" C
- 3'-5 1/4" B
- 2'-5 3/4" A
- 0'-0" COL

E.O.S. 6'-10"
(2ND, 4TH, & 5TH ONLY)

- 0'-0" COL
- 2'-5 3/4" A
- 3'-3 1/4" B
- 7'-4 3/4" C
- 10'-1 1/2" D
- 10'-2 1/4" E
- 16'-4 1/4" F
- 16'-8" COL
- 19'-4 1/4" G
- 20'-7 1/4" H
- 24'-7 7/8" I
- 24'-8 1/2" J
- 26'-1 1/2" K
- 27'-6 3/4" L
- 25'-1 1/2" M
- 28'-11" CH
- 29'-8 1/2" N
- 33'-4" COL

37'-8" E.O.S.
(2ND & 5TH FLR ONLY)
37'-8" E.O.S.
4" & 5" FLR ONLY