


NOTE:  
BALCONY DEPTHS DIFFER FROM THIS DRAWING ON 4TH FLOOR. SEE 10" BLDG PLANS. END WALLS OCCUR ON 4TH FLOOR BALCONY. SEE 10" BLDG PLANS.

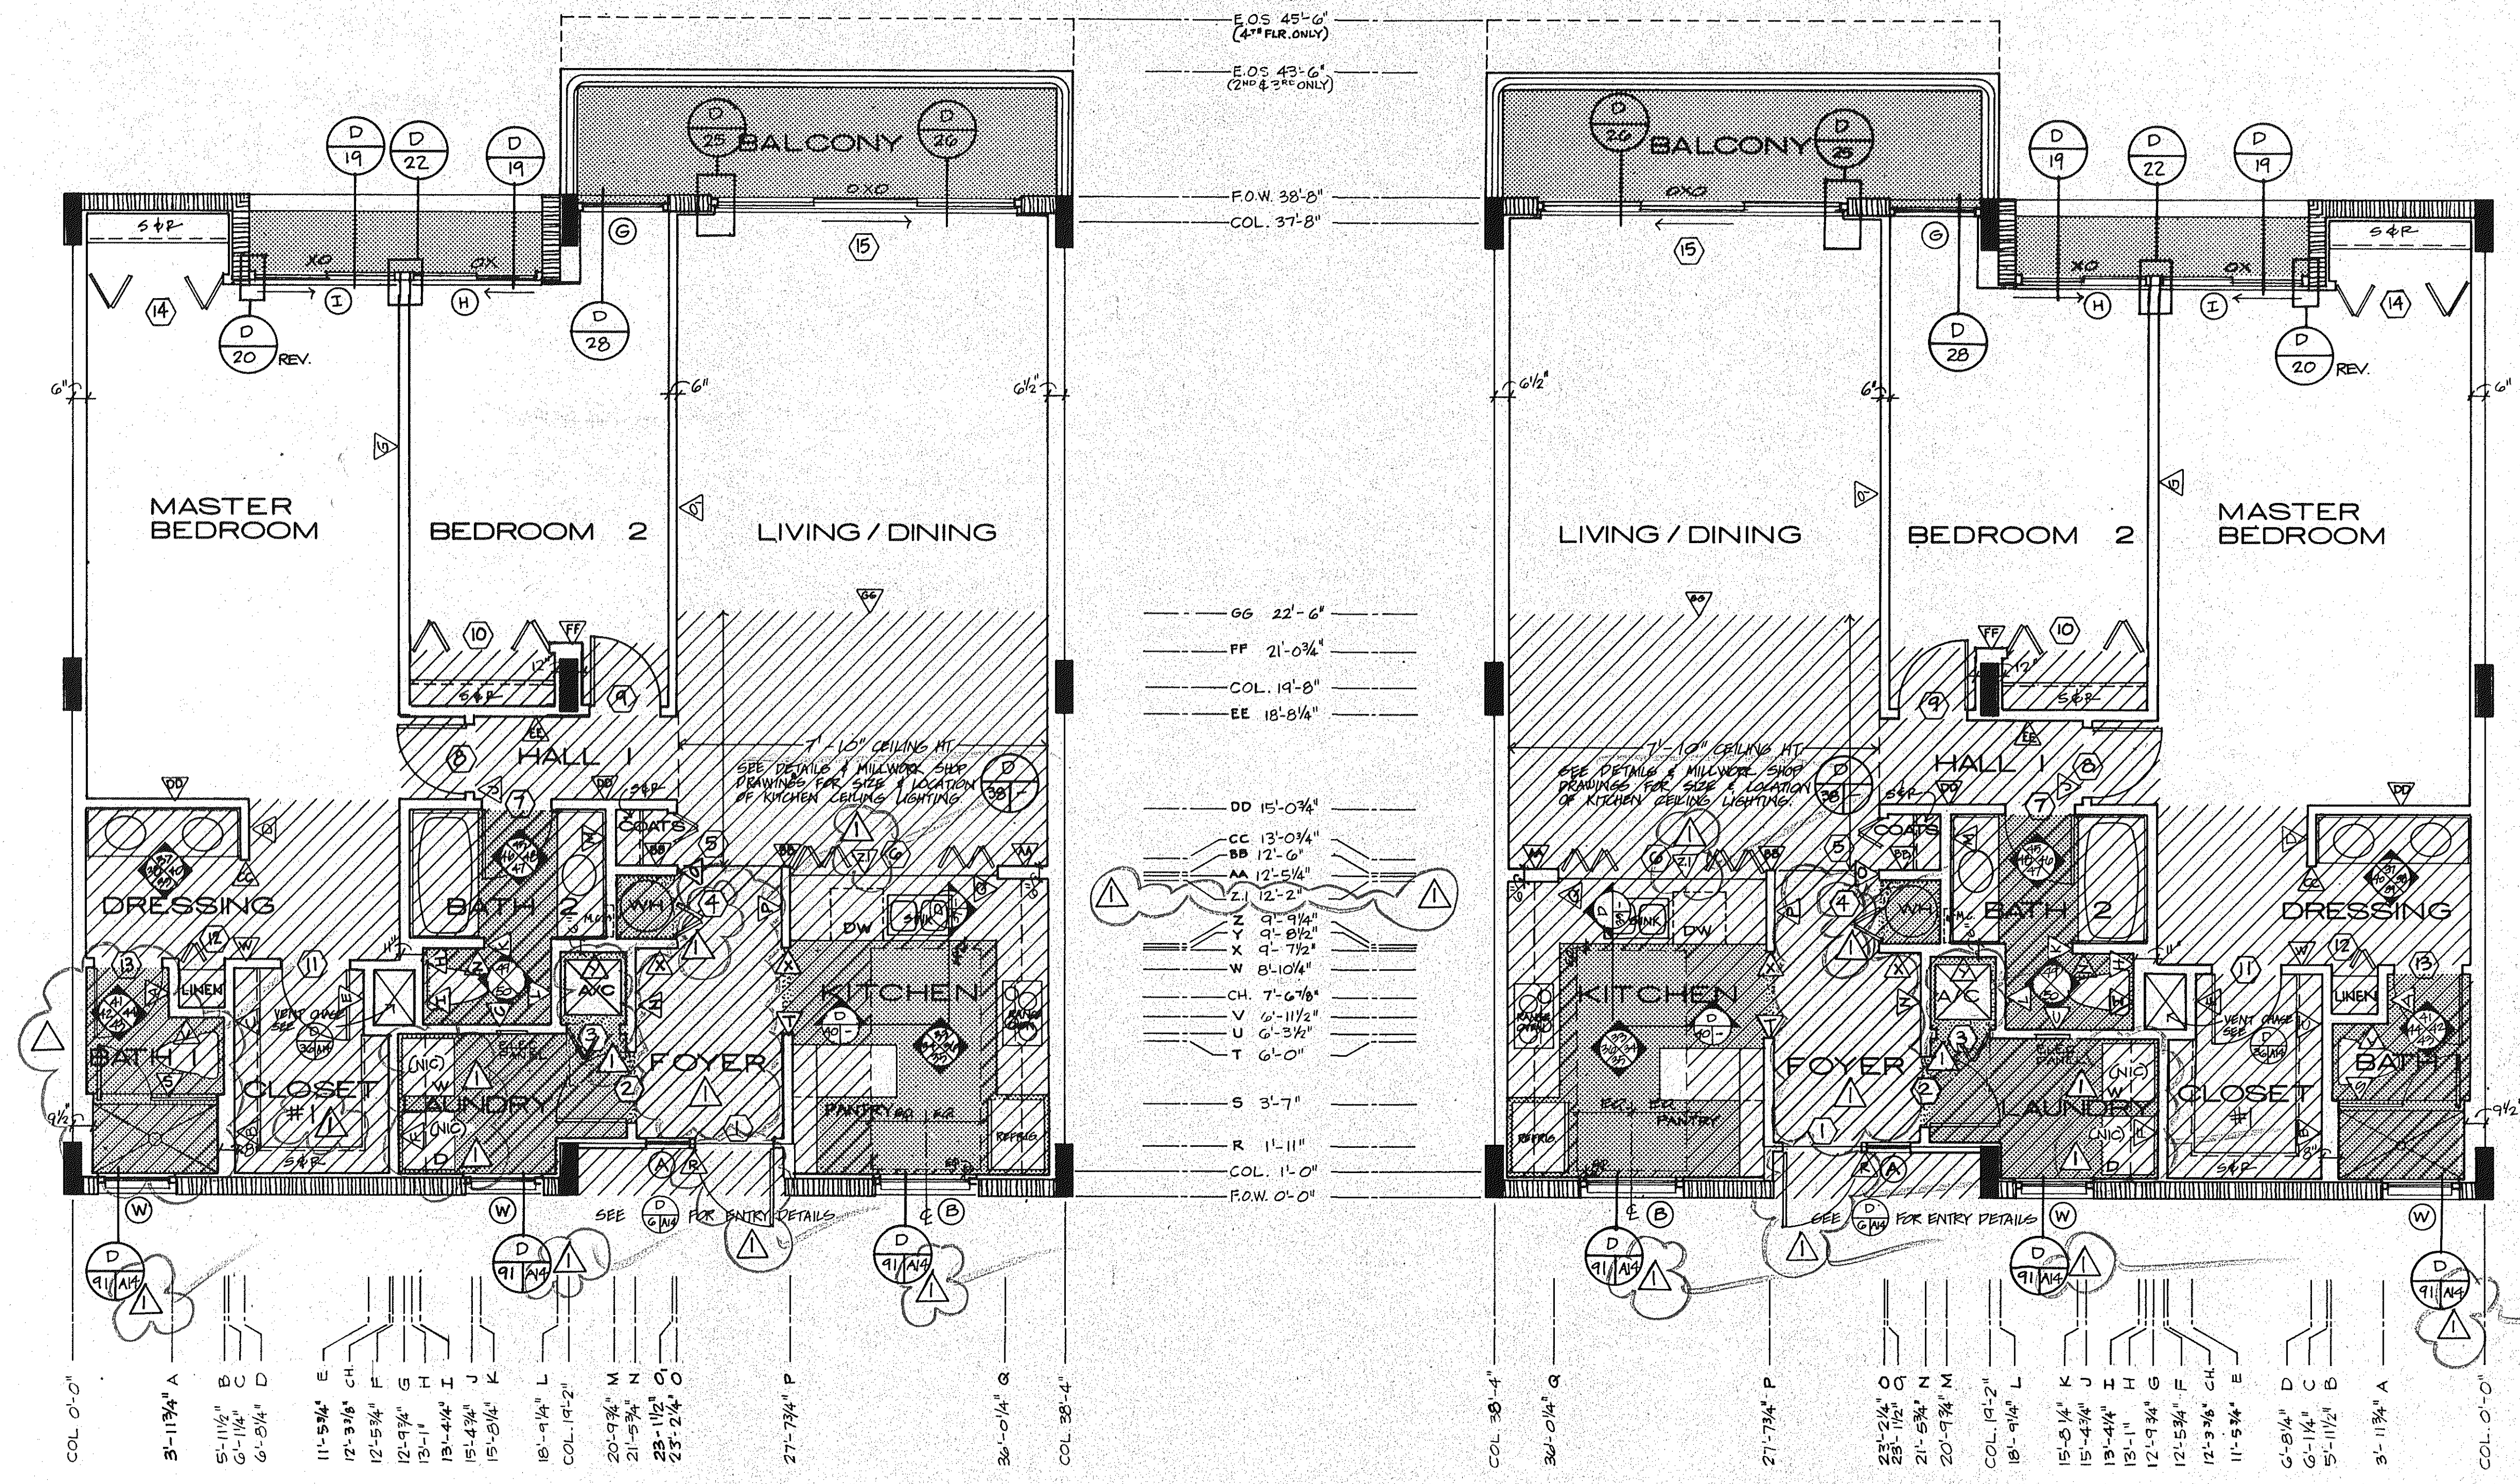

UNIT C LEFT

UNIT C RIGHT

- NOTES:
1. SEE 10" BLDG PLANS FOR COL. & SHEAR WALL LOCATIONS.
  2. ALL DROPPED CEILINGS ARE 7'-0" UNLESS OTHERWISE NOTED.
  3. ALL DIMENSIONS ARE FROM CENTERLINE OF WALL.
  4. SEE DETAIL BOOKLET FOR FLOOR, WINDOW & FINISH SCHEDULES.
  5. SCREEN DOT TEXTURE DENOTES PAINTS, CER. TILE, VINYL TILE OR VAT. SEE FINISH SCHEDULES FOR EXACT LOCATIONS.
  6. VERIFY EXACT LOCATION OF LAWS W/ ARCHITECT.
  7. DASHED LINE ABOVE THE WASHER/DRYER IS A CONTINUOUS UPPER CABINET W/ DOORS. CONSTRUCTION IS TO BE PER KITCHEN UPPER CABINETS EXCEPT DELETE ALL WOOD TRIM. PULLS TO BE RECESSED OAK.
  8. SEE SHEET A-9 FOR PLAN DIMENSIONING KEY.