NOTES:

1. SEE 1/8" BLDG. PLANS FOR COL. & SHEAR WALL LOCATIONS.
2. ALL DROPPED CLGS. ARE 7'-0" UNLESS OTHERWISE NOTED.
3. ALL DIMENSIONS ARE FROM CENTERLINE OF WALL.
4. SEE DETAIL BOOKLET FOR DOOR, WINDOW & FINISH SCHEDULES.
5. SCREEN DOT TEXTURE DENOTES PAVERS, CER. TILE, VINYL TILE OR VAT. SEE FINISH SCHEDULE FOR EXACT LOCATION.
6. VERIFY EXACT LOCATION OF LAVS. W/ ARCHITECT.
7. DASHED LINE ABOVE THE WASHER/DRYER IS A CONTINUOUS UPPER CABINET W/ DOORS. CONSTRUCTION IS TO BE PER KITCHEN UPPER CABINETS EXCEPT DELETE ALL WOOD TRIM. PULLS TO BE RECESSED OAK.
8. SEE SHEET A-9 FOR PLAN DIMENSIONING KEY.

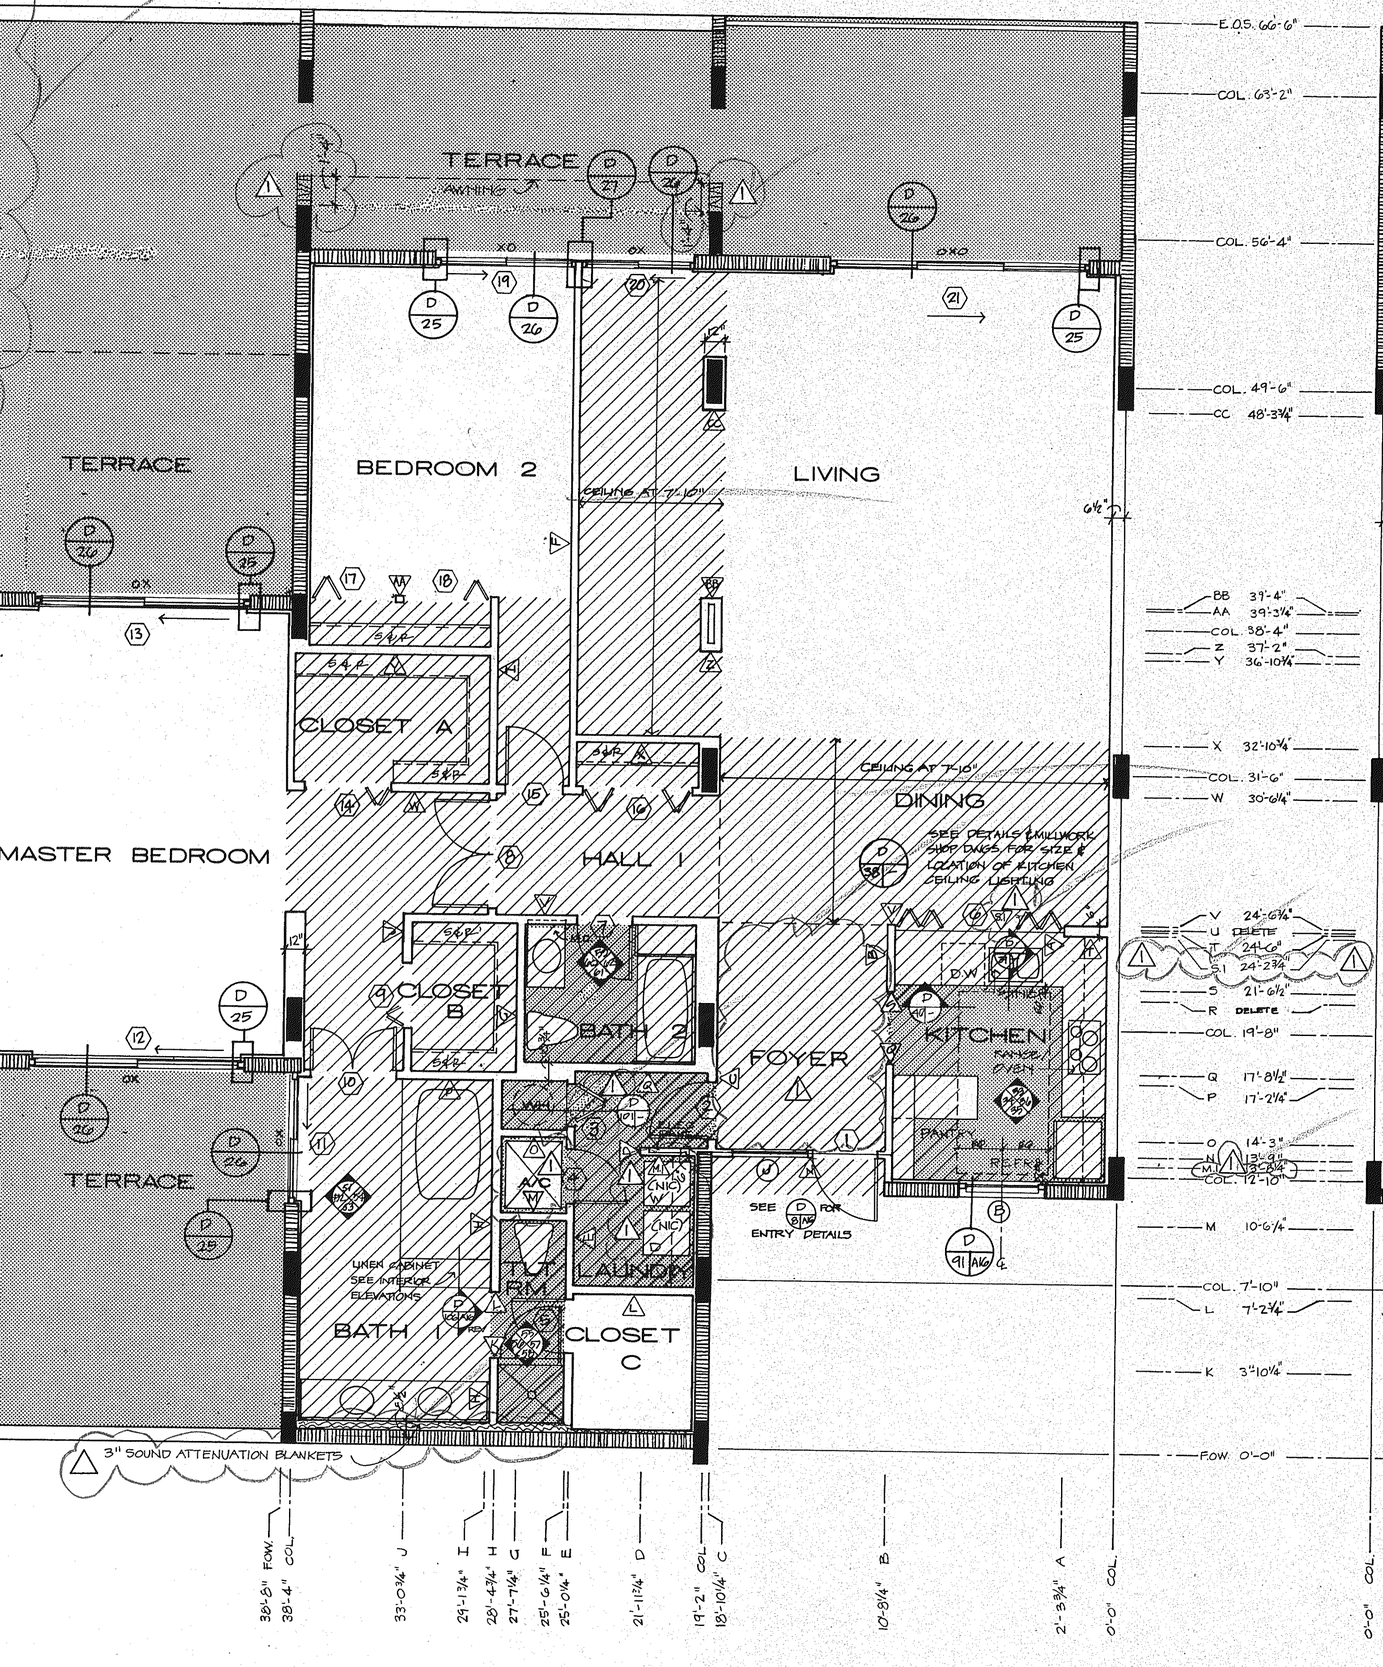

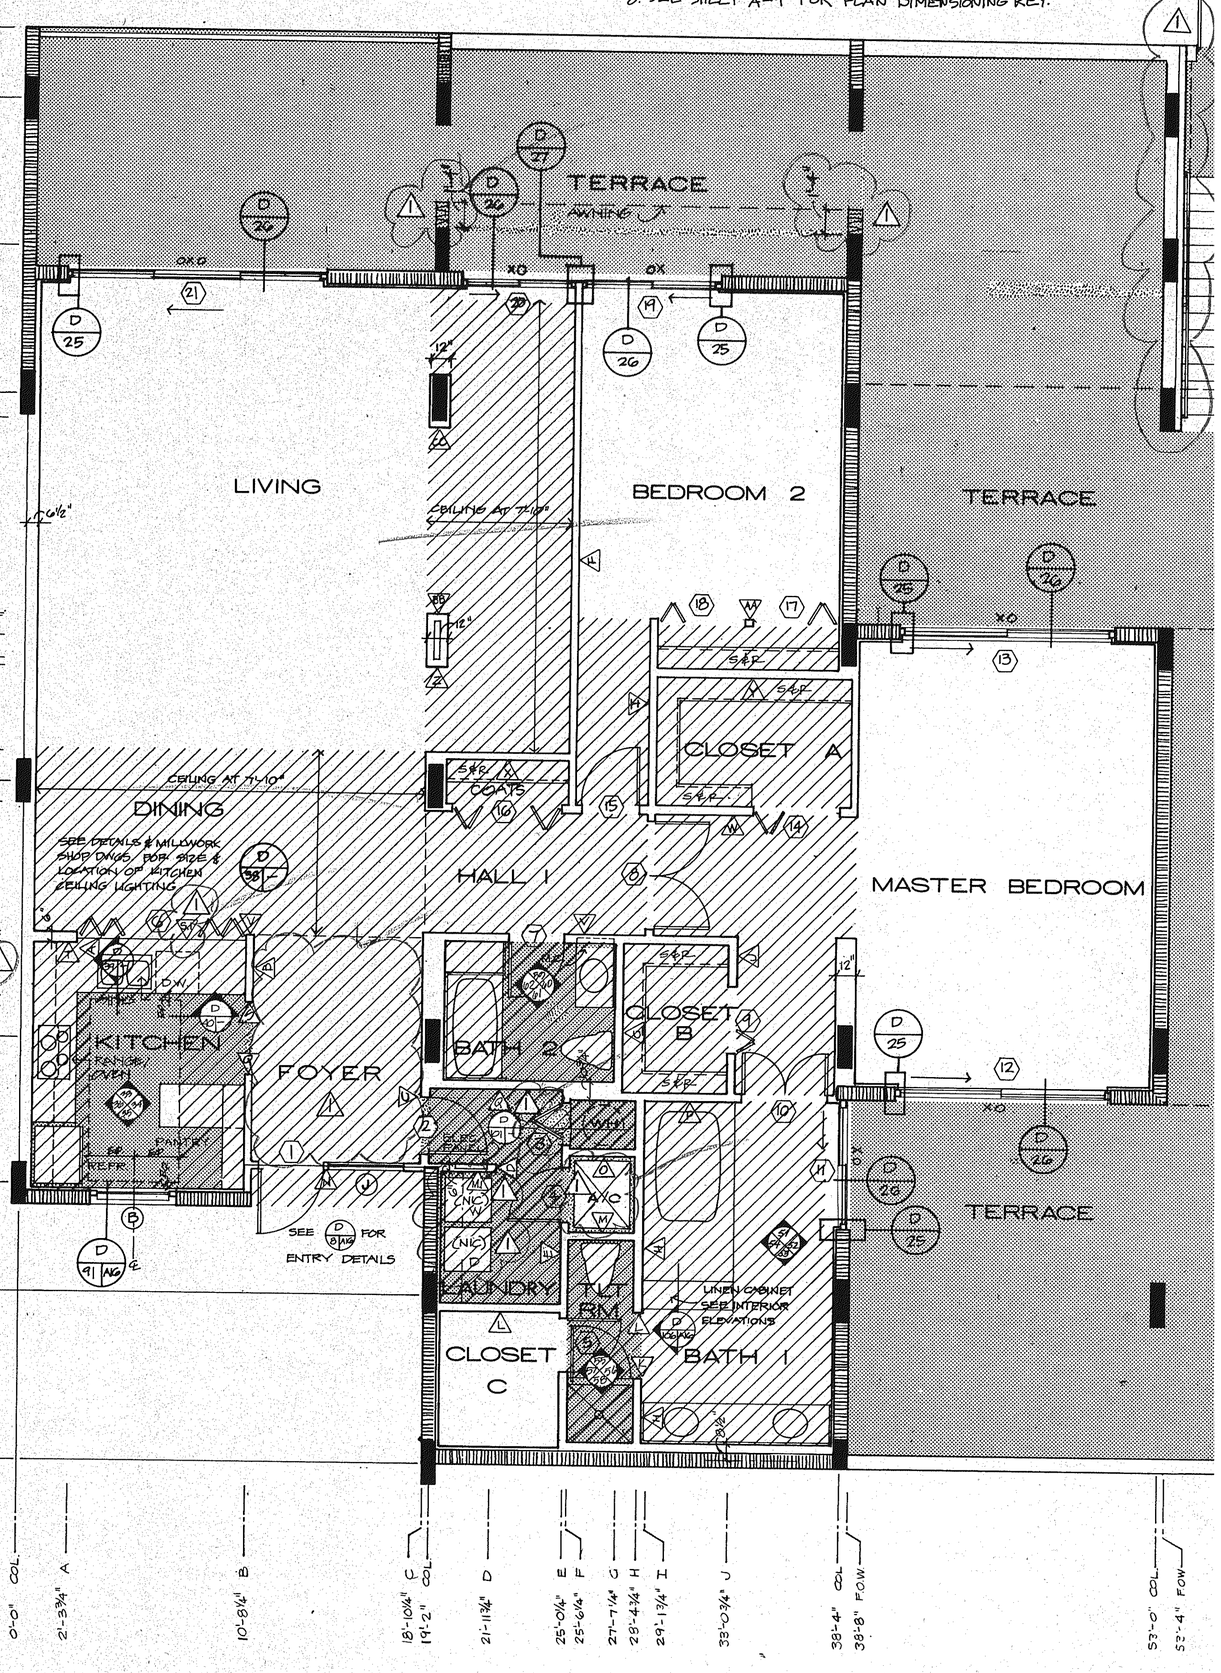

38'-8" F.O.W. | 38'-4" COL. | 33'-0¾" J | 29'-1¾" I | 28'-4¾" H | 27'-7¼" G | 25'-6¼" F | 25'-0¼" E | 21'-11¾" D | 19'-2" COL. | 18'-10¼" C | 10'-8¼" B | 2'-3¾" A | 0'-0" COL.

0'-0" COL. | 2'-3¾" A | 10'-8¼" B | 18'-10¼" C | 19'-2" COL. | 21'-11¾" D | 25'-0¼" E | 25'-6¼" F | 27'-7¼" G | 28'-4¾" H | 29'-1¾" I | 33'-0¾" J | 38'-4" COL. | 38'-8" F.O.W. | 53'-0" COL. | 53'-4" F.O.W.

UNIT D+ LEFT

UNIT D+ RIGHT