


NOTE:
BALCONY DEPTHS DIFFER FROM THIS DRAWING ON 4TH FLOOR. SEE 1/8" BLDG PLANS. END WALLS OCCUR ON 4TH FLOOR BALCONIES. SEE 1/8" BLDG PLANS.

BALCONY @ 2ND FLR ONLY
SEE 1/8" BLDG PLANS

BALCONY @ 2ND FLR ONLY
SEE 1/8" BLDG PLANS

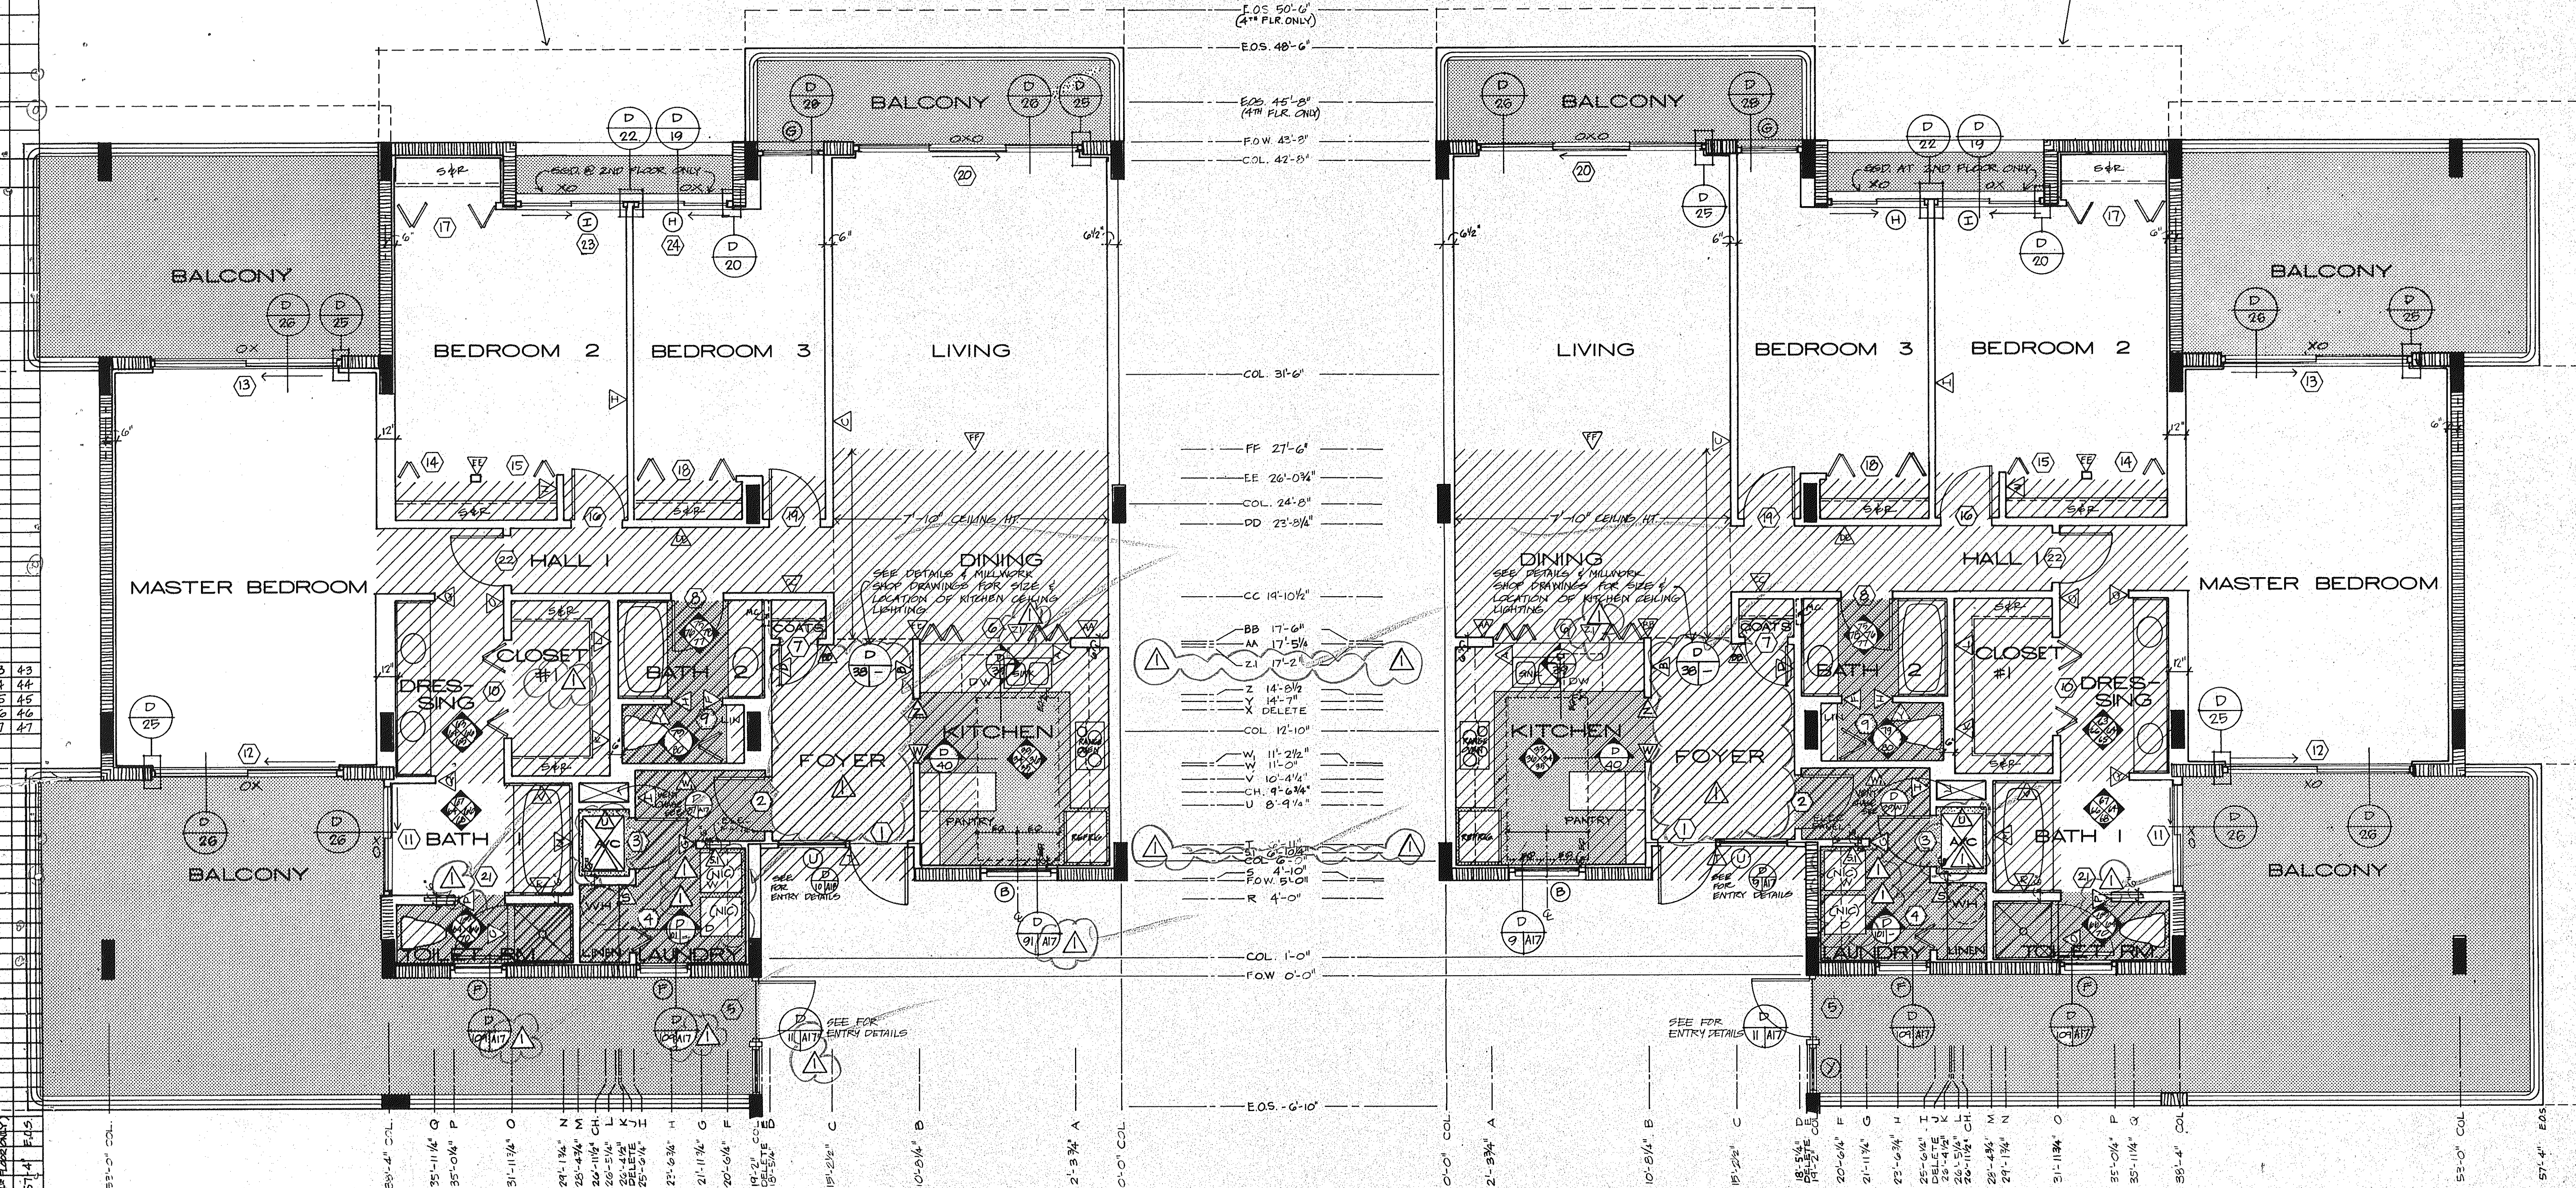

UNIT D LEFT

UNIT D RIGHT

- NOTES:
- SEE 1/8" BLDG PLANS FOR COLUMN & SHEAR WALL LOCATIONS
 - ALL DROPPED CEILINGS ARE 7'-0" UNLESS OTHERWISE NOTED
 - ALL DIMENSIONS ARE FROM CENTERLINE OF WALL
 - SEE DETAIL BOOKLET FOR DOOR, WINDOW, FINISH SCHEDULES
 - SCREEN DOT TEXTURE DENOTES PAPER, CERAMIC TILE, VINYL TILE OR SEE FINISH SCHEDULES FOR EXACT LOCATIONS
 - VERIFY EXACT LOCATION OF LAYS W/ ARCHITECT
 - DASHED LINE ABOVE THE WASHER/DRYER IS A CONTINUOUS UPPER CABINET W/ DOORS. CONSTRUCTION IS TO BE PER KITCHEN UPPER CABINETS EXCEPT DELETE ALL WOOD TRIM. PULLS TO BE RECESSED OAK.
 - SEE SHEET A-9 FOR PLAN DIMENSIONING KEY.

3 43
4 44
5 45
6 46
7 47

39'-0" COL
39'-4" COL
35'-11 1/4" G
35'-0 1/4" P
31'-11 3/4" O
29'-1 3/4" N
28'-4 3/4" M
26'-11 1/2" CH
26'-5 1/4" L
25'-5 1/4" X
23'-9 3/4" H
21'-11 3/4" G
20'-6 1/4" F
19'-2 1/4" COL
15'-5 1/4" B
15'-2 1/2" C
10'-5 1/4" B
2'-9 3/4" A
0'-0" COL
E.O.S. -6'-10"

[.OS 50'-6" (4TH FLR ONLY)
E.O.S. 48'-6"
E.O.S. 45'-0" (4TH FLR ONLY)
F.O.W. 42'-0"
COL. 42'-0"
COL. 31'-6"
FF 27'-6"
EE 26'-0 3/4"
COL. 24'-0"
DD 23'-8 1/4"
CC 19'-10 1/2"
BB 17'-6"
AA 17'-5 1/4"
Z 17'-2"
Z 14'-5 1/2"
Y 14'-7"
X DELETE
COL. 12'-10"
W 11'-2 1/2"
V 11'-0"
U 10'-4 1/4"
CH. 9'-6 3/4"
U 8'-9 1/4"
COL. 1'-0"
F.O.W. 0'-0"
E.O.S. -6'-10"

SEE DETAILS & MILLWORK SHOP DRAWINGS FOR SIDE & LOCATION OF KITCHEN CEILING LIGHTING

SEE DETAILS & MILLWORK SHOP DRAWINGS FOR SIDE & LOCATION OF KITCHEN CEILING LIGHTING

SEE FOR ENTRY DETAILS

SEE FOR ENTRY DETAILS