



OVERLAYS
COMPOSITE

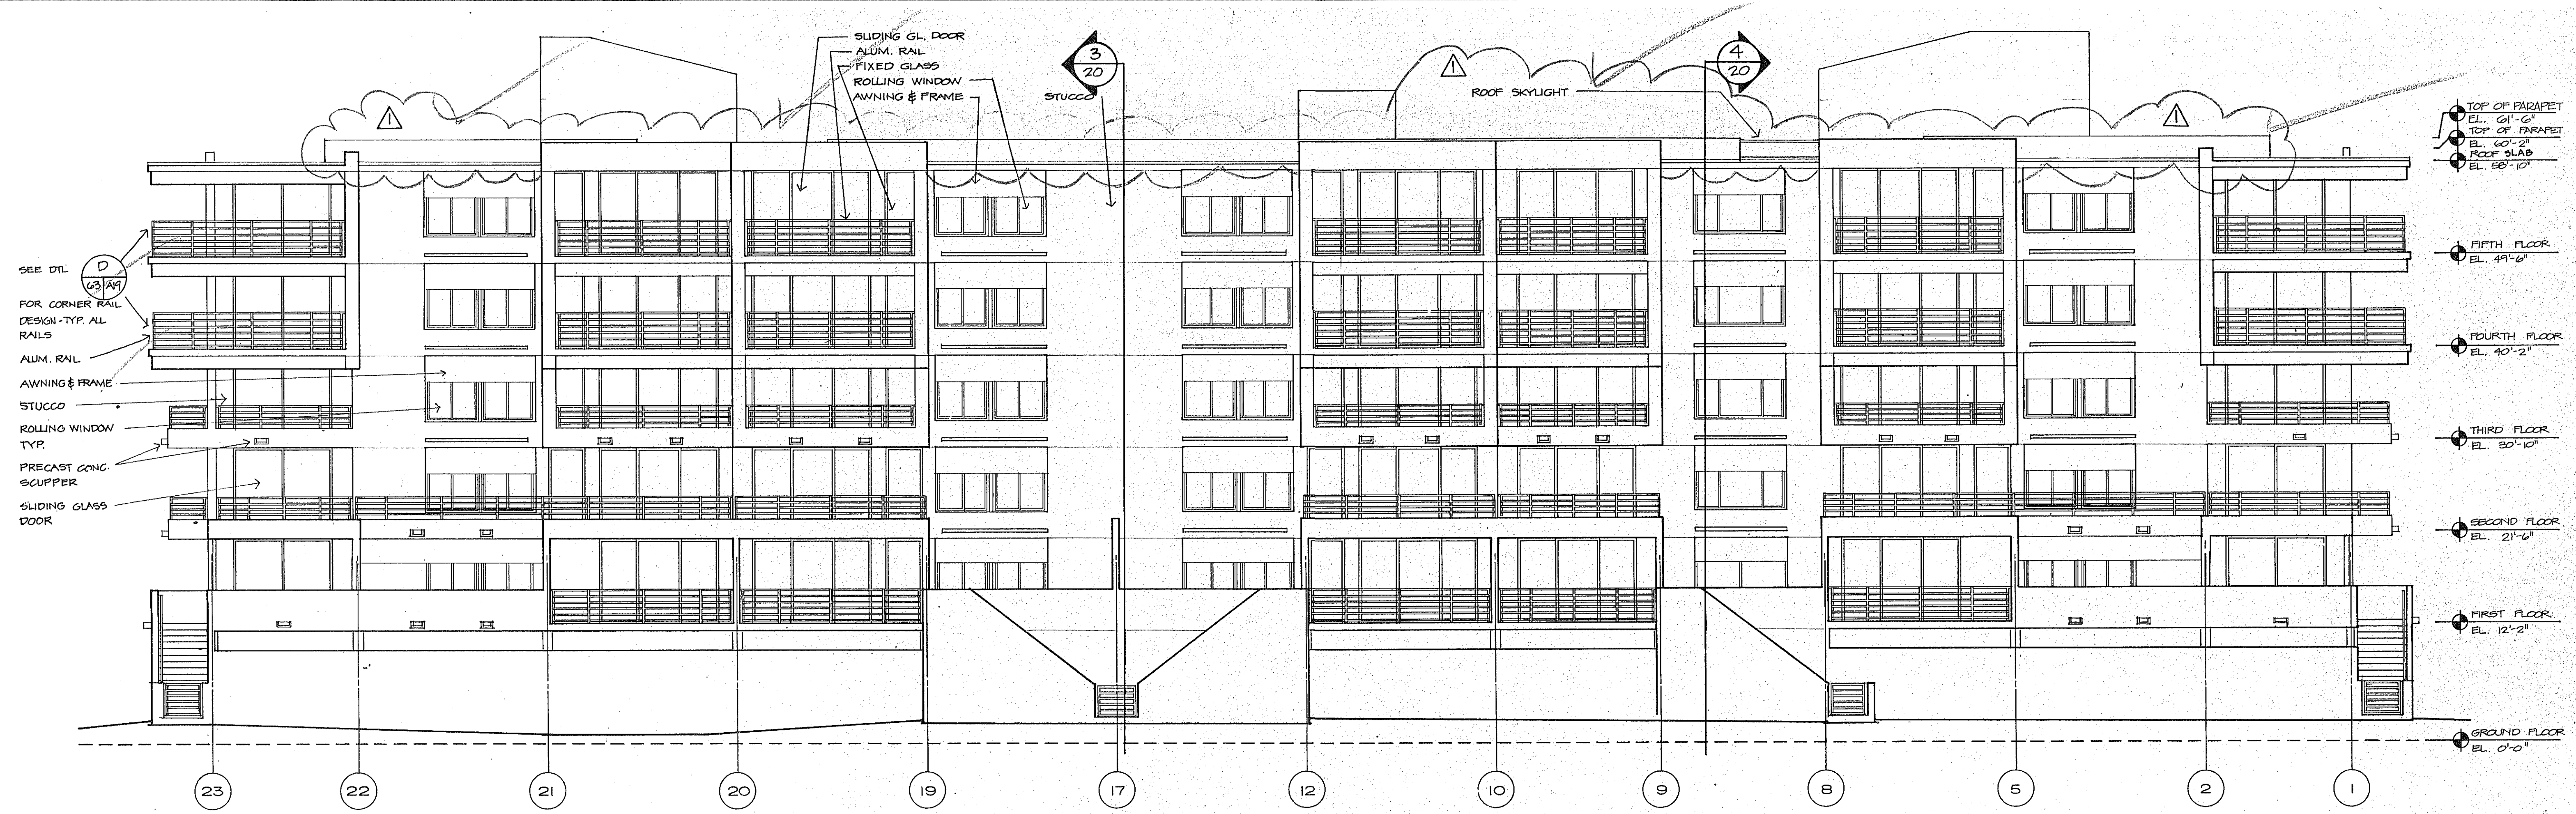

BEACH ELEVATION 1/19

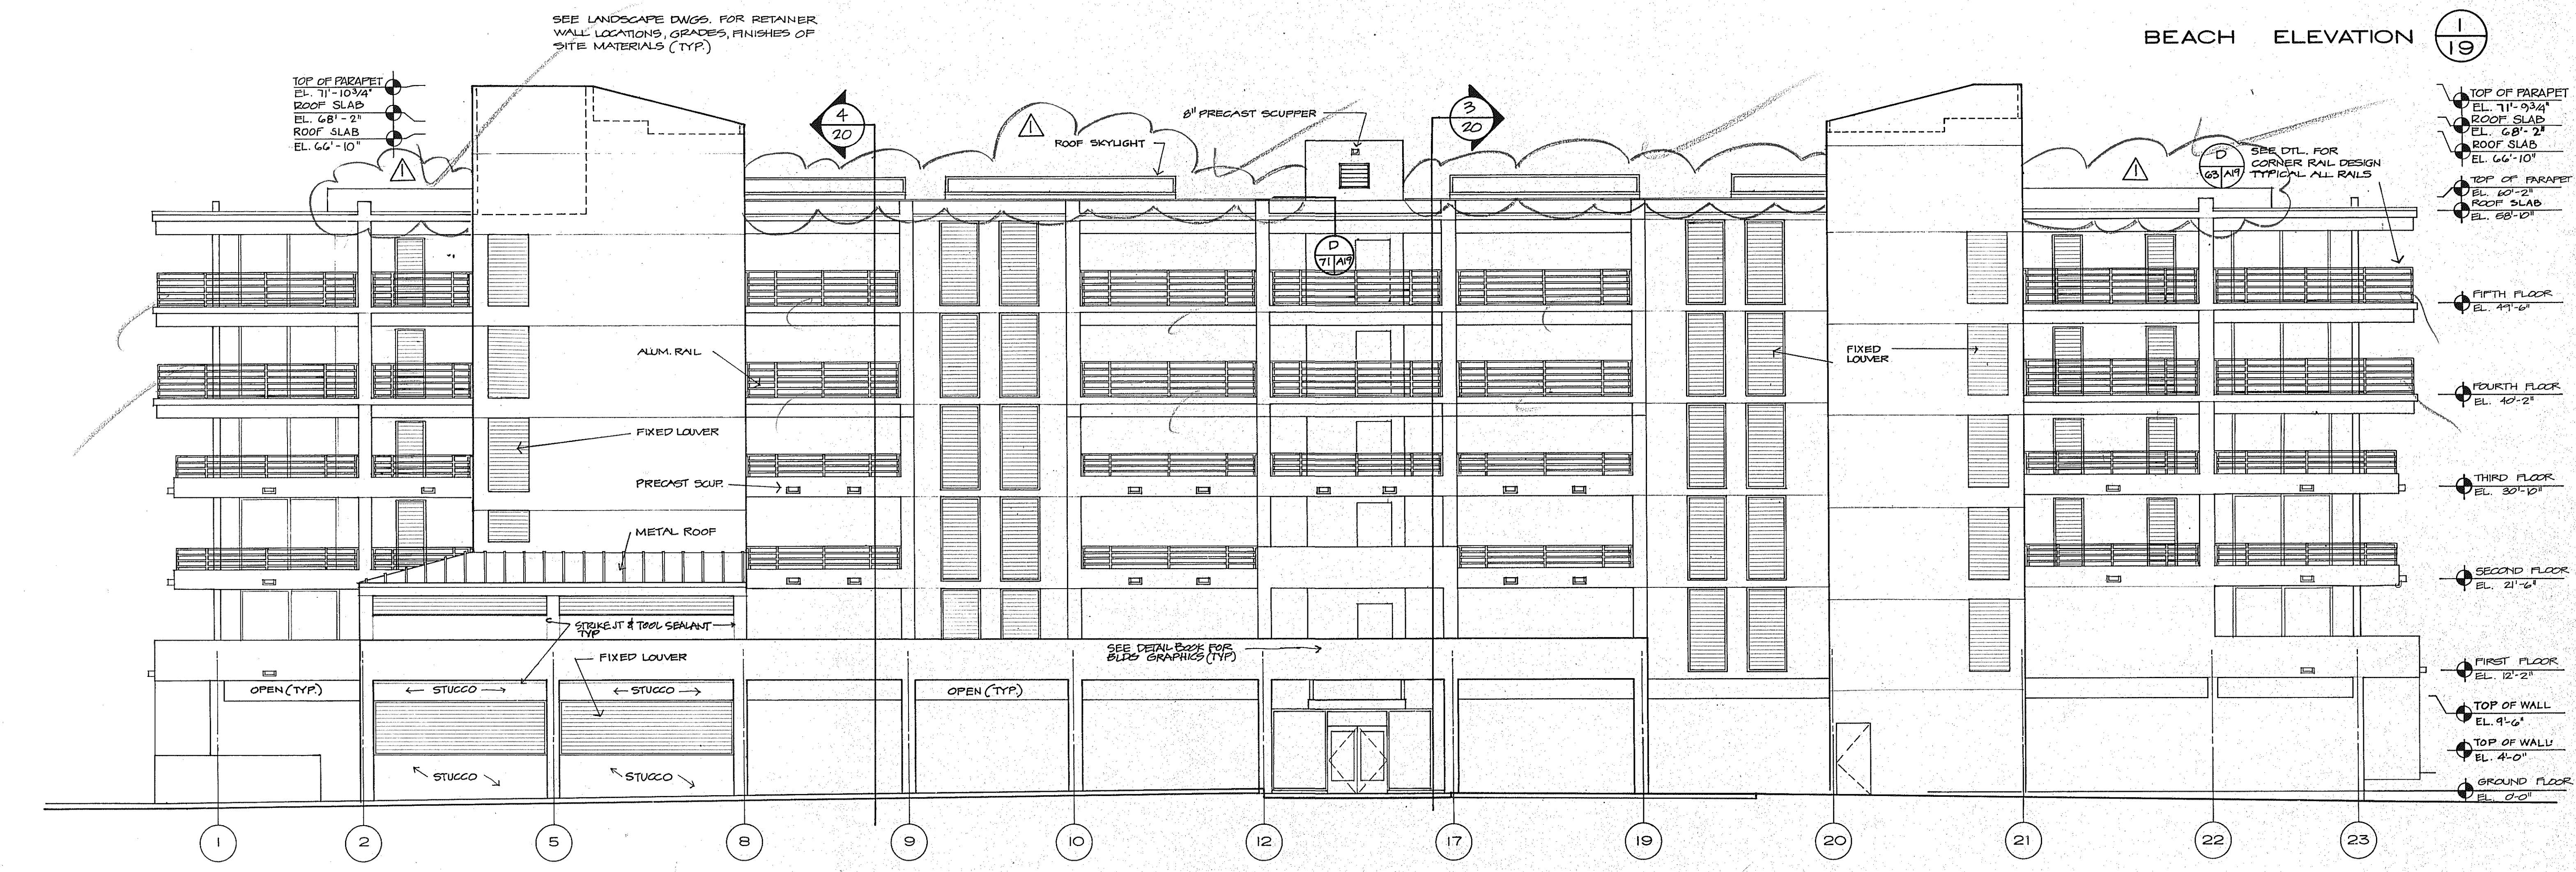

ENTRY ELEVATION 2/19

SUNSET BEACH
 SOF LONG BOAT KEY
 BUILDING 3
 EXTERIOR ELEVATIONS 1/8" = 1'-0"
 ARVIDA CORPORATION · EDWARD J. SEBERT AIA ARCHITECT & PLANNER PA · THE SWA GROUP
 BRABHAM KUHNS DEBAY CONSULTING ENGINEERS · OLSEN WHITE & ASSOCIATES STRUCTURAL ENGINEERS · BENNETT & BISHOP INC CONSULTING ENGINEERS & SURVEYORS
 ISSUED 10 DEC. 82
 REVISED 4-1-83
 SHEET A 19 OF 37