


- TOP OF PARAPET EL. 60'-2"
- ROOF EL. 58'-10"
- FIFTH FLOOR EL. 49'-6"
- FOURTH FLOOR EL. 40'-2"
- THIRD FLOOR EL. 30'-10"
- SECOND FLOOR EL. 21'-6"
- FIRST FLOOR EL. 12'-2"
- GROUND FLOOR EL. 0'-0"

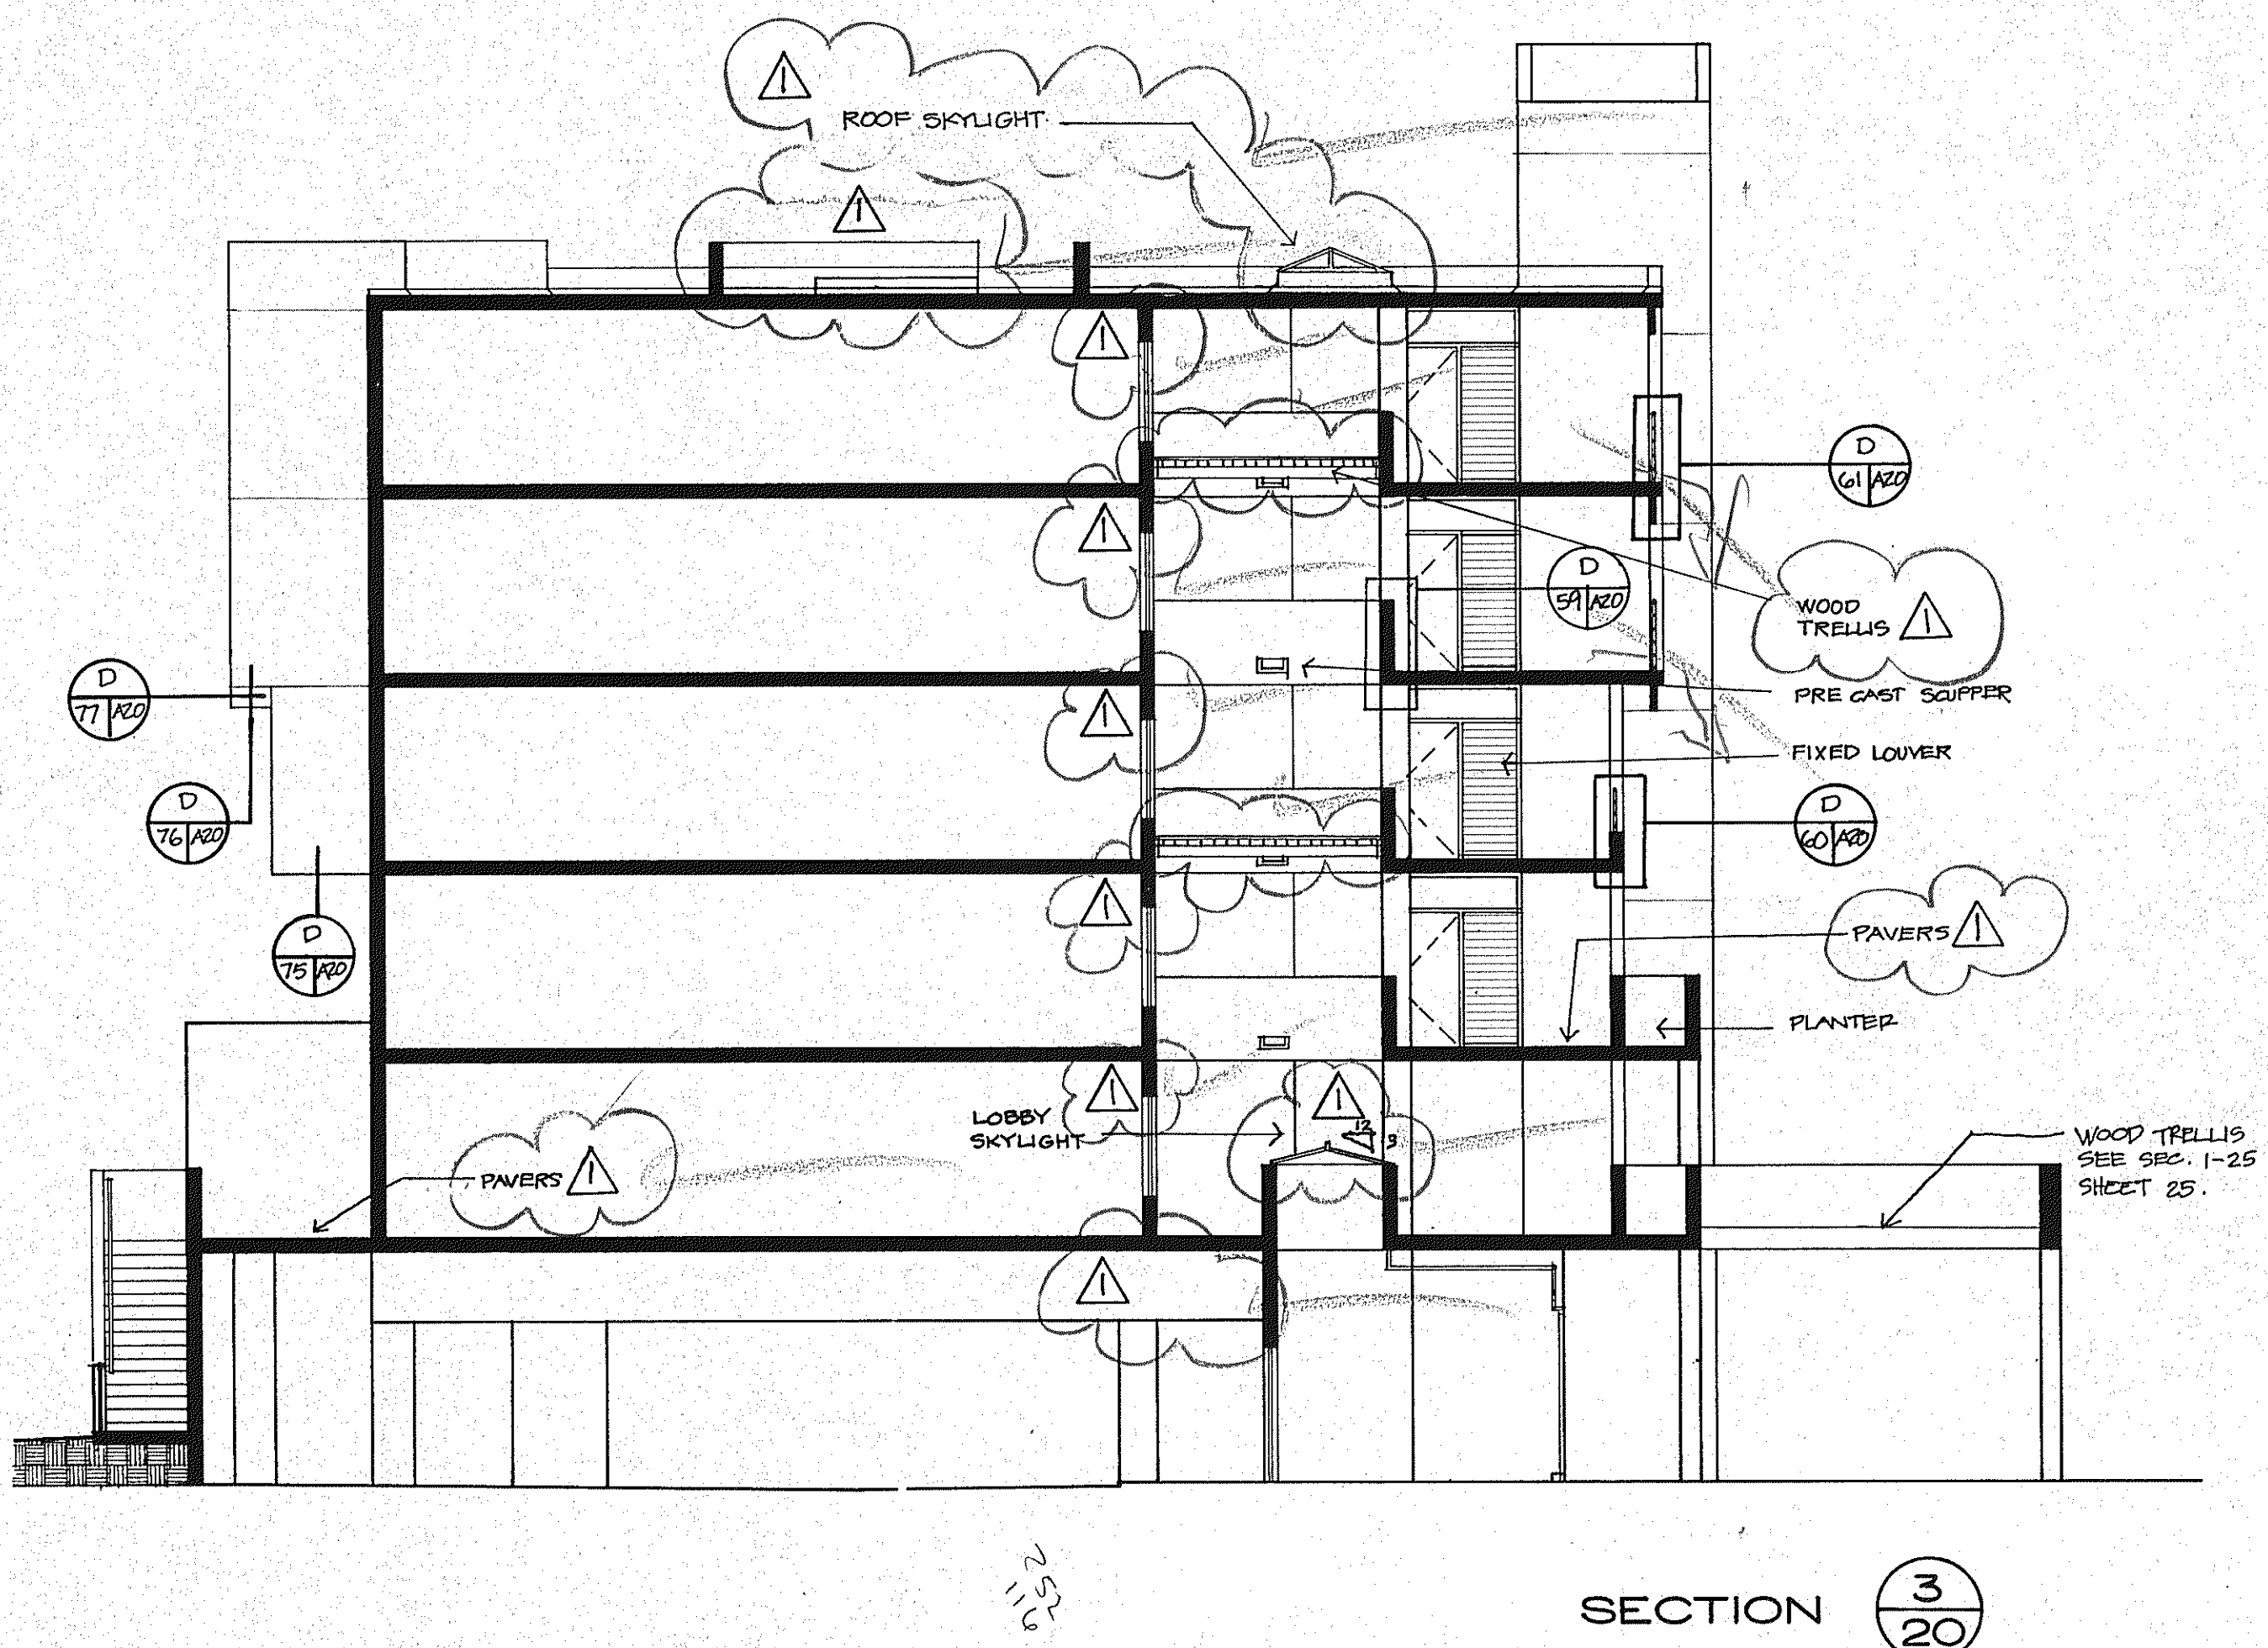

- TOP OF PARAPET EL. 60'-2"
- ROOF EL. 58'-10"
- FIFTH FLOOR EL. 49'-6"
- FOURTH FLOOR EL. 40'-2"
- THIRD FLOOR EL. 30'-10"
- SECOND FLOOR EL. 21'-6"
- FIRST FLOOR EL. 12'-2"
- GROUND FLOOR EL. 0'-0"

