


SECTION 1/22

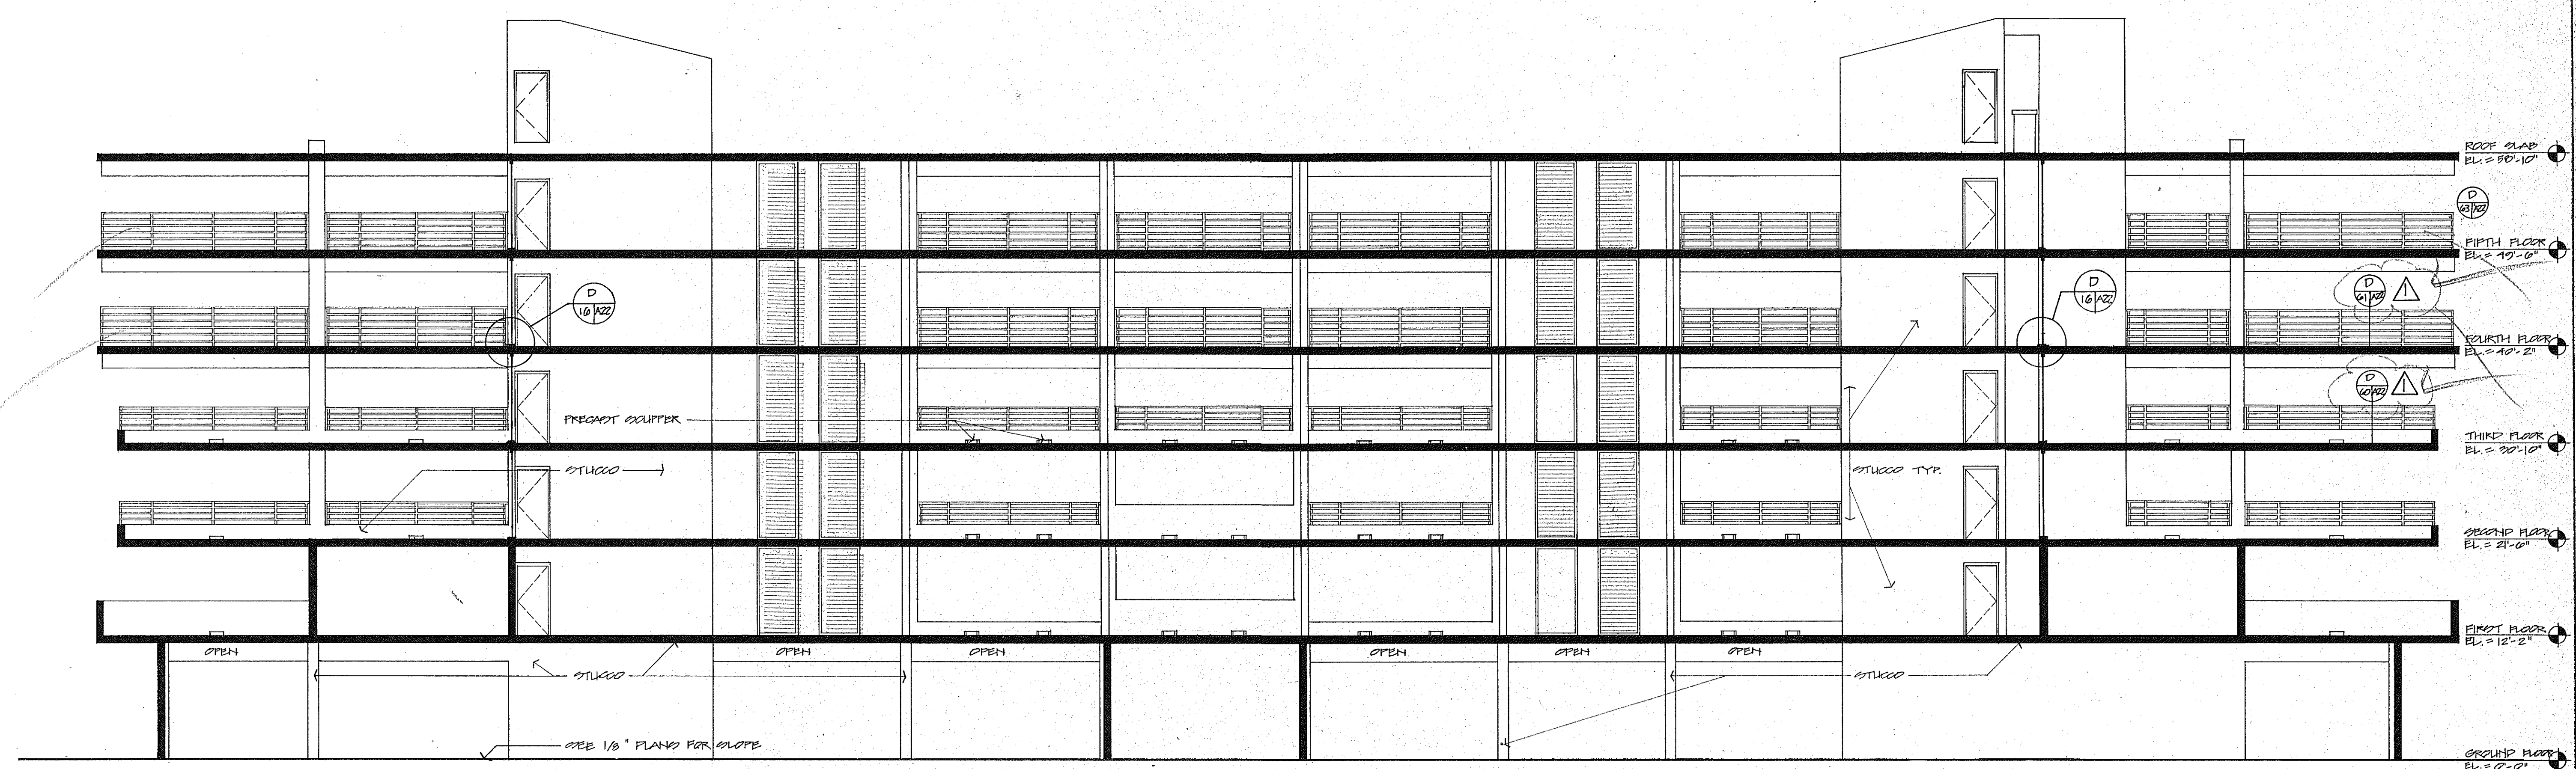

SECTION 2/22

SUNSET BEACH
 LONG BOAT KEY
BUILDING 3 BUILDING SECTIONS 1/8" = 1'-0"
 ARVDA CORPORATION EDWARD J. SEBERT AIA ARCHITECT & PLANNER PA THE SWA GROUP
 BRABHAM KUHNS DEBAY CONSULTING ENGINEERS OLSEN WHITE & ASSOCIATES STRUCTURAL ENGINEERS BENNETT & BISHOP INC. CONSULTING ENGINEERS & SURVEYORS
 ISSUED 10 DEC. 82
 REVISED 4-1-83
 SHEET A 22 OF