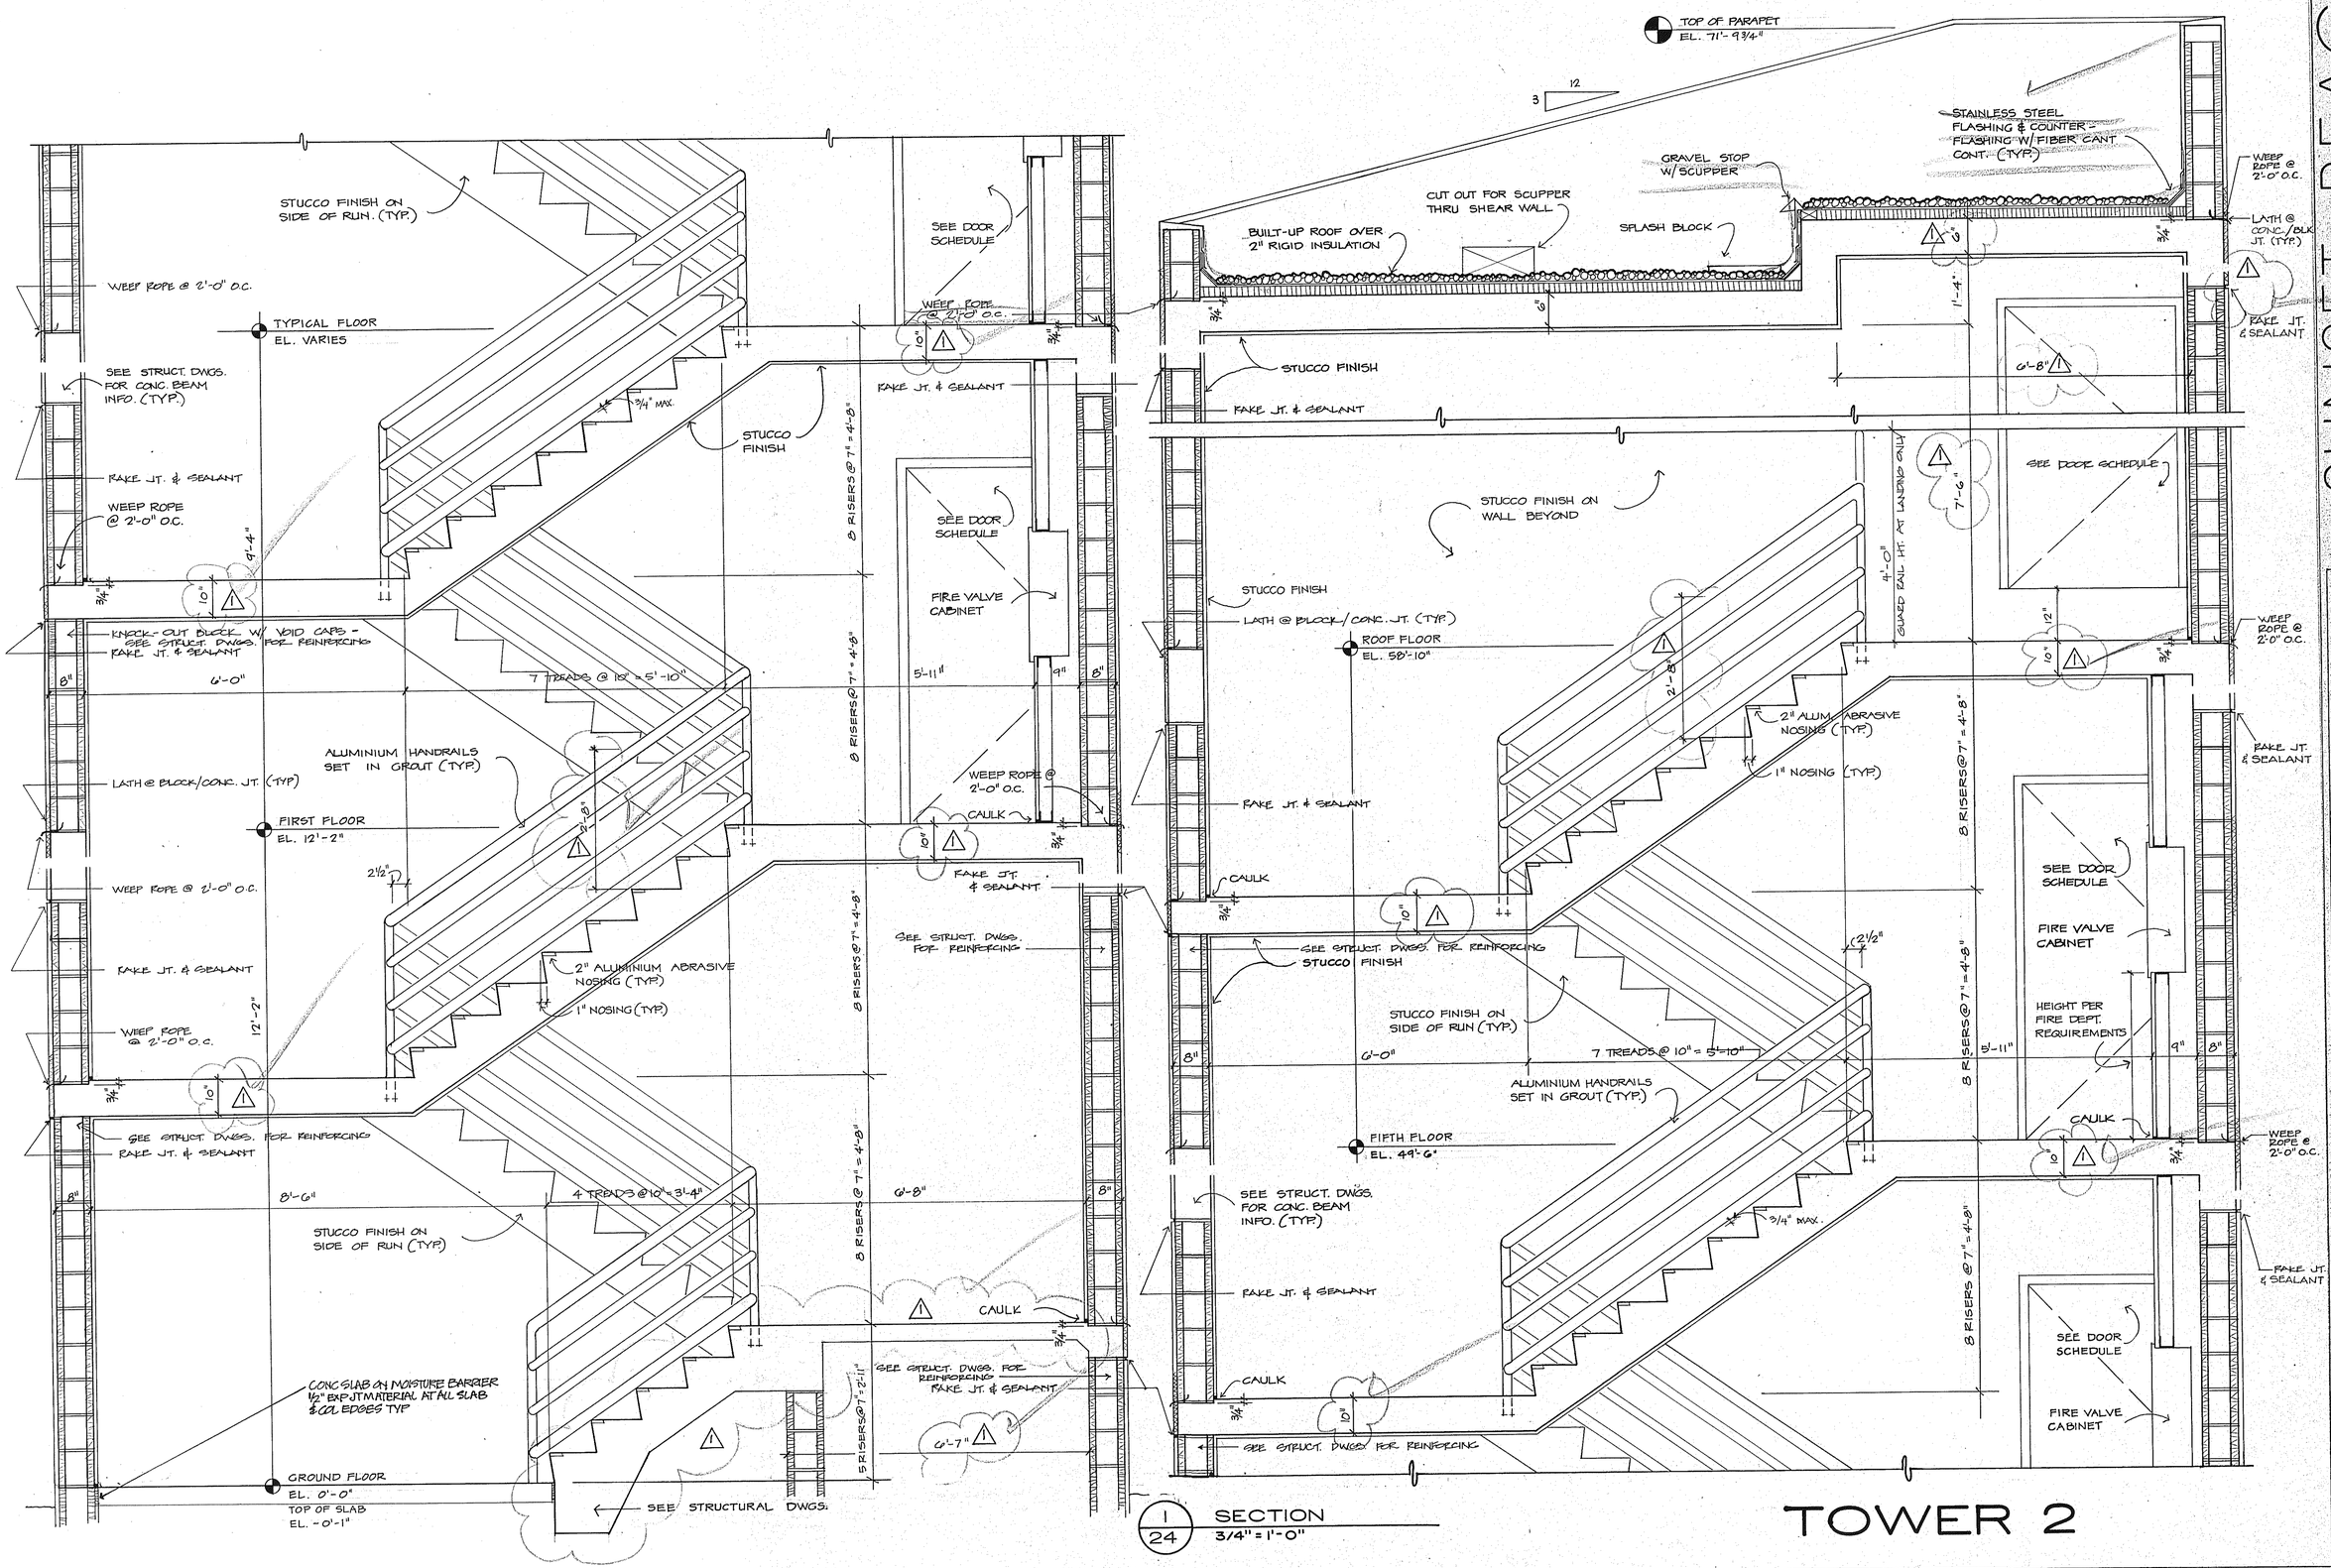


1/24 SECTION
3/4" = 1'-0"

# TOWER 2

SUNSET BEACH OF LONG BOAT KEY

STAIR SECTIONS 3/4" = 1'-0"

BUILDING 3

ARVIDA CORPORATION - EDWARD J. SEIBERT AIA ARCHITECT & PLANNER PA - THE SWA GROUP
BRABHAM, KUHNS, DEBAY - CONSULTING ENGINEERS - OLSEN, WHITE & ASSOCIATES - STRUCTURAL ENGINEERS - BENNETT & BISHOP, INC. CONSULTING ENGINEERS & SURVEYORS

ISSUED
10 DEC. 82

REVISED
1 4-1-83

SHEET
A-24
OF 3