
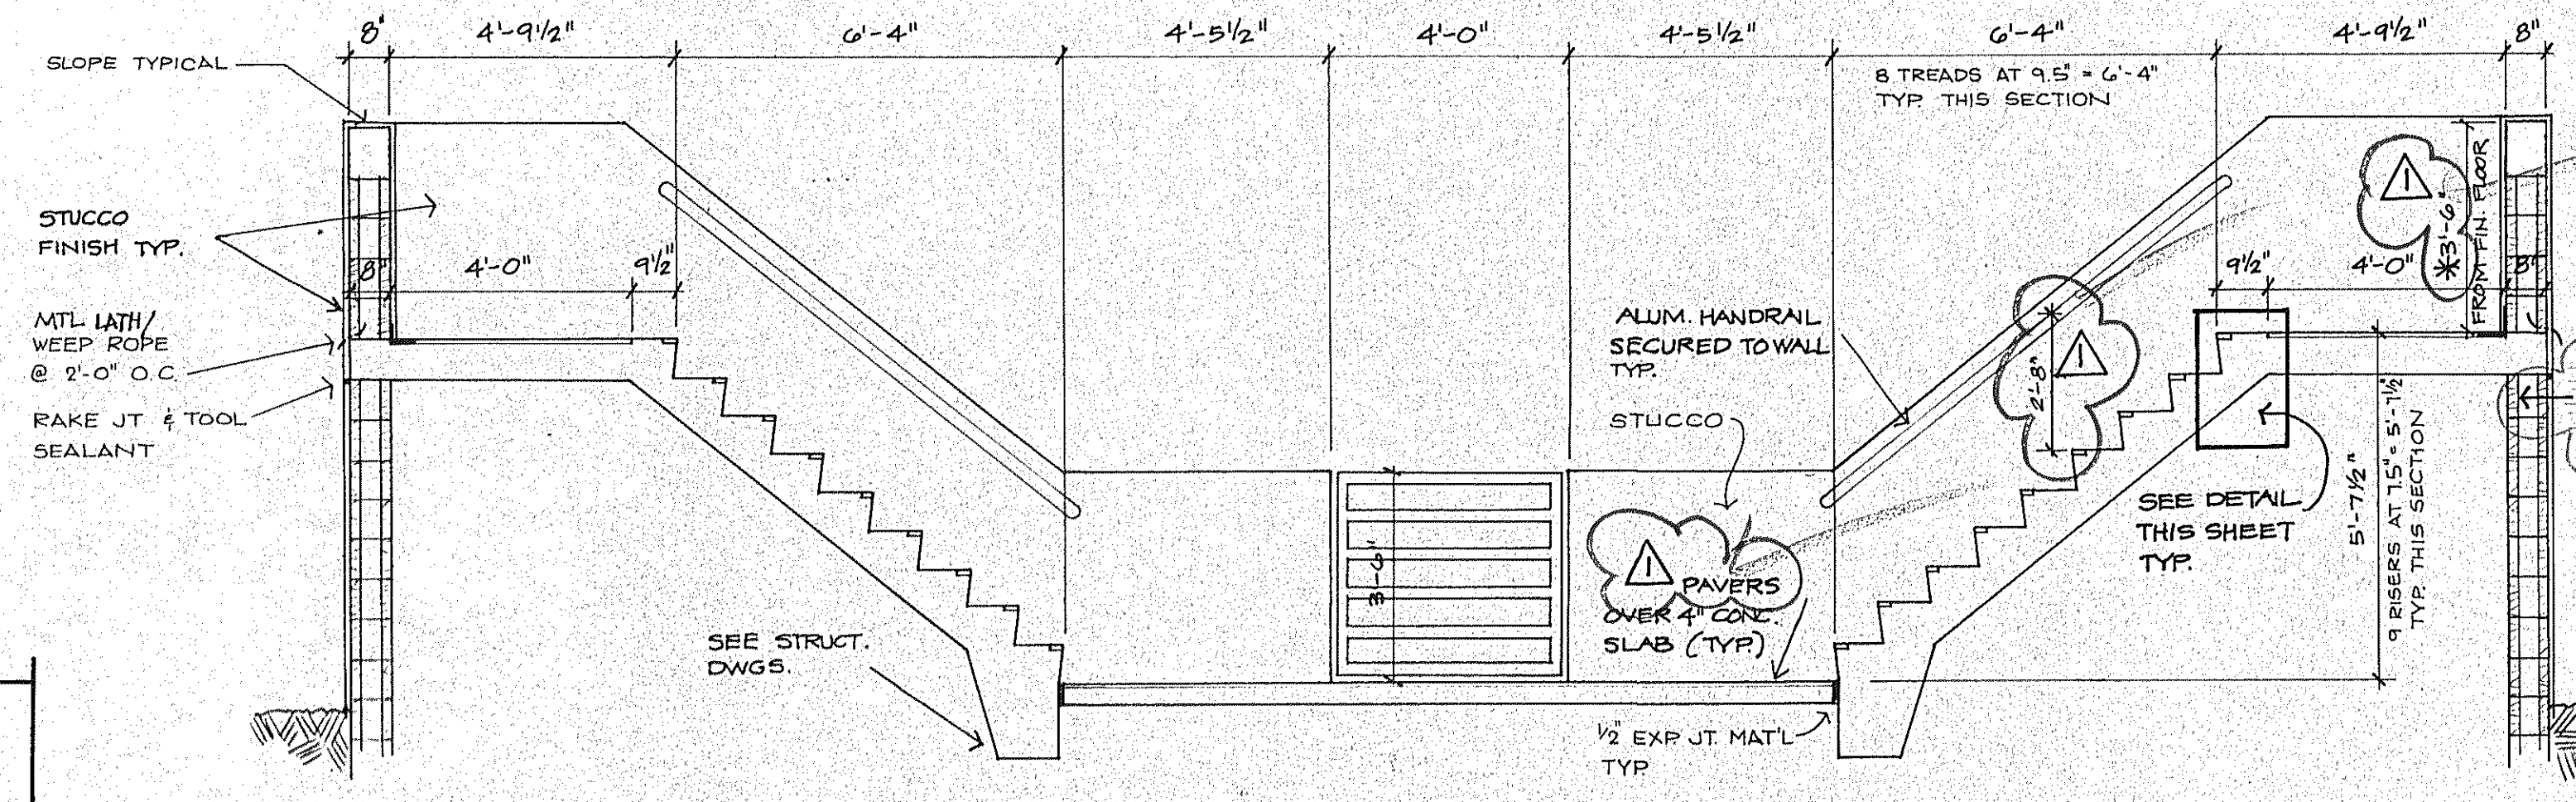



SECTION 1
3/8"=1'-0" 29 BUILDING 3

* MEASURED FROM INTERIOR FINISH FLOOR LINE. TYP ALL LANDINGS


NOTES
ALUMINUM RAIL GATES: PIVOT HINGES AND LATCH HARDWARE TO BE PROVIDED BY ALUM. RAIL FABRICATOR. SUBMIT SAMPLES TO ARCHITECT FOR APPROVAL PRIOR TO FABRICATION.

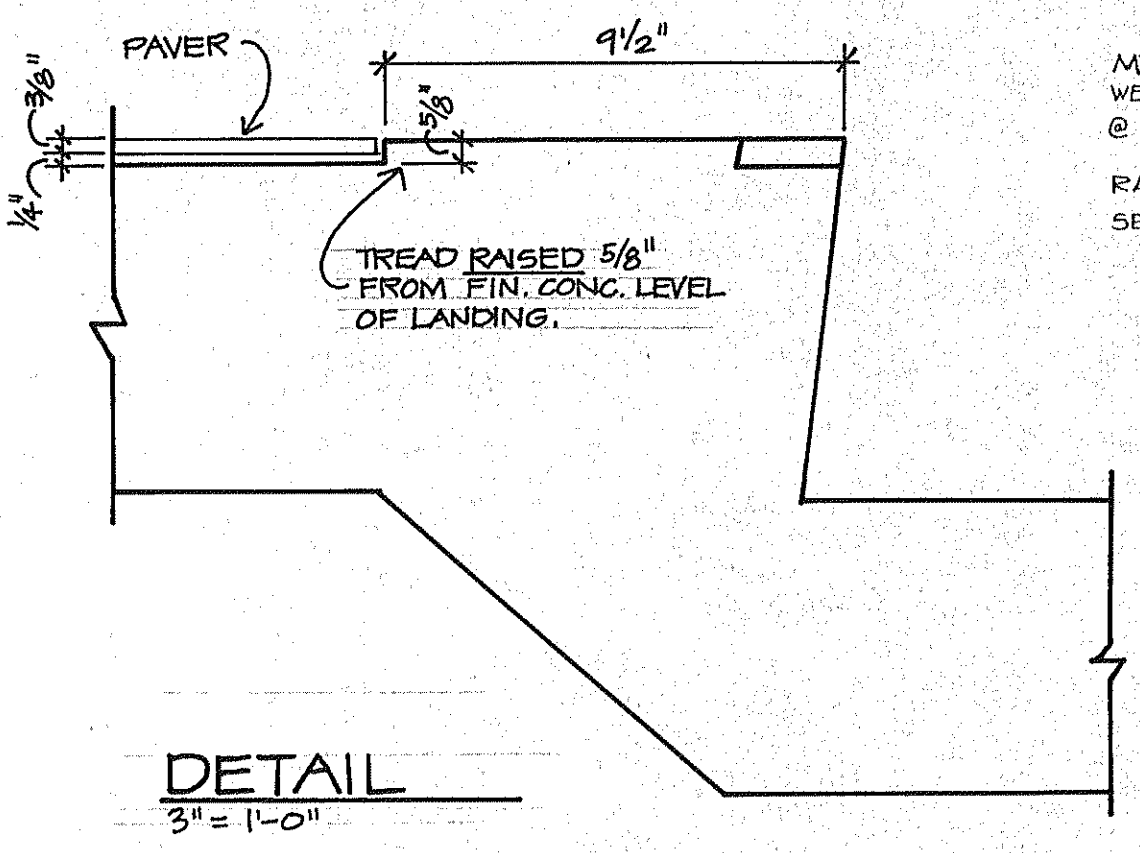

SECTION 3
3/8"=1'-0" 29 BUILDING 2

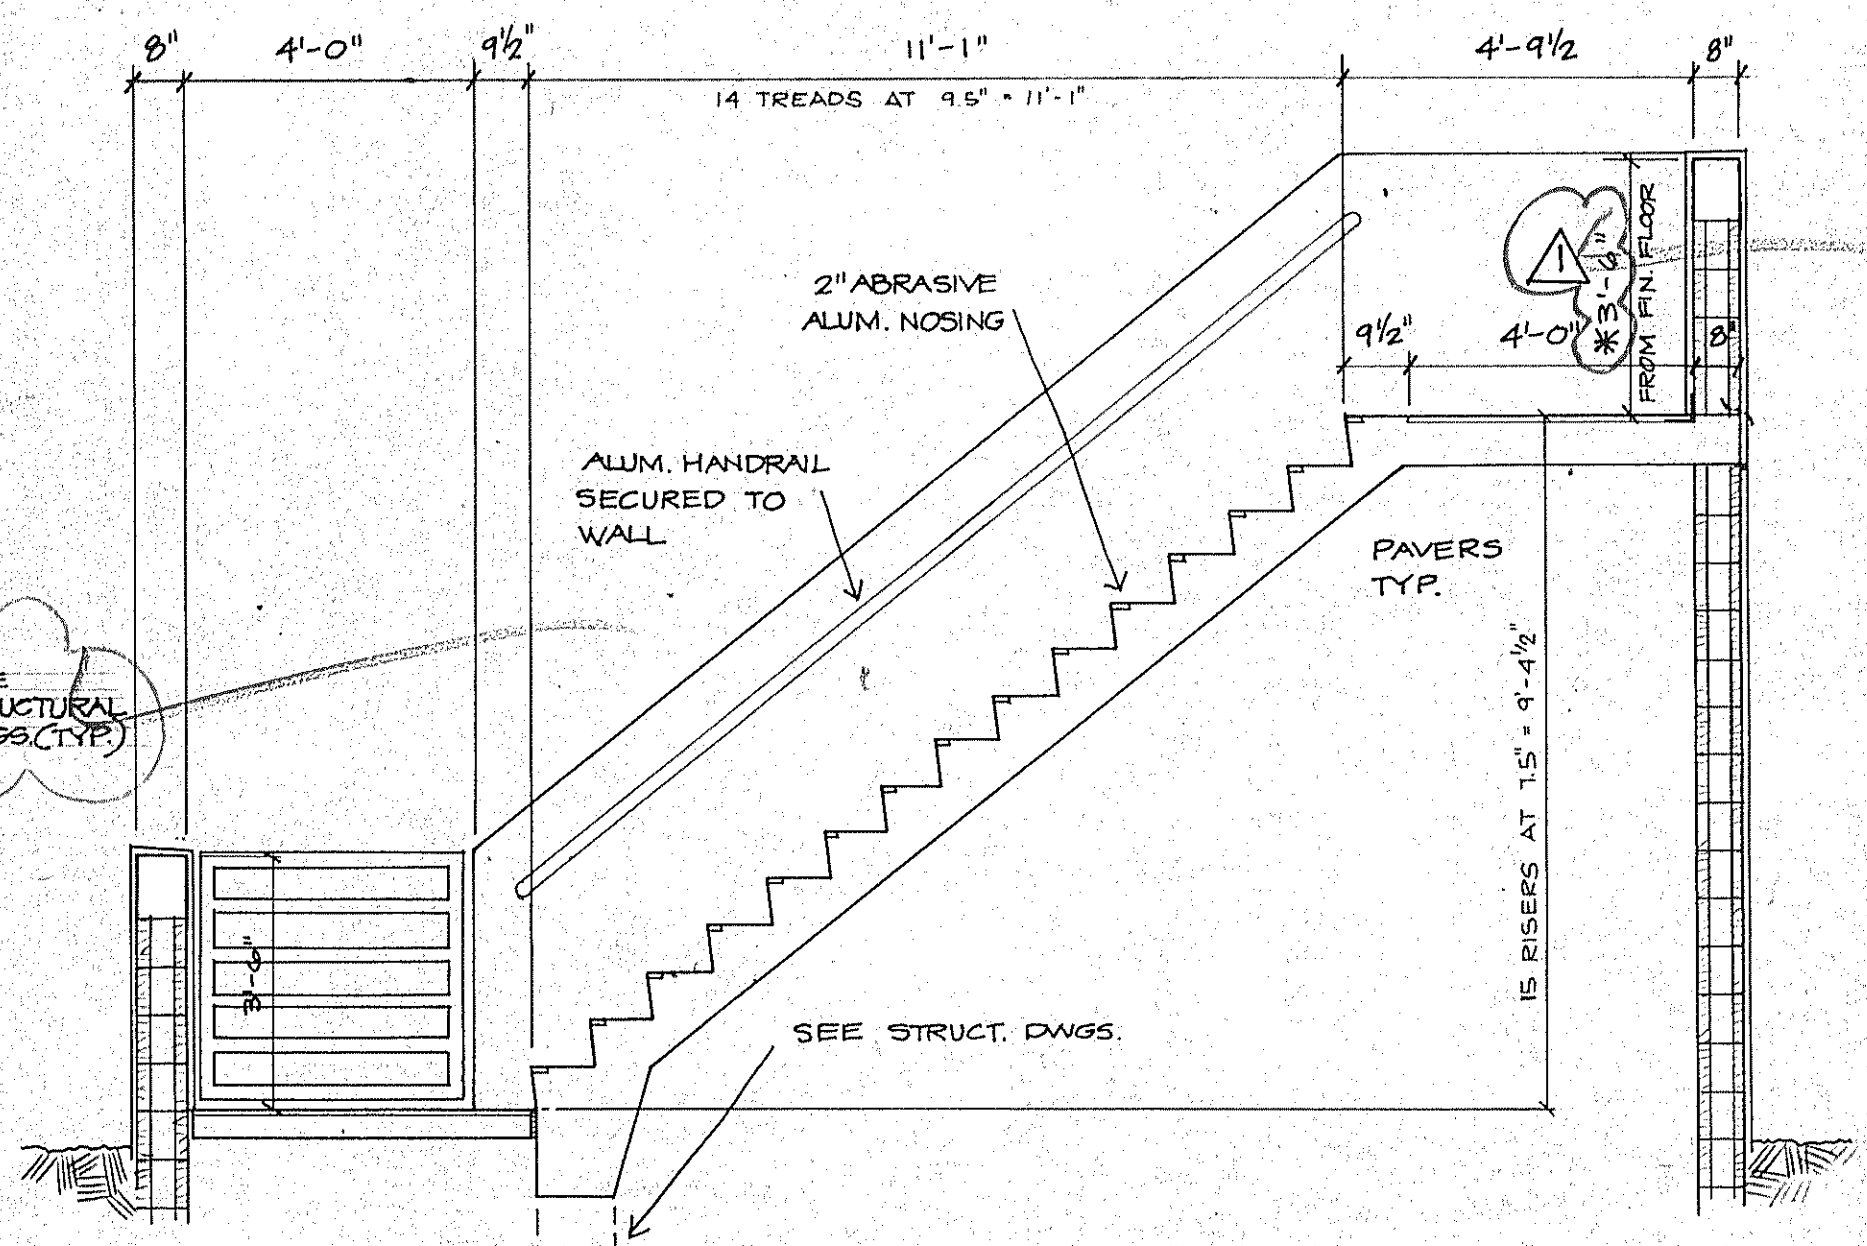


SECTION 4
3/8"=1'-0" 29 BUILDING 3

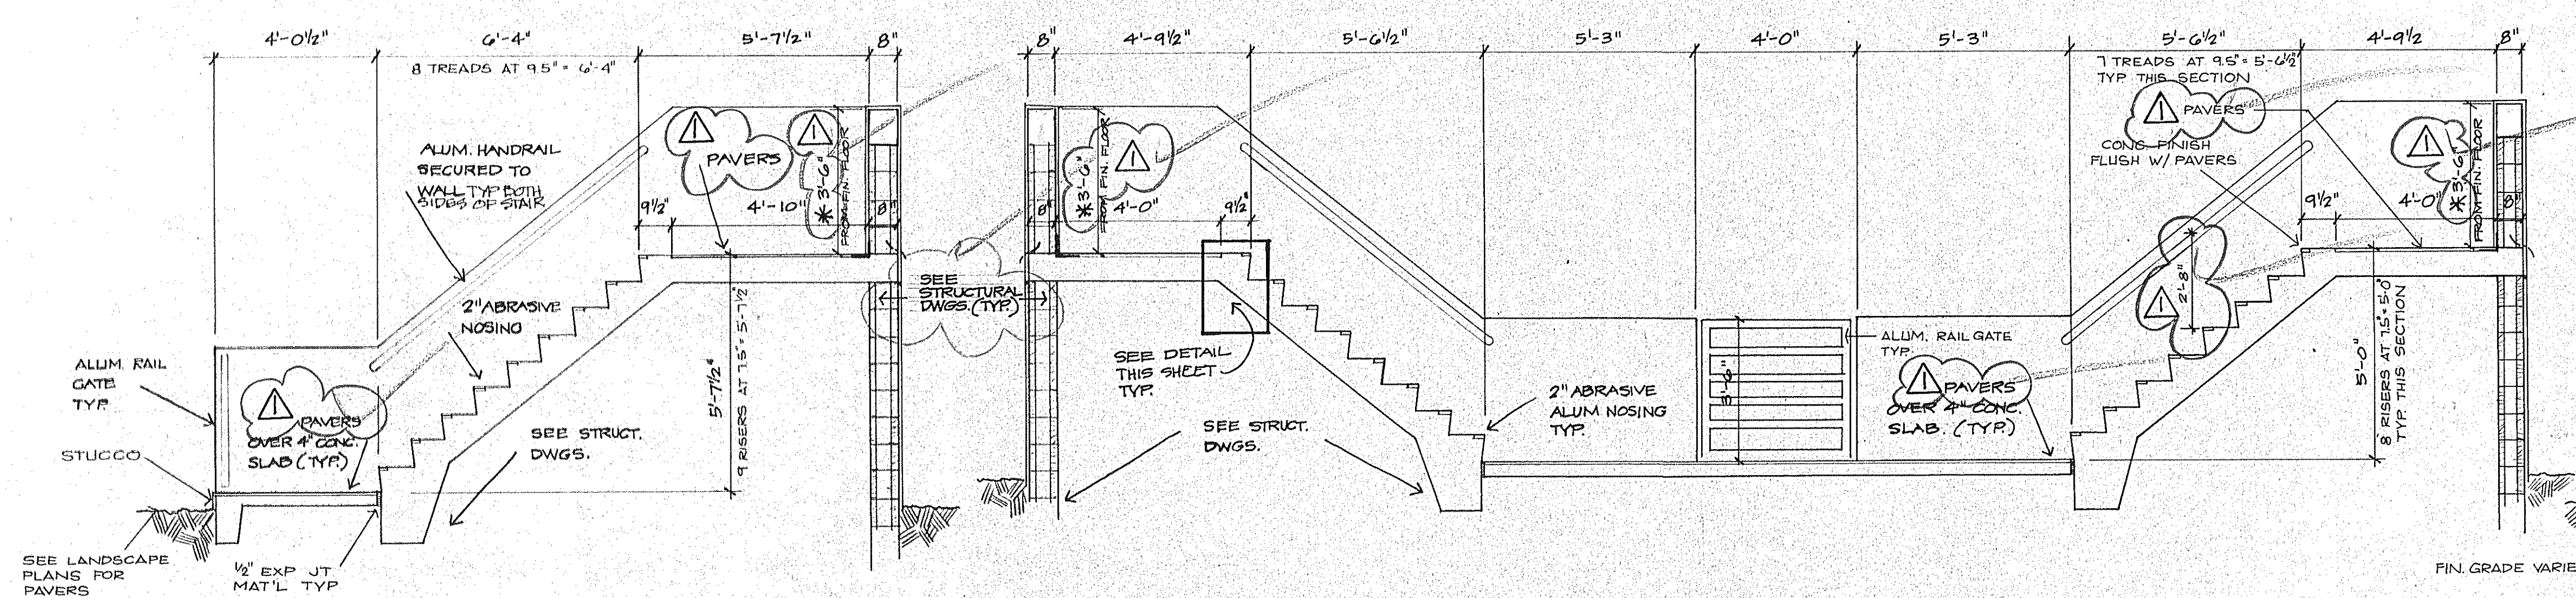

SECTION 5
3/8"=1'-0" 29 BUILDING 2

SECTION 6
3/8"=1'-0" 29 BUILDING 1

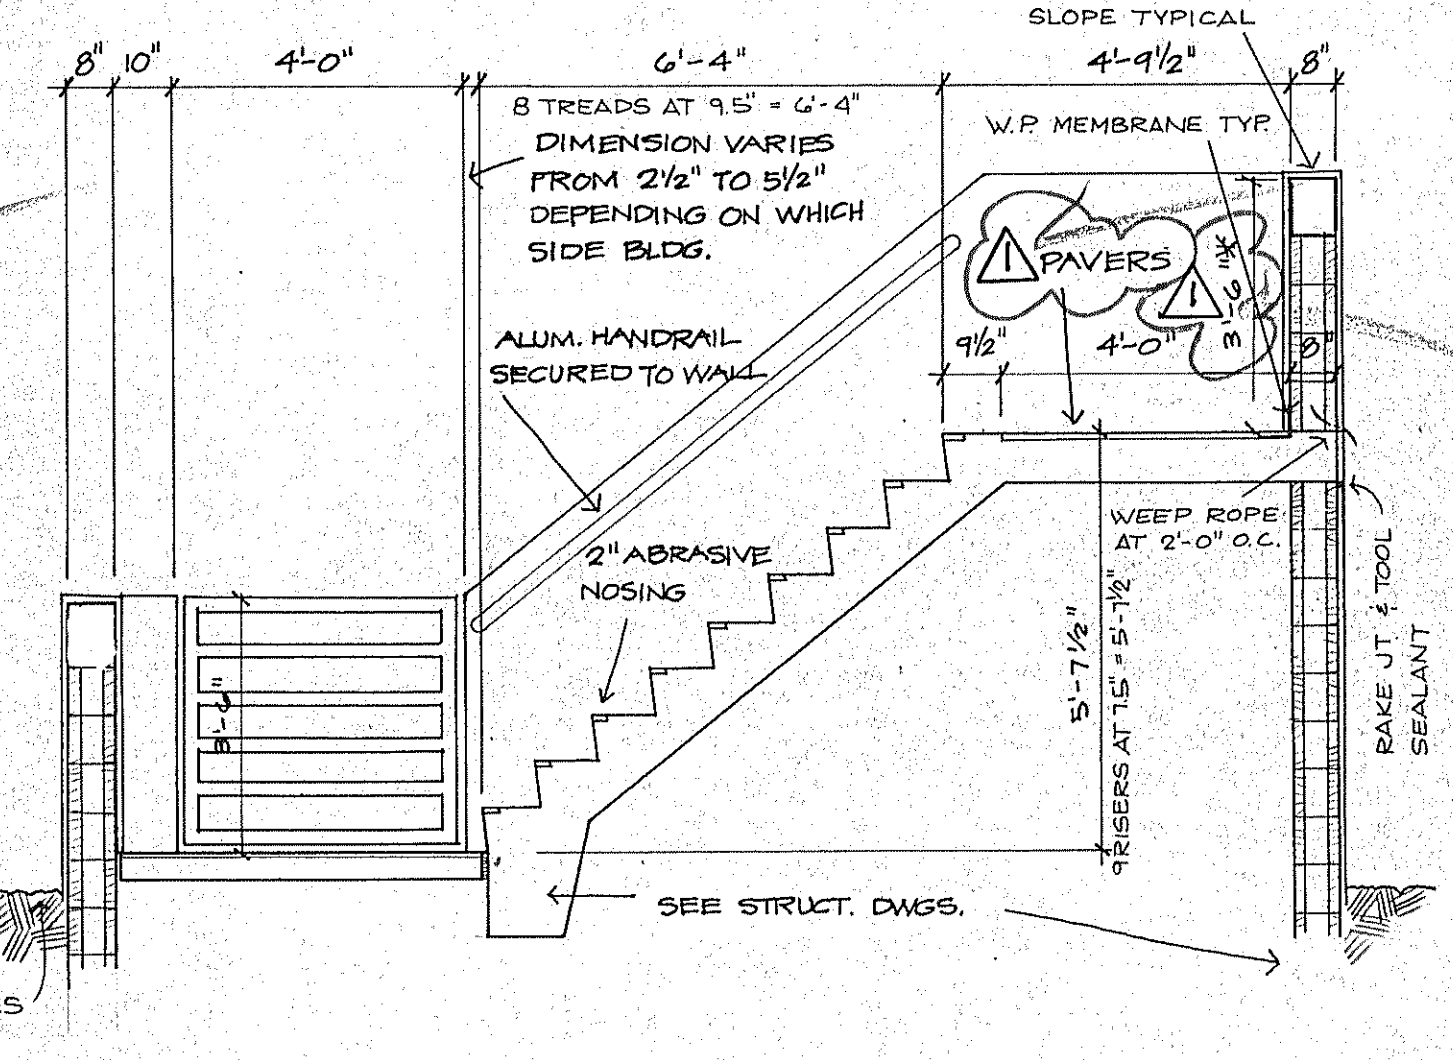

SECTION 7
3/8"=1'-0" 29 BUILDINGS 1 & 2