
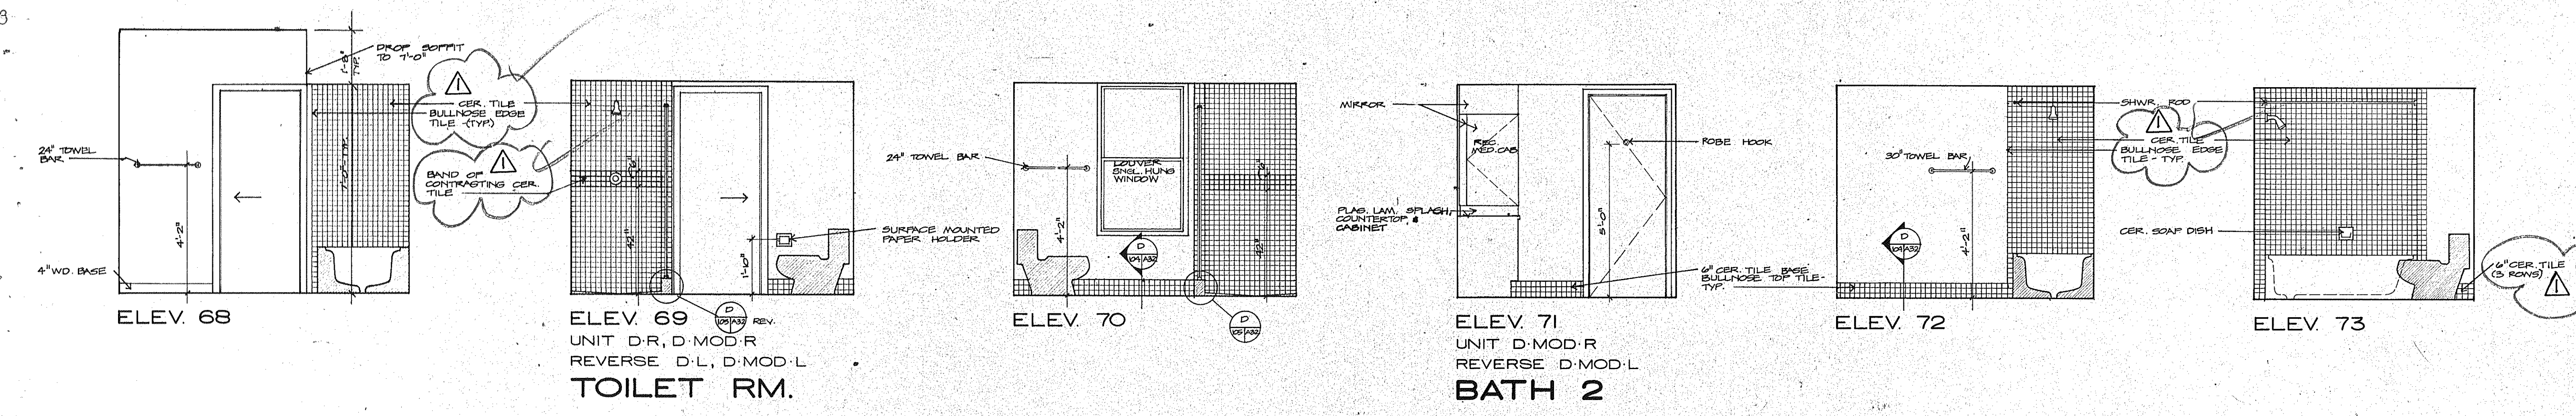
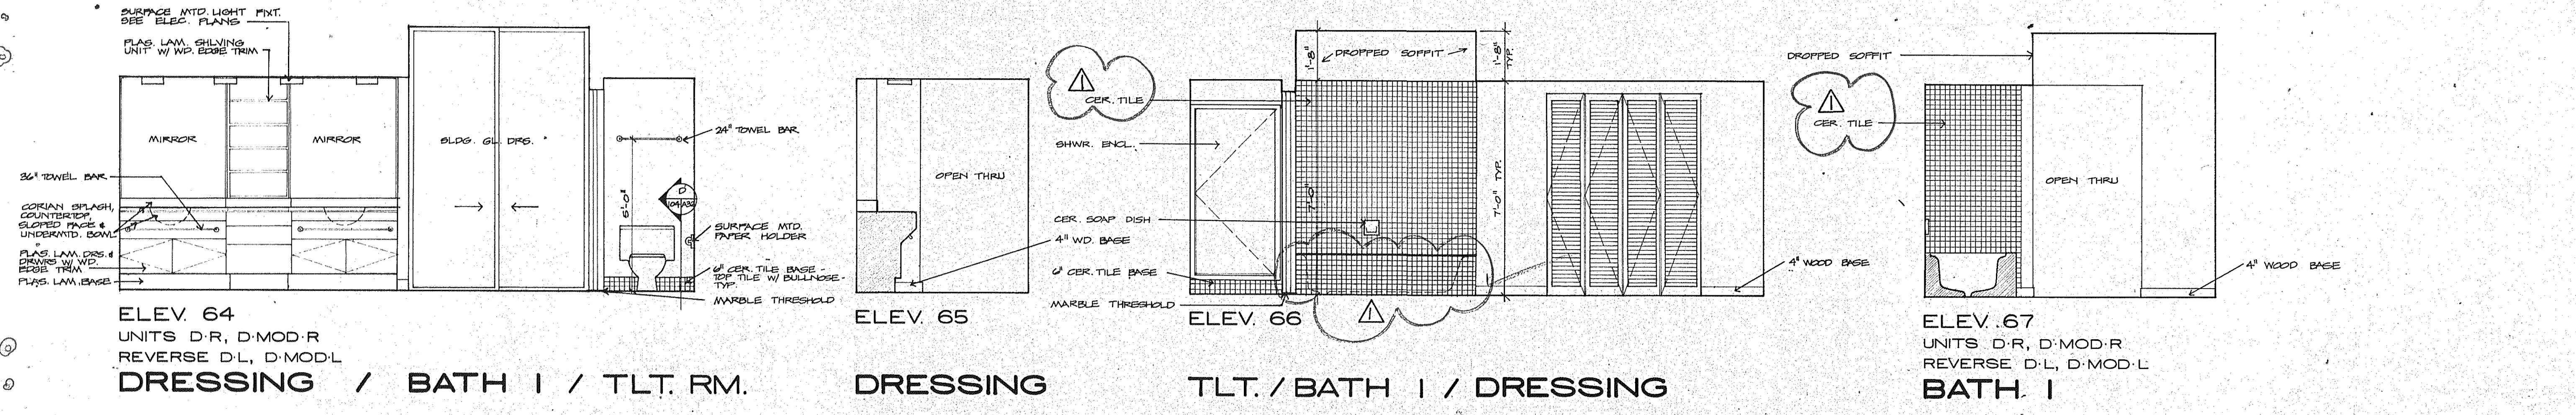
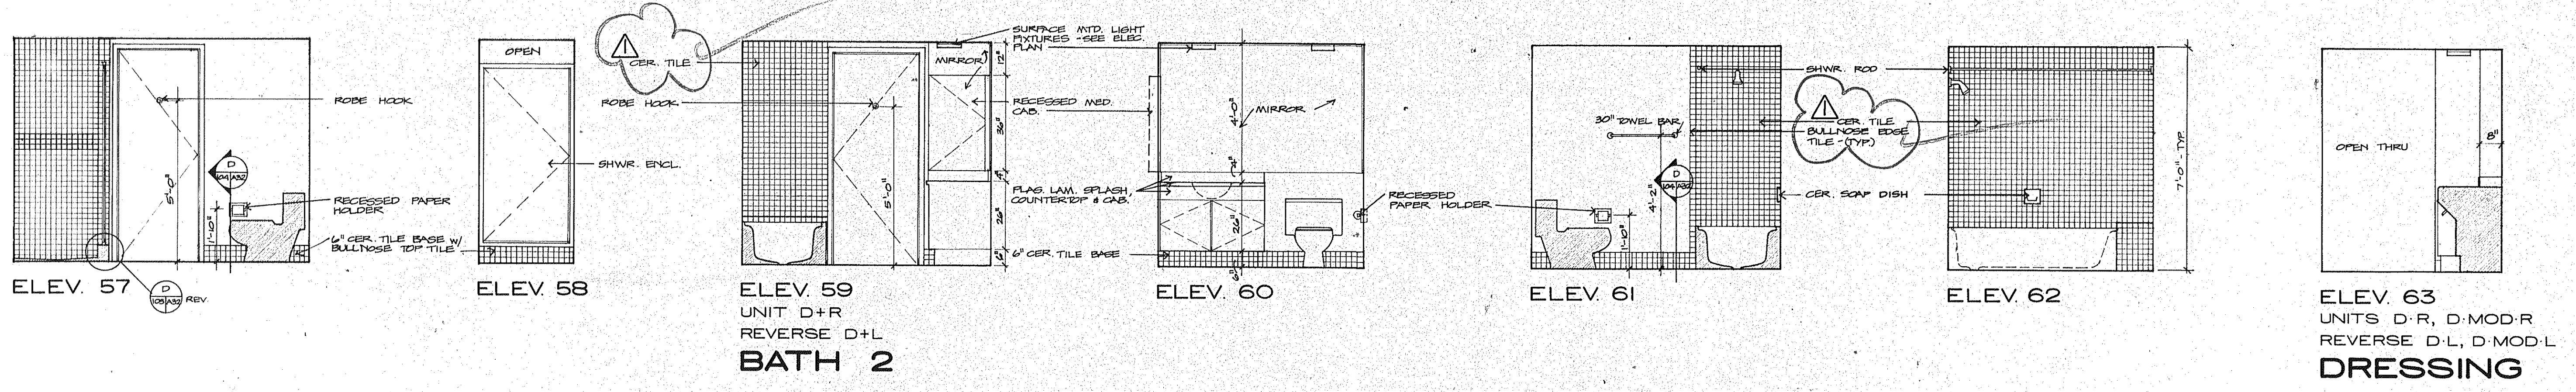


NOTES:
 1. MEDICINE CABINETS TO BE BUILT IN W/ MIRROR FACE
 2. ALLOW FOR MARBLE SILL BETWEEN CERAMIC TILE & CARPET

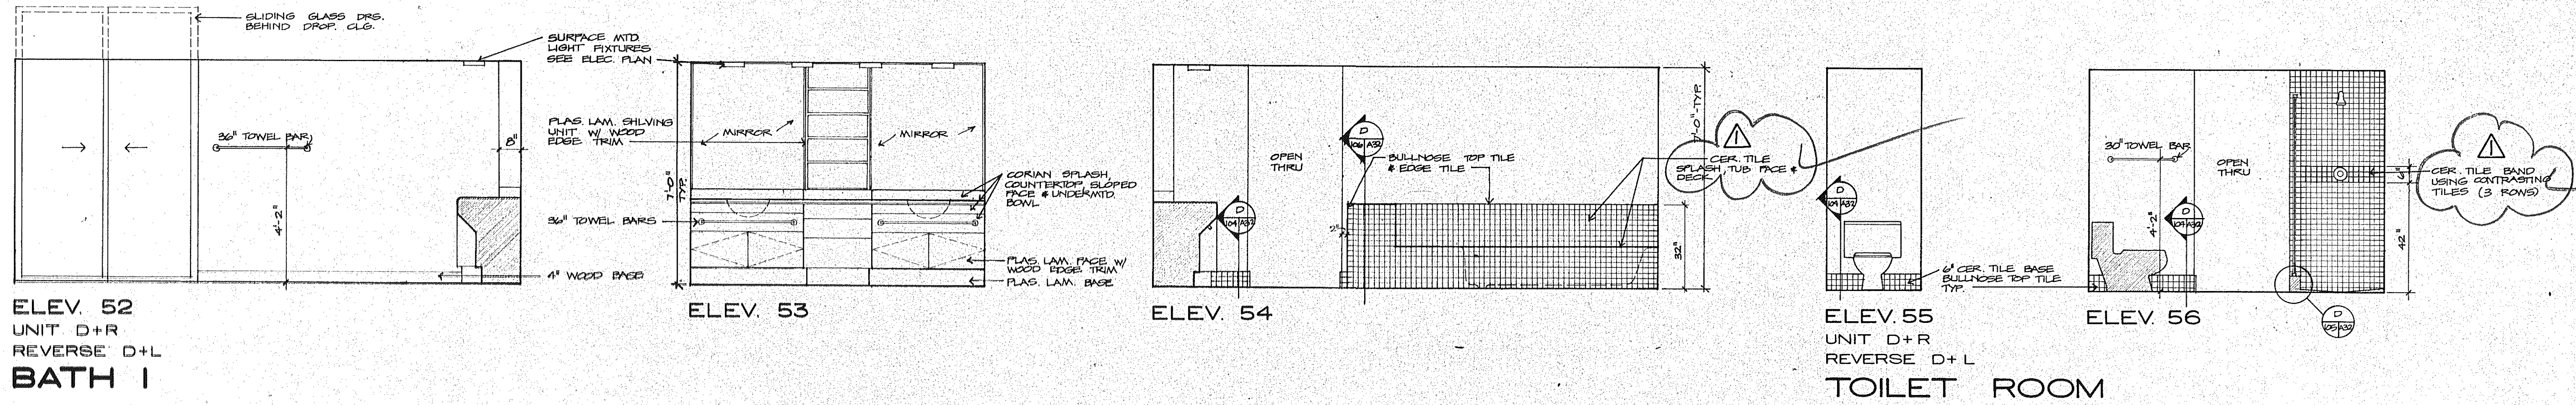

SUNSET BEACH
 SOF LONC BOAT KEY
 INTERIOR ELEVATIONS 3/8" = 1'-0"
 ARVADA CORPORATION · EDWARD J. SEIBERT AIA ARCHITECT & PLANNER PA · THE SVA GROUP
 BRABHAM KUHN DEBAY CONSULTING ENGINEERS · OLSEN WHITE & ASSOCIATES STRUCTURAL ENGINEERS · BENNETT & BISHOP INC CONSULTING ENGINEERS & SURVEYORS

ISSUED	10 DEC '82
REVISED	4-1-83
SHEET	A 32
	OF 37