
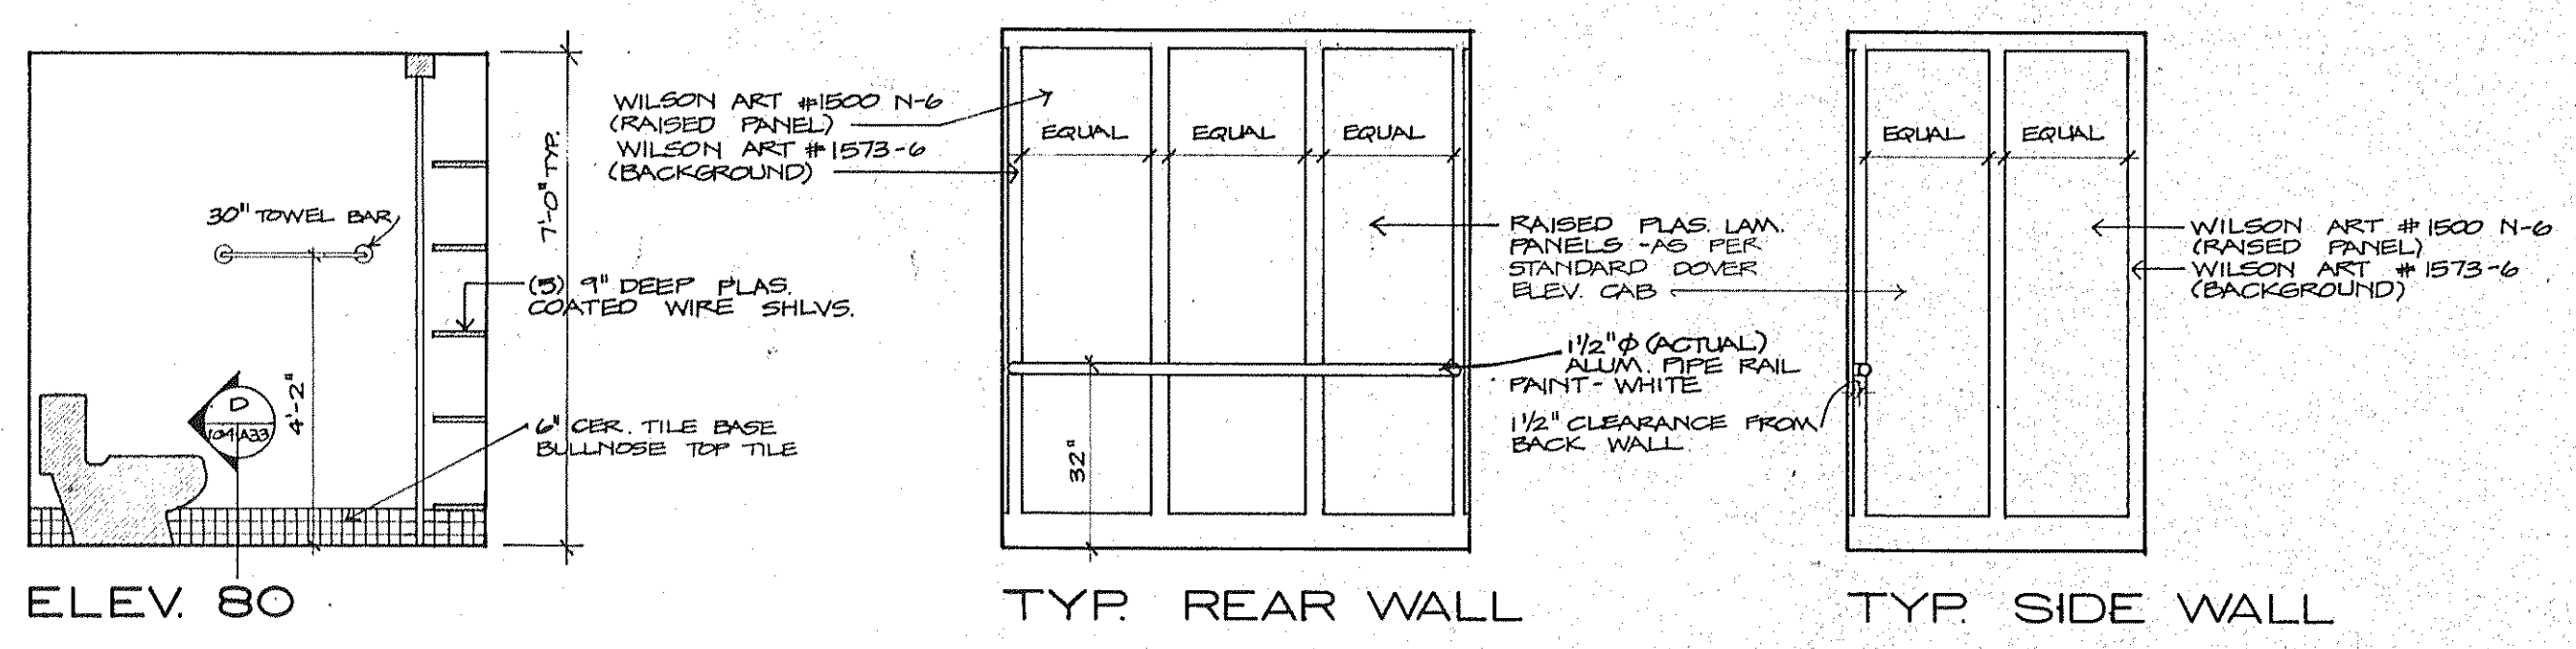


NOTES:
 1. MEDICINE CABINETS TO BE BUILT IN W/ MIRROR FACE
 2. ALLOW FOR MARBLE SILL BETWEEN CERAMIC TILE & CARPET

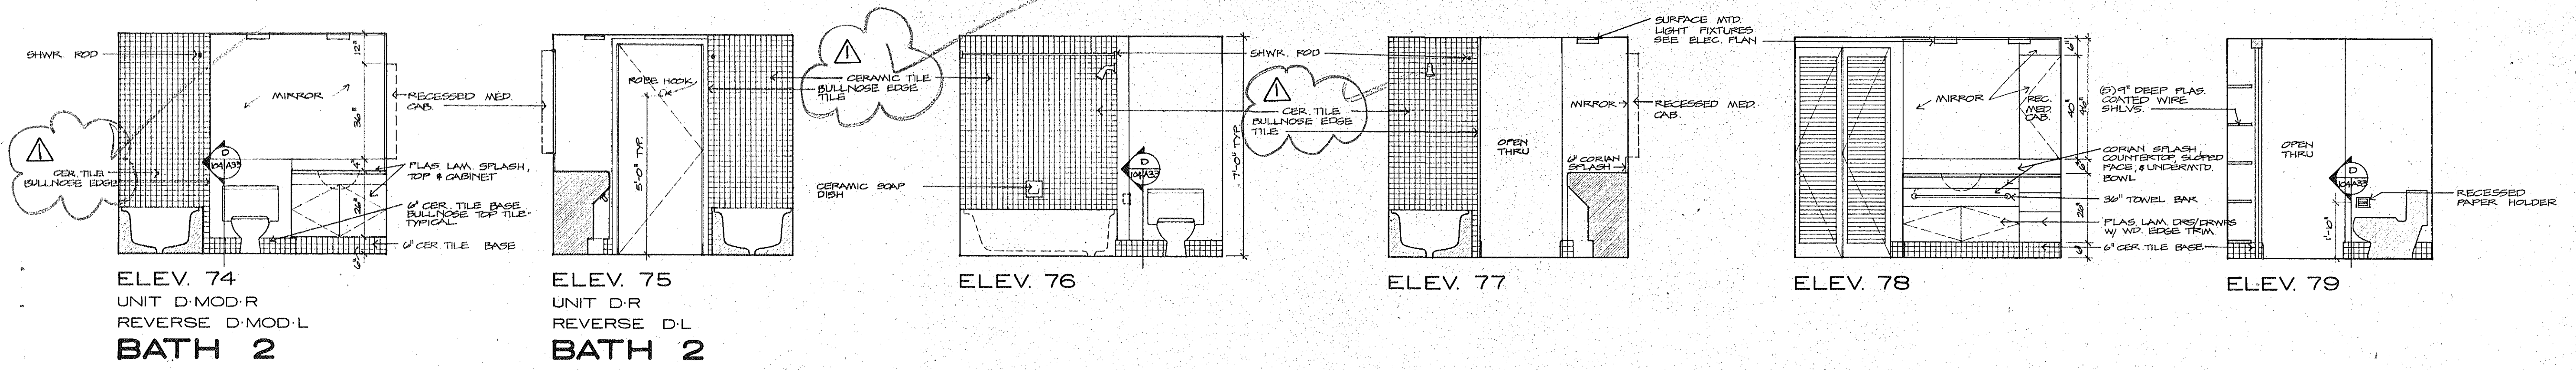

ELEVATOR CAB

SUNSET BEACH
 SOLO LONG BOAT KEY
 BENNETT & BISHOP, INC. CONSULTING ENGINEERS & SURVEYORS
 THE SWA GROUP
 ARCHITECT & PLANNER, PA.
 EDWARD J. SEIBERT AIA ARCHITECT & PLANNER
 ENGINEERS, CONSULTING ENGINEERS
 OLSEN, WHITE & ASSOCIATES STRUCTURAL ENGINEERS
 BRABHAM, KUHNIS, DEBAY, CONSULTING ENGINEERS
 INTERIOR ELEVATIONS 3/8" = 1'-0"

ISSUED	10 DEC 82
REVISED	4-1-83
SHEET	A 33
	OF 57