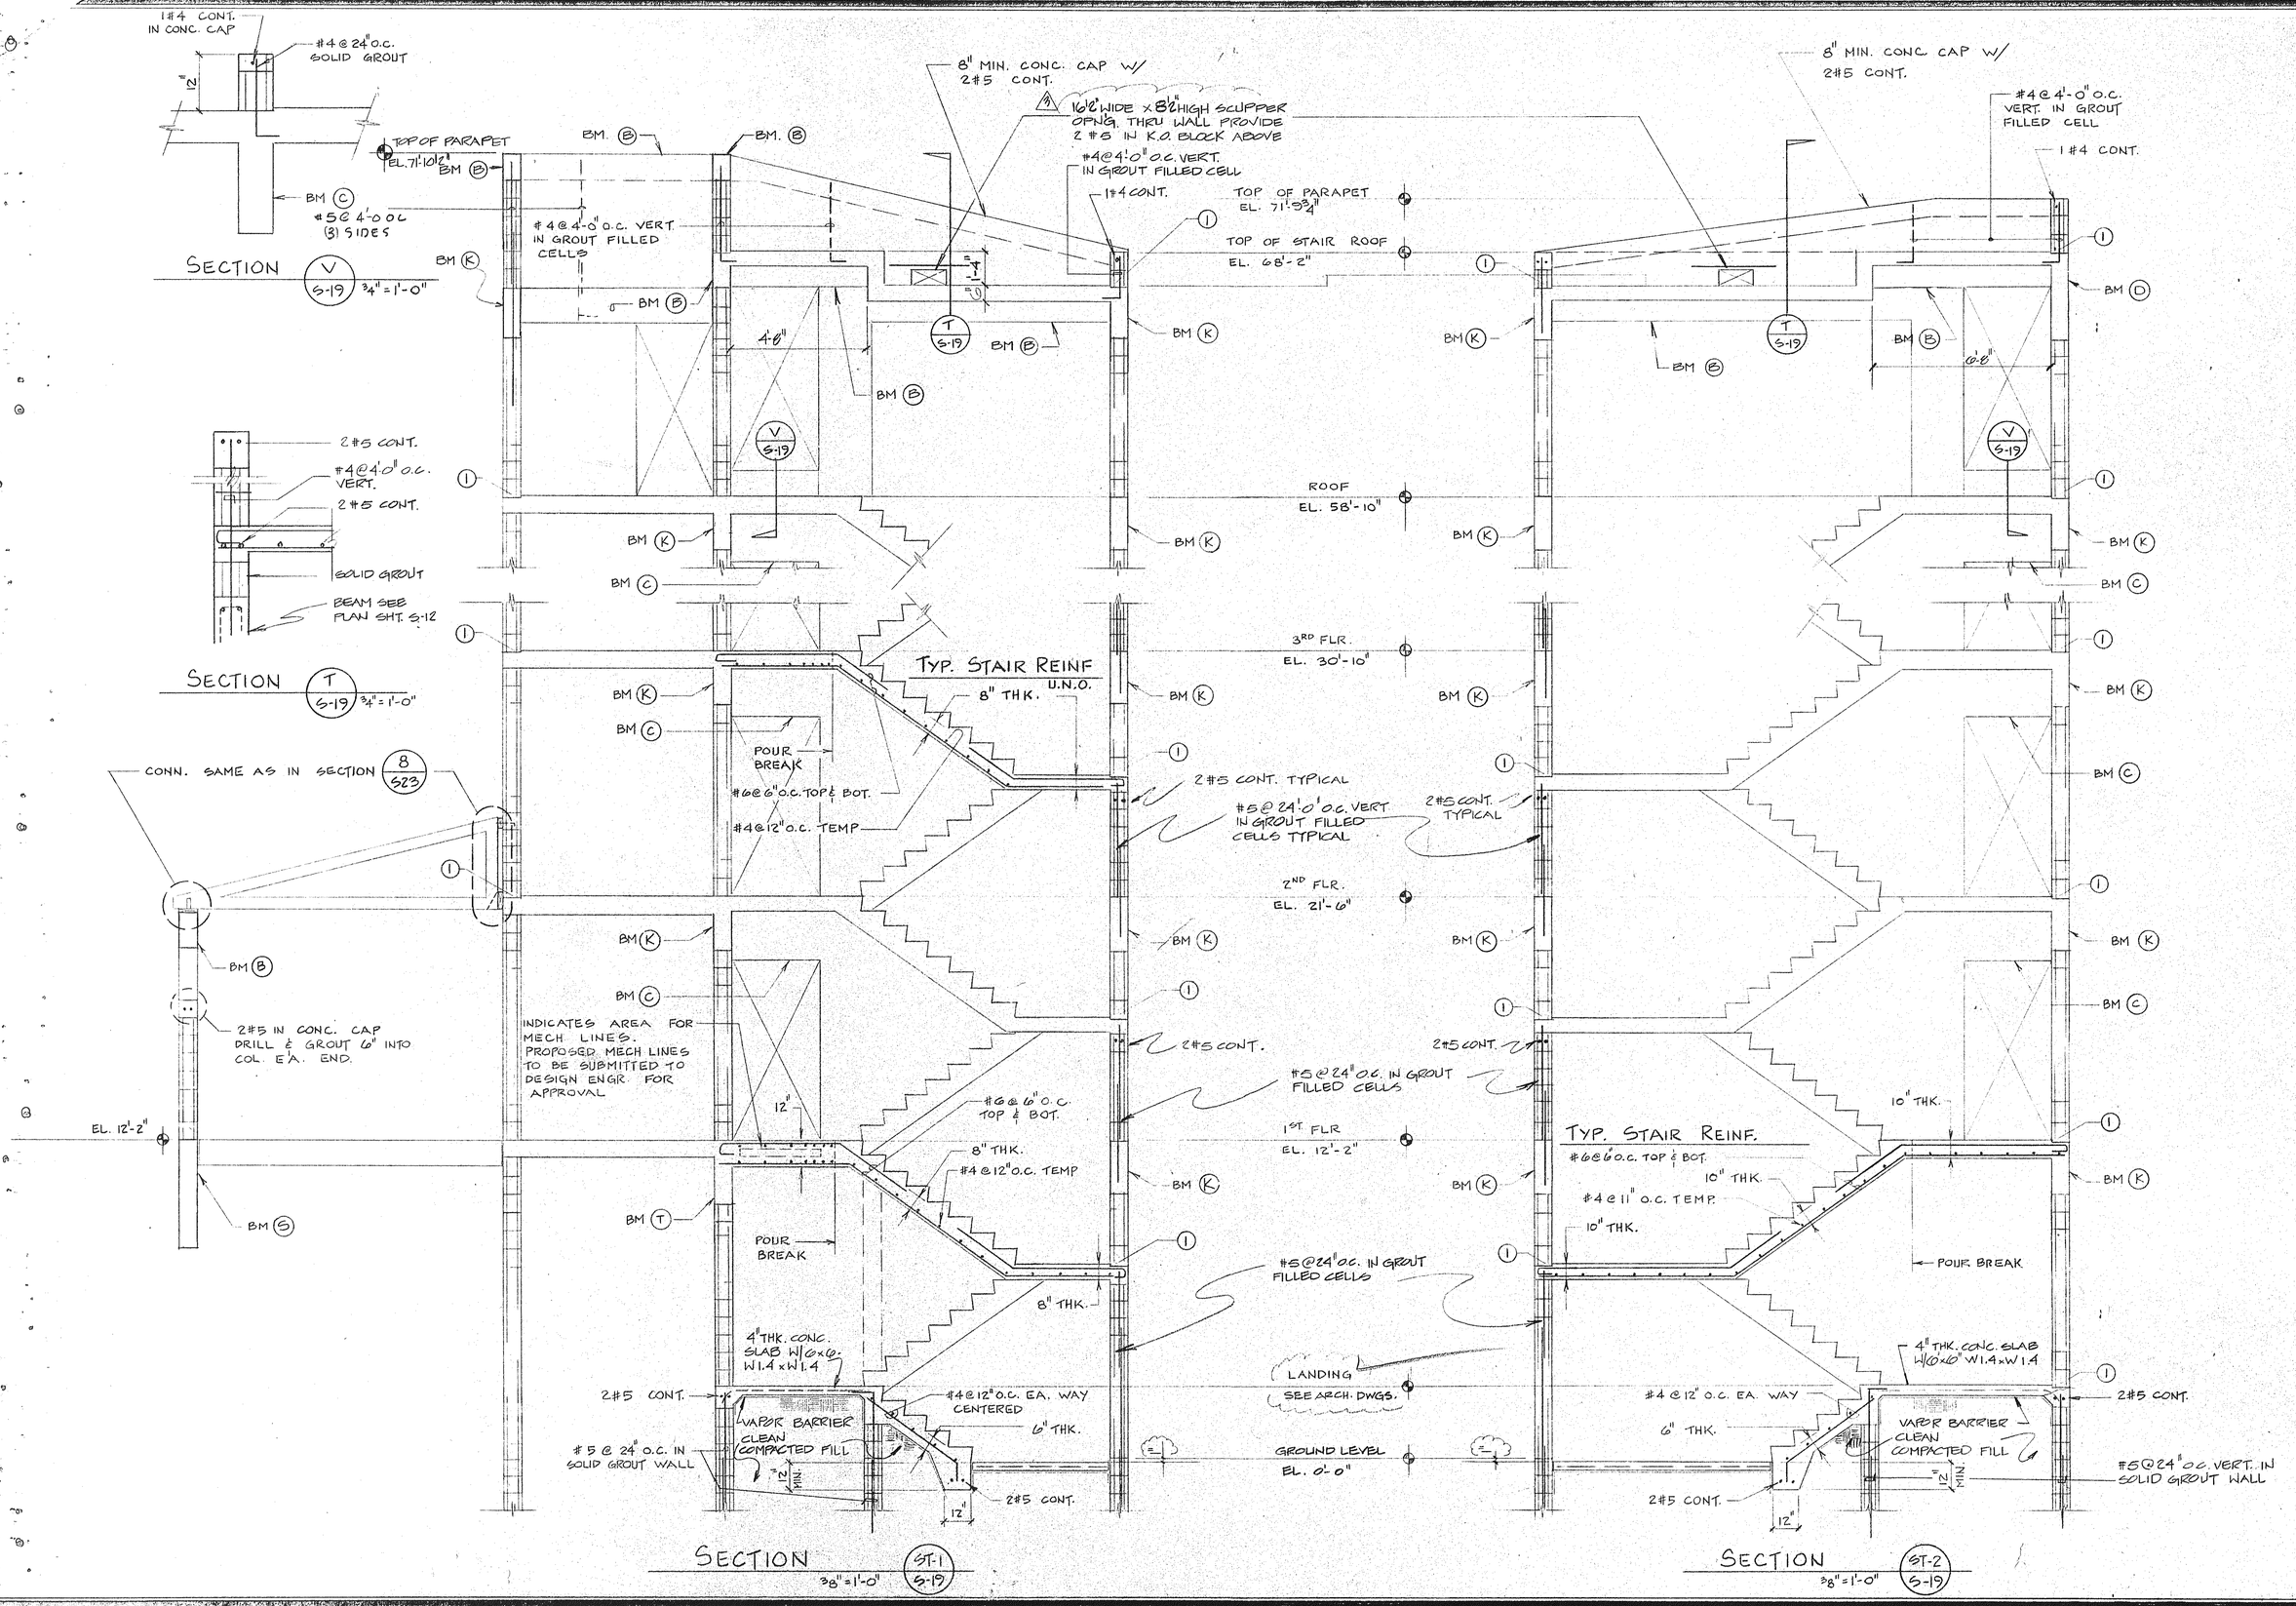

SUNSET BEACH
BOCA RATON, FLORIDA

BUILDING - 3

SECTIONS & DETAILS

ARVIDA CORPORATION - EDWARD J. GEELEFT AIA ARCHITECT & PLANNER, PA - THE SYVA GROUP
BRABHAM KUHNS DEBAY CONSULTING ENGINEERS - BENNETTS & BISHOP, INC. CONSULTING ENGINEERS & SURVEYORS
OLSEN, WHITE & ASSOCIATES STRUCTURAL ENGINEERS

ISSUED	12-10-82
REVISED	1-4-83
	4-1-83
	△ 11-11-83

SHEET S-19 OF

81231