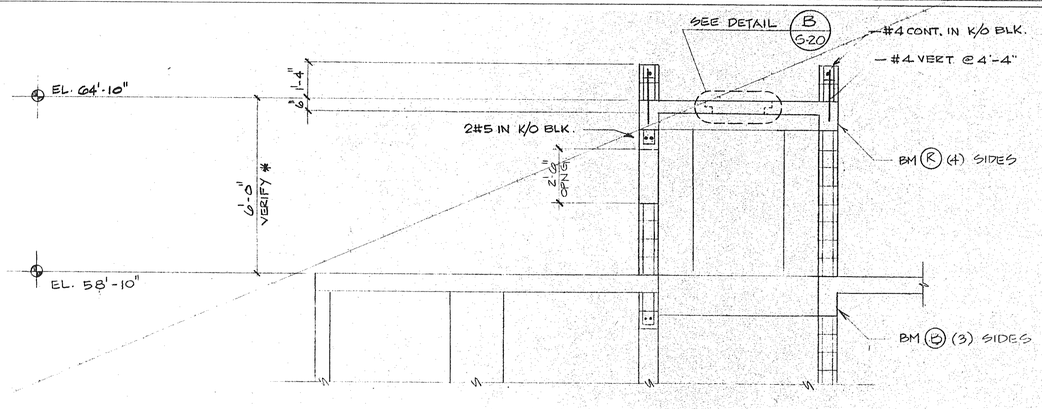

SECTION E S-20 CONTINUED

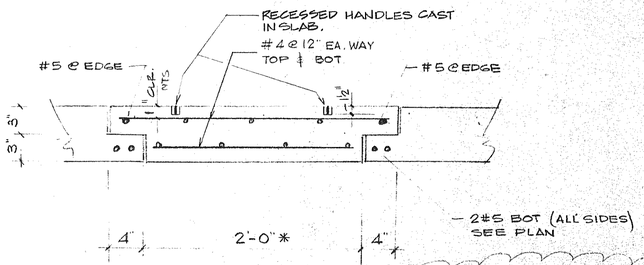

DETAIL B S-20 1½" = 1'-0"

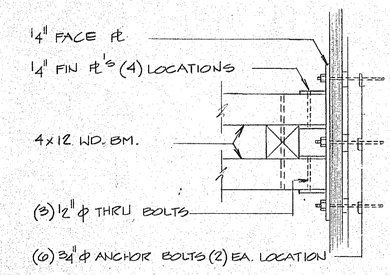

DETAIL Y S20 (TYP. EA. END) 1½" = 1'-0"

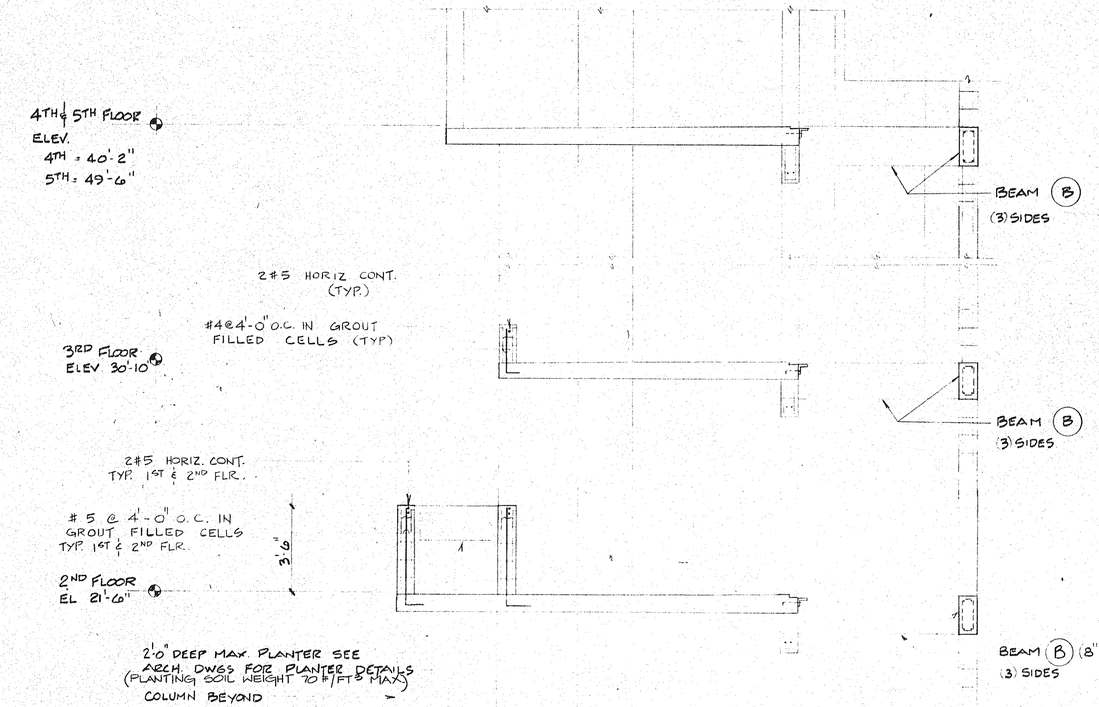

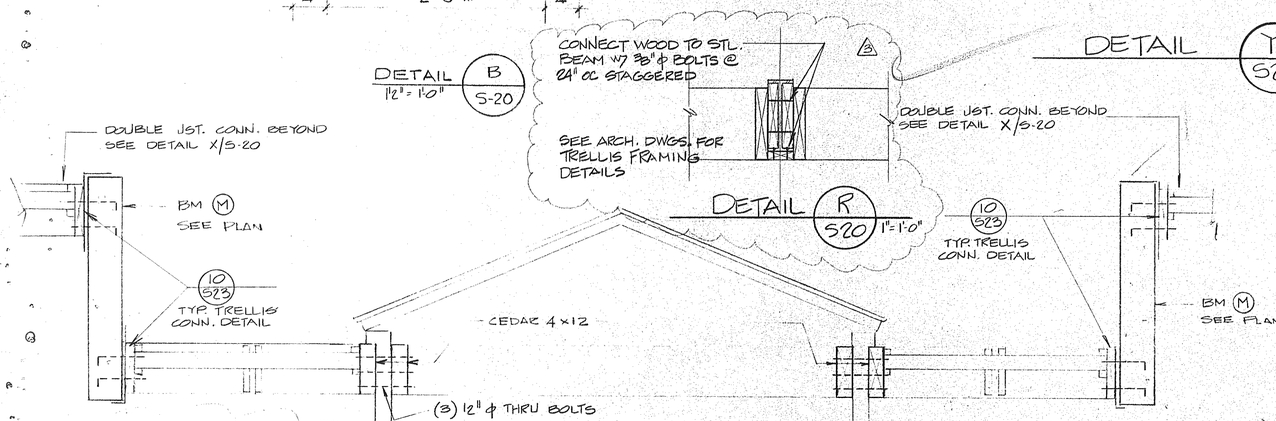

DETAIL R S20 1" = 1'-0"

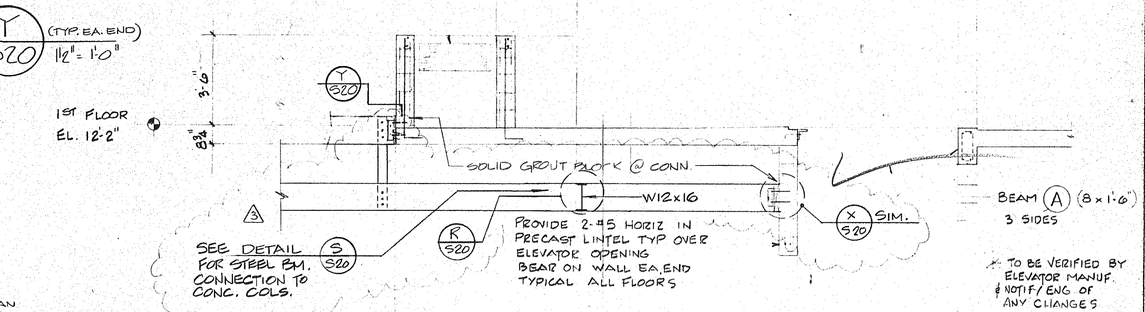

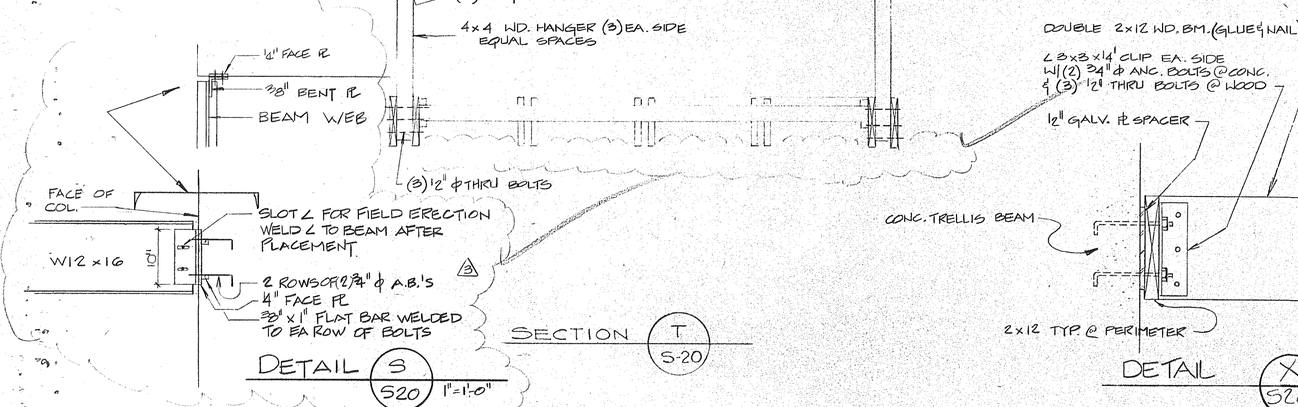

DETAIL S S20 1" = 1'-0"

SECTION T S-20

DETAIL X S20 1½" = 1'-0"

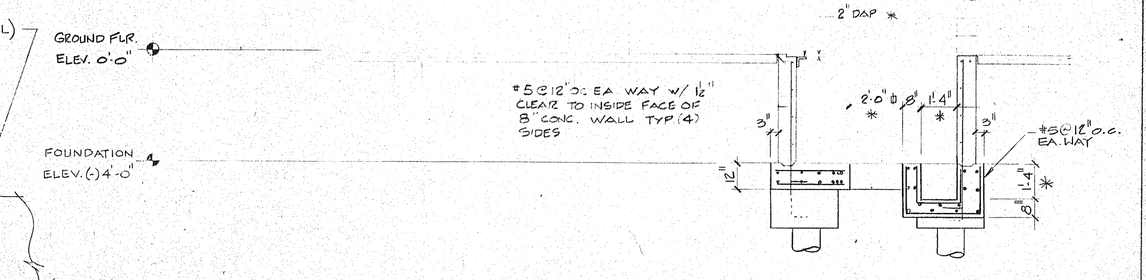

SECTION E S-20 3/8" = 1'-0"

SUNSET BEACH OF LONGBOAT KEY

BLDG. - 3 SECTIONS & DETAILS

ARVIDA CORPORATION - EDWARD J. SEIBERT, AIA, ARCHITECT & PLANNER - PA - THE SWA GROUP
BRABHAM, KUNNIS, DEBAY CONSULTING ENGINEERS - OLSEN, WHITE & ASSOCIATES STRUCTURAL ENGINEERS - BENNETT & BISHOP INC CONSULTING ENGINEERS & SURVEYORS

3/8" = 1'-0"

ISSUED	12-10-82
REVISED	1-4-83
	4-1-83
	△3 11-11-83
SHEET	S.20
	OF 24

81731