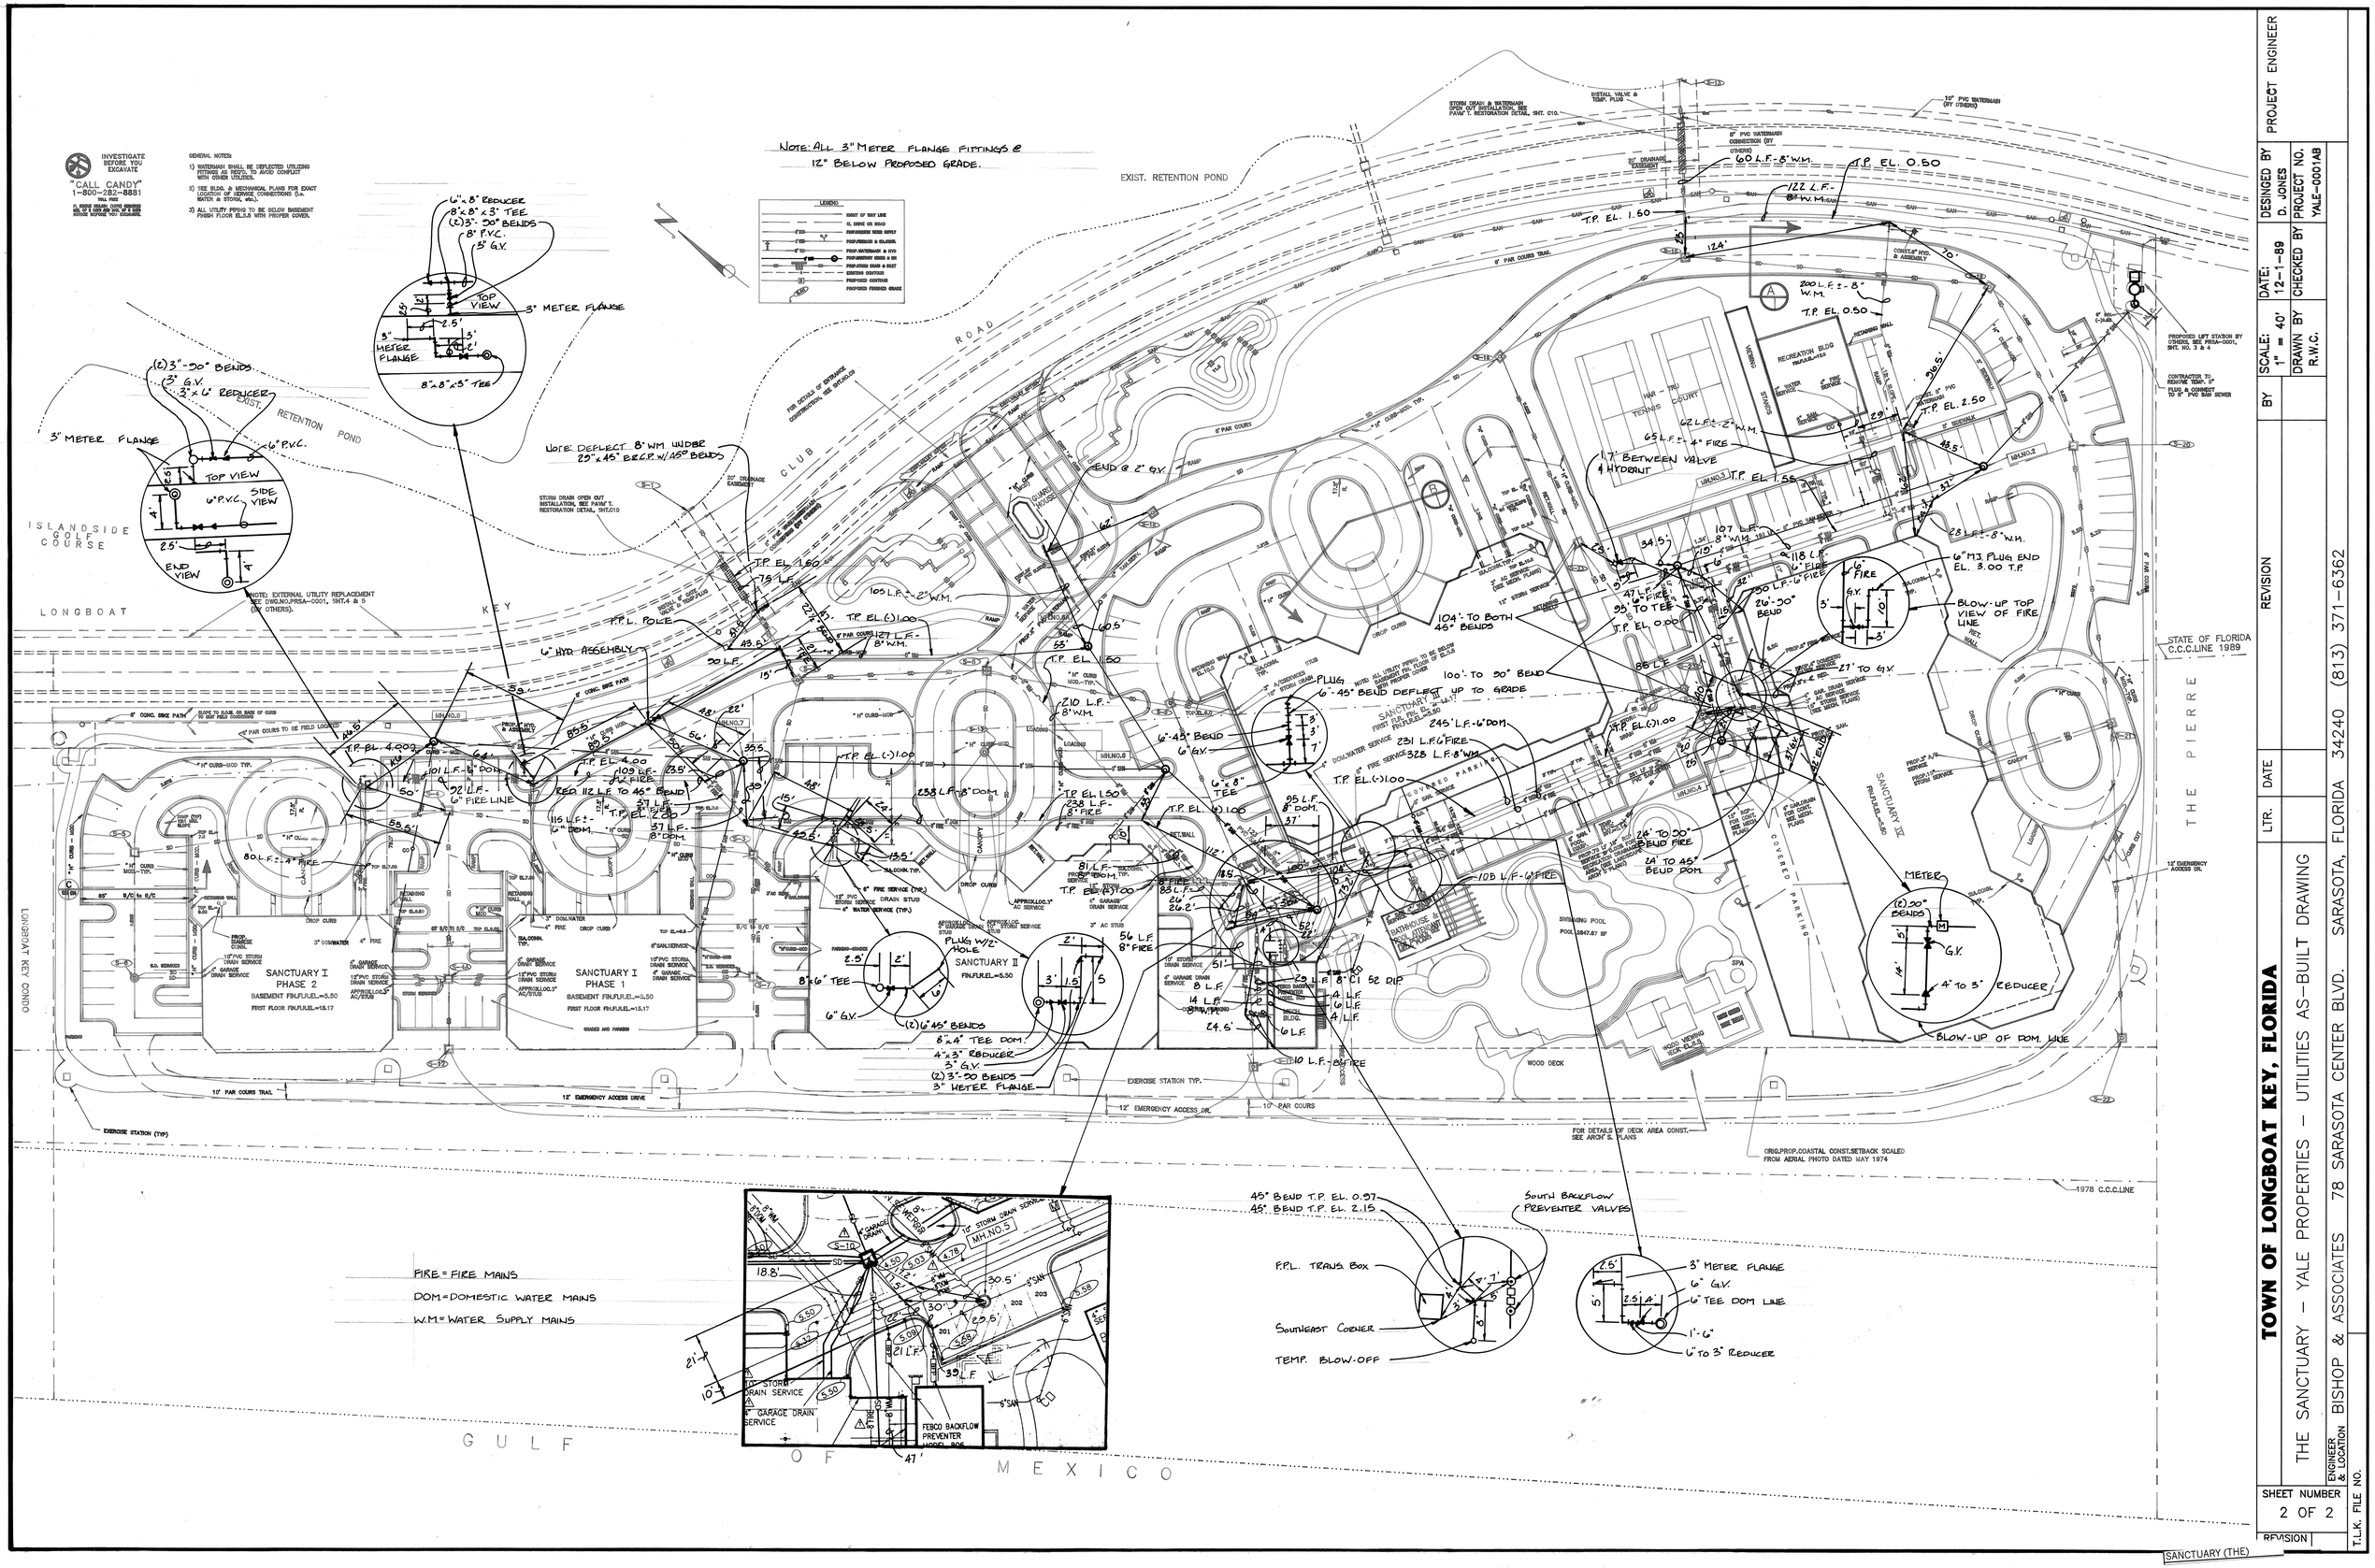
INVESTIGATE BEFORE YOU EXCAVATE
"CALL CANDY" 1-800-282-8811
GENERAL NOTES:
1) WATERMAIN SHALL BE DEFLECTED UTILIZING FITTINGS AS REQ'D. TO AVOID CONFLICT WITH OTHER UTILITIES.
2) (SEE BLDG. & MECHANICAL PLANS FOR EXACT LOCATION OF SERVICE CONNECTIONS (i.e. WATER & STORM, etc.).
3) ALL UTILITY PIPING TO BE BELOW BASEMENT FINISH FLOOR EL.0.0 WITH PROPER COVER.
NOTE: ALL 3" METER FLANGE FITTINGS @ 12" BELOW PROPOSED GRADE.
EXIST. RETENTION POND
LEGEND
ISLANDSIDE GOLF COURSE
LONGBOAT KEY CLUB ROAD
LONGBOAT KEY CONDO
THE PIERRE
GULF OF MEXICO
SANCTUARY I PHASE 2
SANCTUARY I PHASE 1
SANCTUARY II
SANCTUARY III
RECREATION BLDG
TENNIS COURT
SWIMMING POOL
WOOD DECK
COVERED PARKING
STATE OF FLORIDA C.C.C.LINE 1989
1978 C.C.C.LINE
ORIG.PROP.COASTAL CONST.SETBACK SCALED FROM AERIAL PHOTO DATED MAY 1974
FIRE = FIRE MAINS
DOM = DOMESTIC WATER MAINS
W.M. = WATER SUPPLY MAINS
TOWN OF LONGBOAT KEY, FLORIDA
THE SANCTUARY - YALE PROPERTIES - UTILITIES AS-BUILT DRAWING
ENGINEER & LOCATION BISHOP & ASSOCIATES 78 SARASOTA CENTER BLVD. SARASOTA, FLORIDA 34240 (813) 371-6362
PROJECT ENGINEER
DESIGNED BY D. JONES
PROJECT NO. YALE-0001AB
DATE: 12-1-89
CHECKED BY
SCALE: 1" = 40'
DRAWN BY R.W.C.
REVISION
LTR.
DATE
BY
SHEET NUMBER 2 OF 2
T.L.K. FILE NO.
SANCTUARY (THE)