AS-BUILT SANITARY SEWER						
MANHOLE	RIM EL.	INVERTS	FROM - TO	LENGTH	SIZE AND TYPE	GRADE
MH 1	6.10	(-)6.64(W) (-)6.65(S) (-)6.68(NE)				
			MH1 MH2	130.5'	8" C-900	0.40%
MH 2	6.03	(-)6.11(E) (-)6.09(W)				
			MH2 MH3	190'	C-900	0.41%
MH 3	5.18	(-)5.30(SE) (-)5.25(S)				
			MH3 MH4	116'	C-900	0.40%
MH 4	6.00	(-)4.78(N) (-)4.77(W)				
			MH4 MH5	261.5'	C-900	0.40%
MH 5	5.33	(-)3.73(E) (-)3.70(N)				
			MH5 MH6	125'	C-900	0.40%
MH 6	5.83	(-)3.16(N&NE) (-)3.19(S)				
			MH6 MH7	255'	8" C-900	0.41%
MH 7	5.64	(-)2.11(SE) (-)2.08(NW)				
			MH7 MH8	183'	8" C-900	0.42%
MH 8	7.87	(-)1.30(SE) (-)1.18(SW)				
MH 6A	7.07	(-)2.73(S) (-)2.63(N)				
			MH6A MH6	86'	6" C-900	0.50%

INVESTIGATE BEFORE YOU EXCAVATE
"CALL CANDY"
1-800-282-8881
TOLL FREE

GENERAL NOTES:

1) WATERMAIN SHALL BE DEFLECTED UTILIZING FITTINGS AS REQ'D. TO AVOID CONFLICT WITH OTHER UTILITIES.

2) SEE BLDG. & MECHANICAL PLANS FOR EXACT LOCATION OF SERVICE CONNECTIONS (I.e. WATER & STORM, etc.).

3) ALL UTILITY PIPING TO BE BELOW BASEMENT FINISH FLOOR ELS.& WITH PROPER COVER.

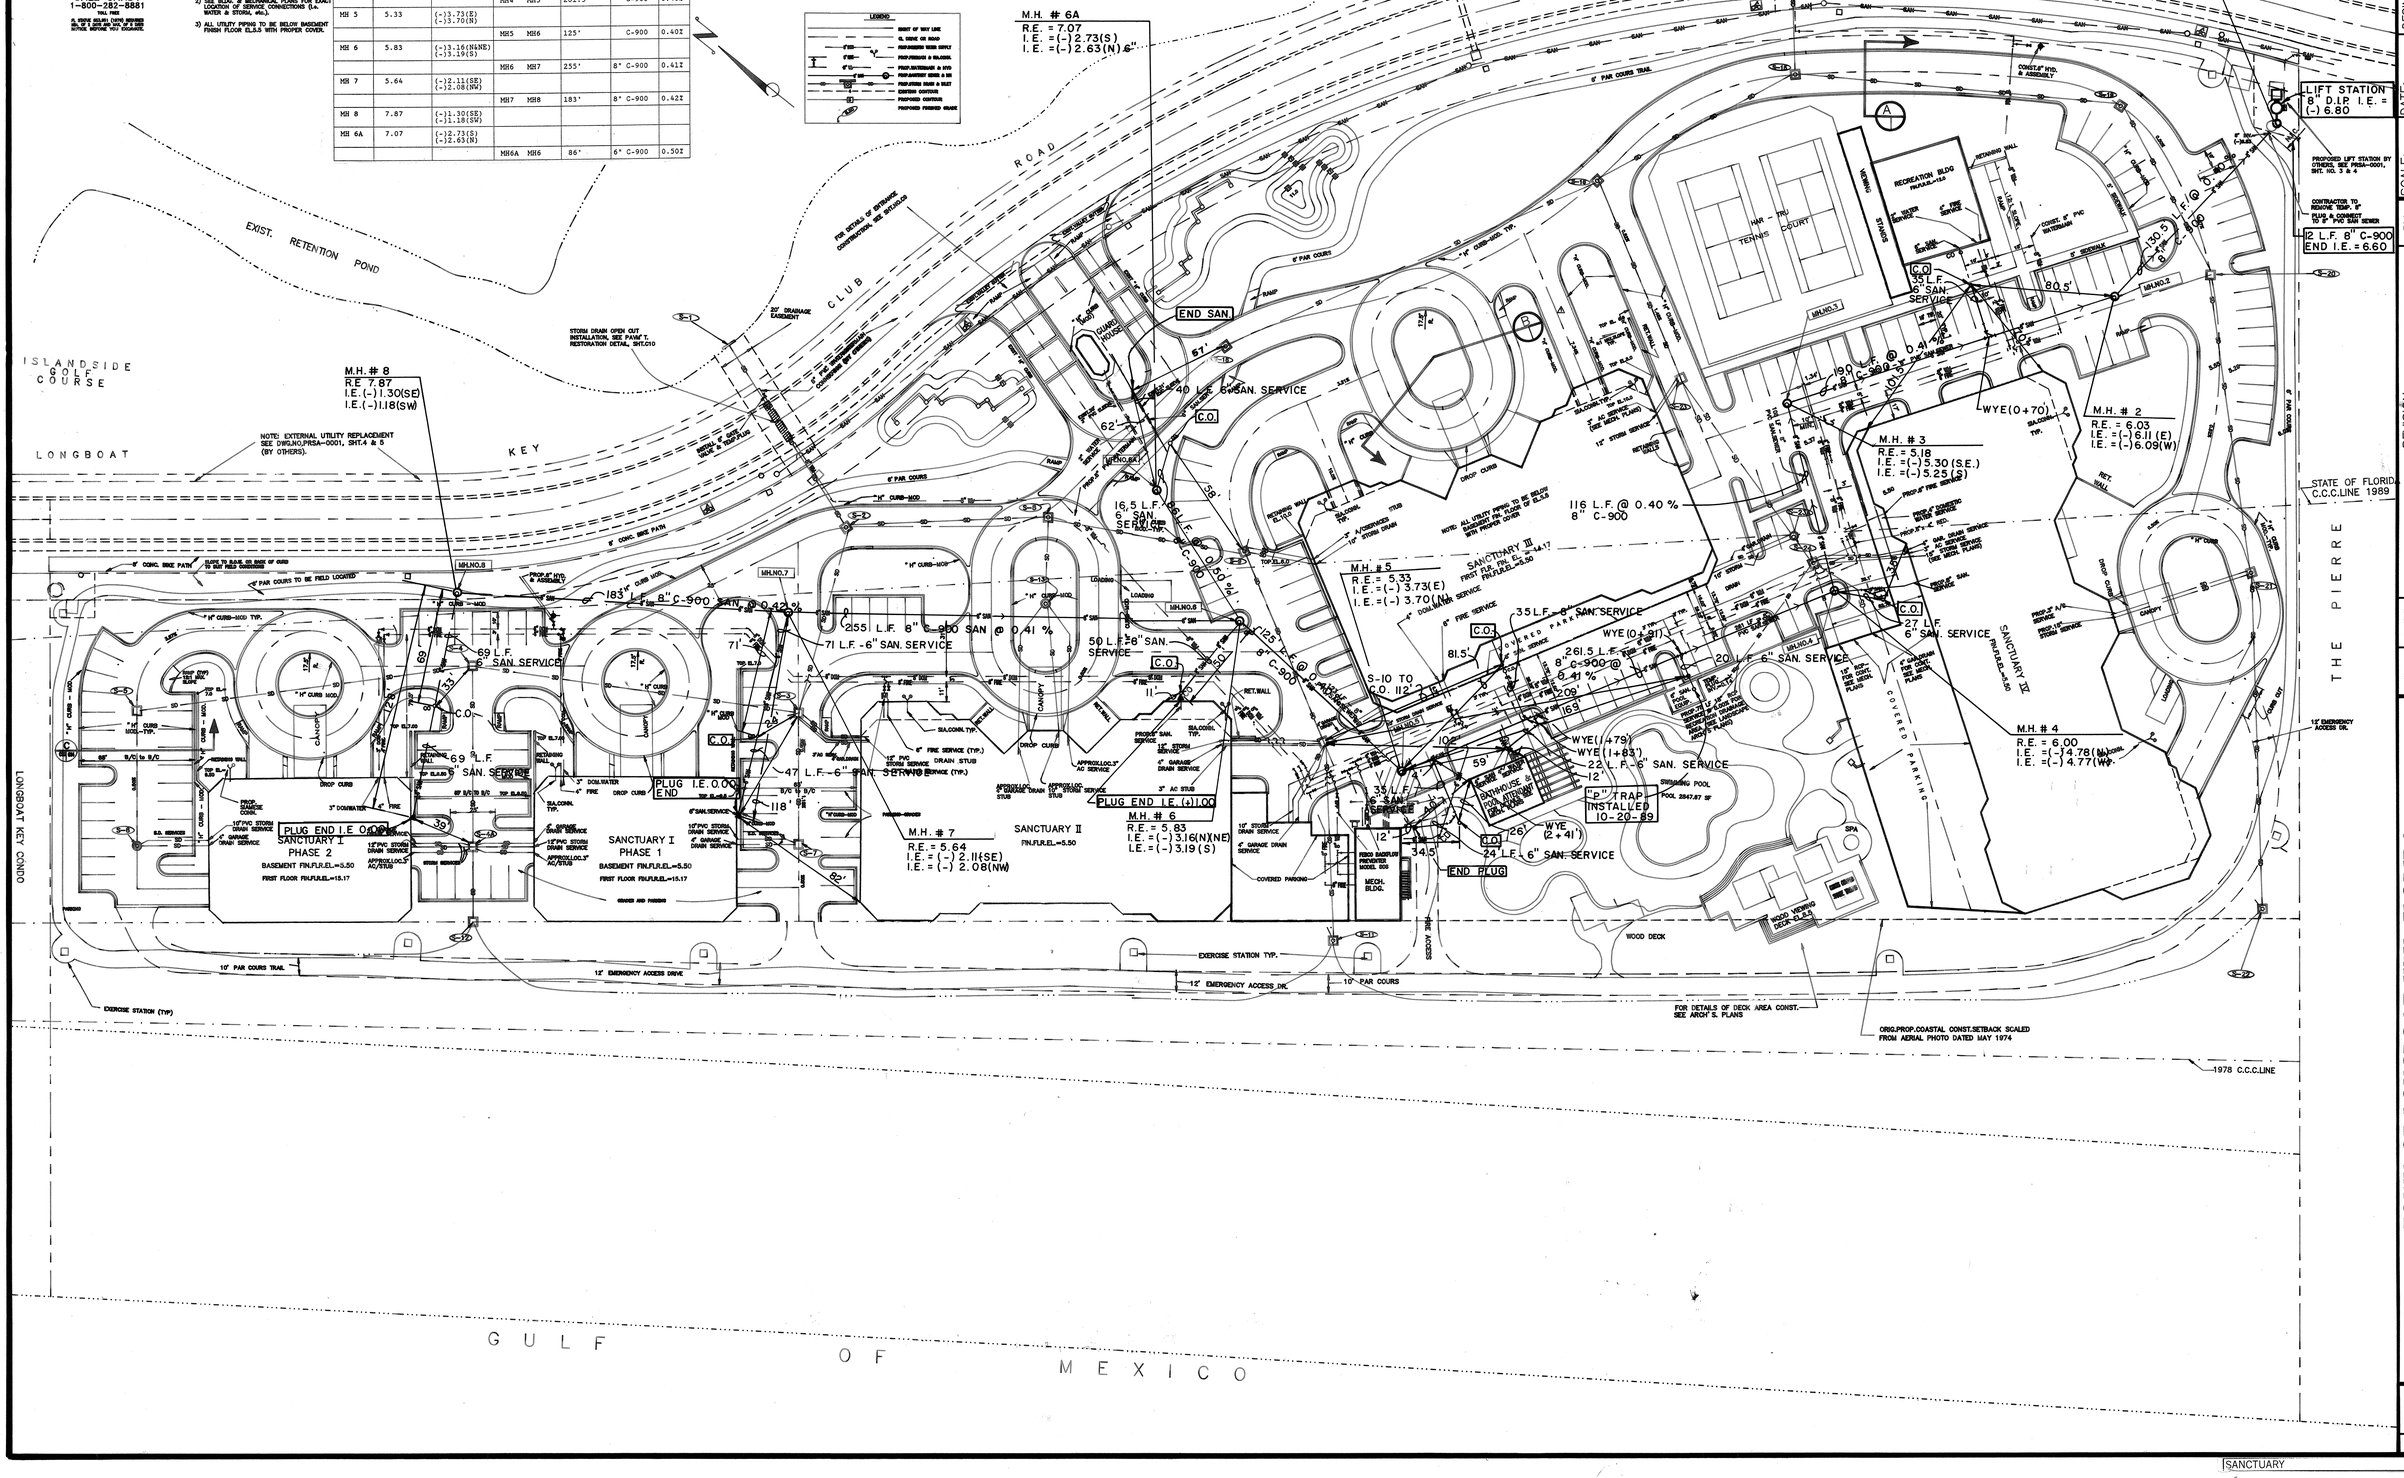

PROJECT ENGINEER	
DESIGNED BY	D. JONES
DATE:	12-1-89
SCALE:	1" = 40'
DRAWN BY	R.W.C./T.D.
CHECKED BY	
PROJECT NO.	YALE-0001AB

REVISION	BY	LTR.	DATE

TOWN OF LONGBOAT KEY, FLORIDA

THE SANCTUARY – YALE PROPERTIES – UTILITIES AS-BUILE DRAWING

ENGINEER & LOCATION: BISHOP & ASSOCIATES 78 SARASOTA CENTER BLVD. SARASOTA, FLORIDA 34240 (813) 371-6362

SHEET NUMBER 1 OF 2

REVISION

T.L.K. FILE NO.

SANCTUARY