INVESTIGATE BEFORE YOU EXCAVATE

"CALL CANDY"
1-800-282-8881
TOLL FREE

FL STATUE 553.851 (1979) REQUIRES MIN. OF 2 DAYS AND MAX. OF 5 DAYS NOTICE BEFORE YOU EXCAVATE.

ALSO NOTIFY:

F.P.& L.	953-7265
TOWN OF LONGBOAT KEY	383-3721
IRRIGATION (ARVIDA)	
DEXTER ARCADI	383-5667
SOUTHERN GAS	365-1595

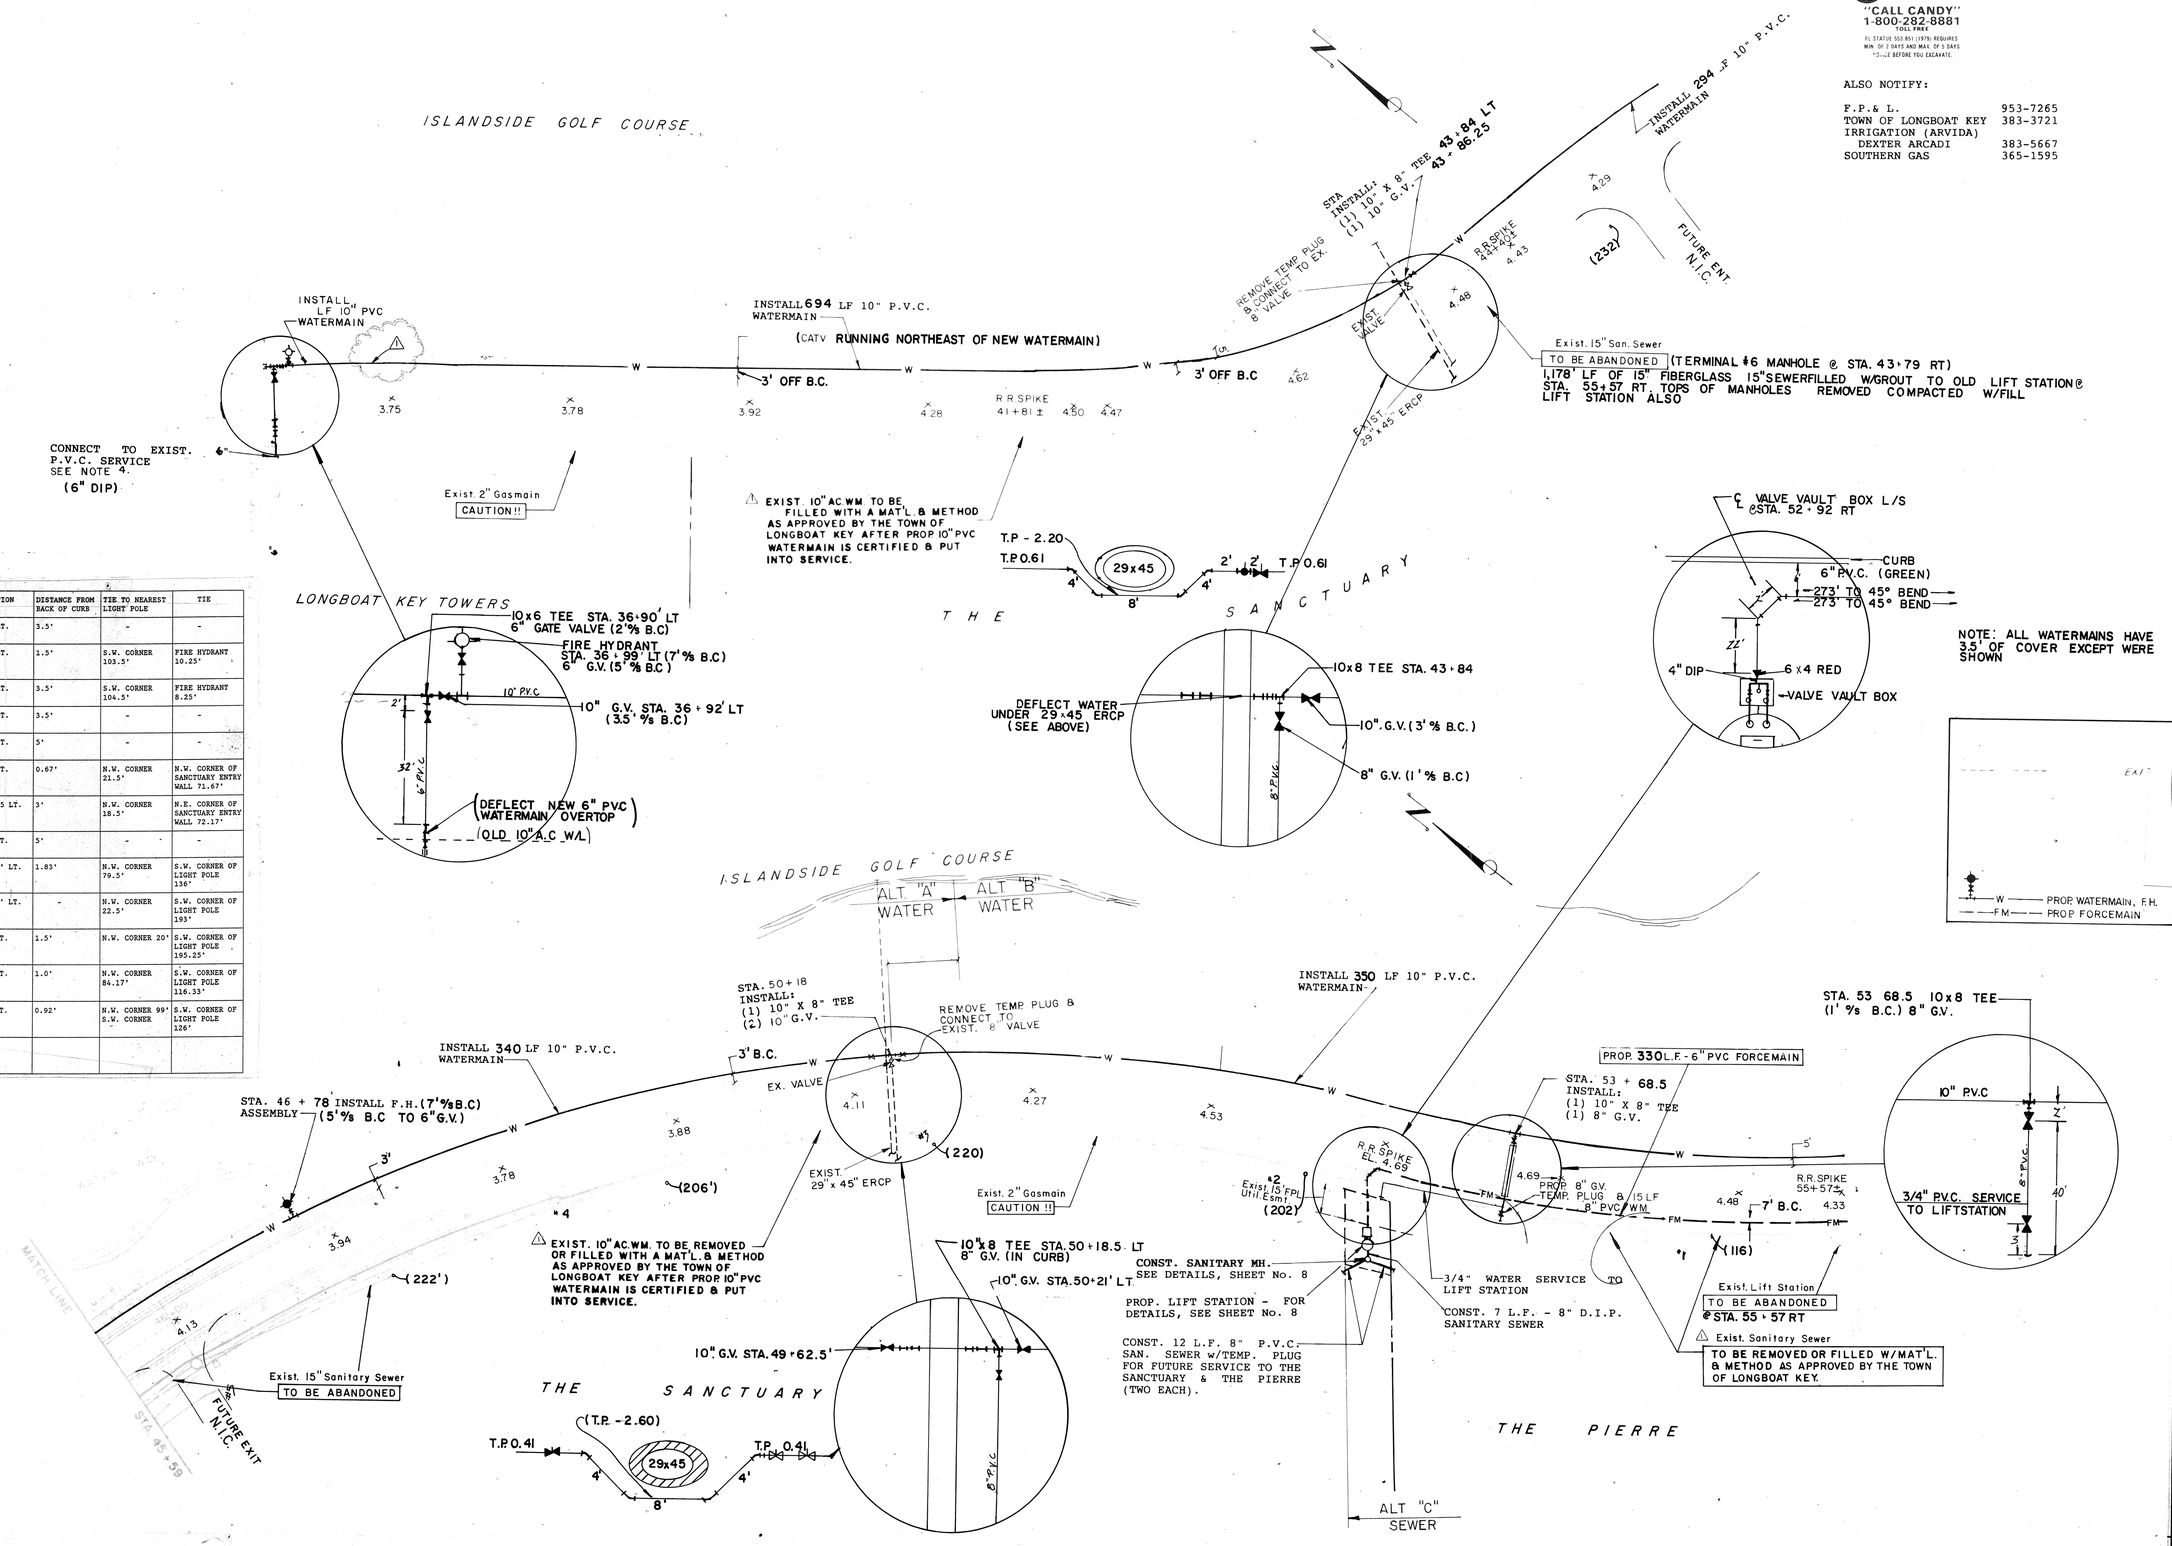

ITEM	STATION	DISTANCE FROM BACK OF CURB	TIE TO NEAREST LIGHT POLE	TIE
10" X 6" TEE	36+90 LT.	3.5'	-	-
6" G.V. TO LONGBOAT KEY TOWERS	36+90 LT.	1.5'	S.W. CORNER 103.5'	FIRE HYDRANT 10.25'
10" G.V.	36+92 LT.	3.5'	S.W. CORNER 104.5'	FIRE HYDRANT 8.25'
10" X 6" TEE TO F.H.	36+99 LT.	3.5'	-	-
6" G.V. TO F.H.	36+99 LT.	5'	-	-
8" G.V. TO N. SANCTUARY	43+84 LT.	0.67'	N.W. CORNER 21.5'	N.W. CORNER OF SANCTUARY ENTRY WALL 71.67'
10" G.V.	43+86.25 LT.	3'	N.W. CORNER 18.5'	N.E. CORNER OF SANCTUARY ENTRY WALL 72.17'
6" G.V. TO FIRE HYDRANT	46+78 LT.	5'	-	-
10" G.V.	49+62.5' LT.	1.83'	N.W. CORNER 79.5'	S.W. CORNER OF LIGHT POLE 136'
8" G.V. TO S. SANCTUARY	50+18.5' LT.	-	N.W. CORNER 22.5'	S.W. CORNER OF LIGHT POLE 193'
10" G.V.	50+21 LT.	1.5'	N.W. CORNER 20'	S.W. CORNER OF LIGHT POLE 195.25'
8" G.V. TO N. PIERRE	53+68 LT.	1.0'	N.W. CORNER 84.17'	S.W. CORNER OF LIGHT POLE 116.33'
8" G.V. TO N. PIERRE	53+68 RT.	0.92'	N.W. CORNER 99' S.W. CORNER	S.W. CORNER OF LIGHT POLE 126'

DESIGNED BY	P.P.
PROJECT NO.	
DATE:	12-01-89
CHECKED BY	
SCALE:	1" = 40'
DRAWN BY	RWC
PROJECT ENGINEER	

DATE	REVISION	BY
12-21	REMOVE FITTING & VALVE	T.O.

TOWN OF LONGBOAT KEY, FLORIDA

LONGBOAT CLUB ROAD - UTILITY REPLACEMENT

ENGINEER BISHOP & ASSOCIATES

LOCATION 78 SARASOTA CENTER BLVD SARASOTA, FL. 34240

T.L.K. FILE NO.

SHEET NUMBER PRSA-0001

AB 2

REVISION

SANCTUARY