ALSO NOTIFY:

F.P.& L.	953-7265
TOWN OF LONGBOAT KEY	383-3721
IRRIGATION (ARVIDA)	
DEXTER ARCADI	383-5667
SOUTHERN GAS	365-1595

INVESTIGATE BEFORE YOU EXCAVATE

"CALL CANDY" 1-800-282-8881 TOLL FREE

FL STATUTE 553.851 (1978) REQUIRES MIN. OF 2 DAYS AND MAX. OF 5 DAYS NOTICE BEFORE YOU EXCAVATE.

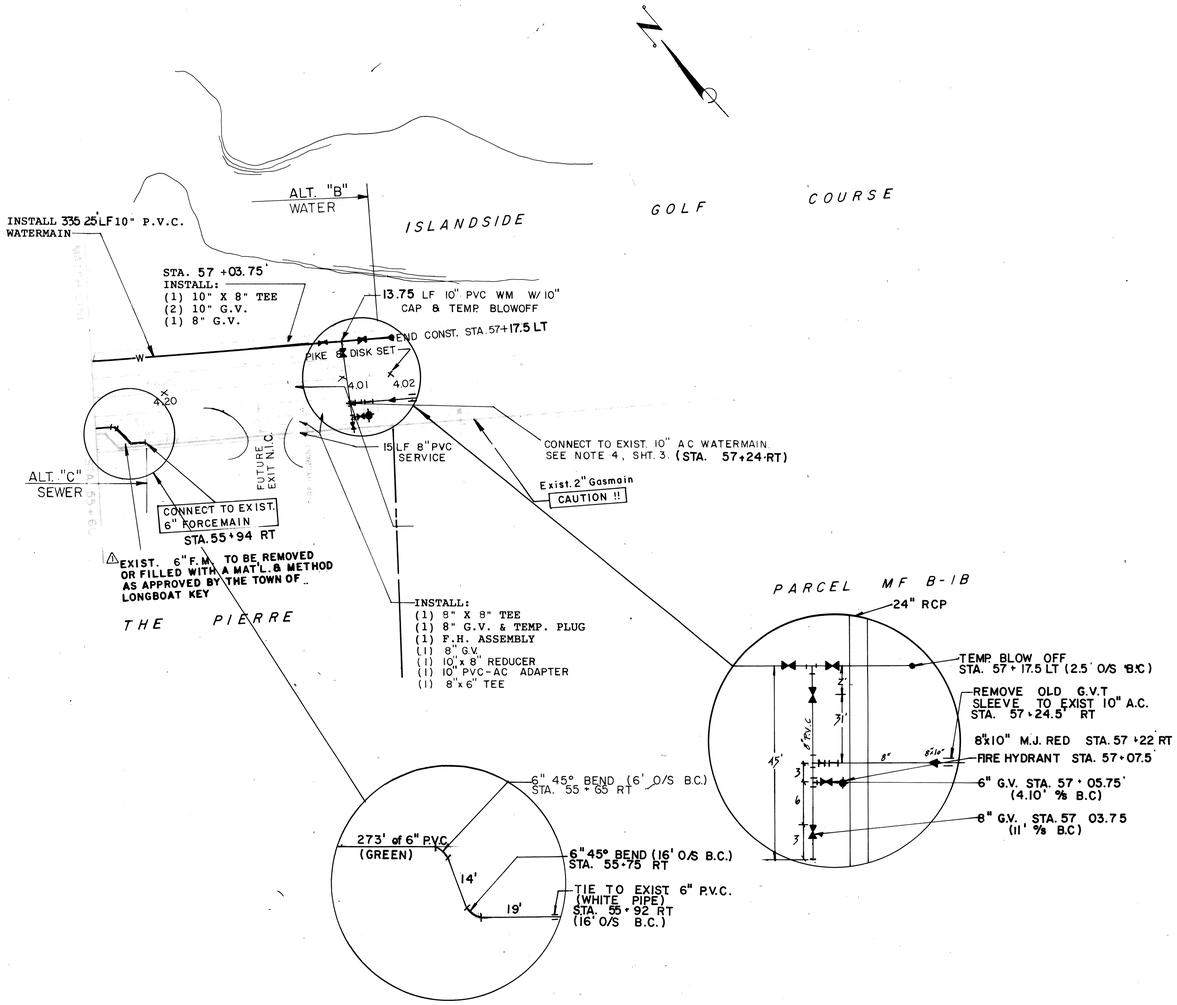

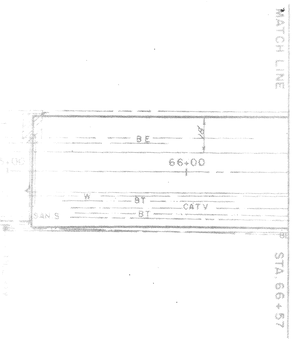

ITEM	STATION	DISTANCE FROM BACK OF CURB	TIE TO NEAREST LIGHT POLE	TIE TO NEAREST FIRE HYDRANT
10" G.V.	57+1.5 LT.	2.5'	S.W. CORNER 40.33'	35.67'
8" G.V. TO S. PIERRE	57+03.75 LT.	0.5'	S.W. CORNER 42.67'	33.5'
8" G.V. TO S. PIERRE	57+03.75 LT.	11.0'	S.W. CORNER 63.5'	7.25'
6" G.V. TO FIRE HYDRANT	57+05.75 RT.	4.1'	-	-
10" G.V.	57+06.5 LT.	2.5'	S.W. CORNER 45.17'	35.33'
BLOWOFF	57+17.5 LT.	2.5'	S.W. CORNER 56.5'	36.33'

LEGEND

- RIGHT OF WAY LINE
- WATERMAIN EXIST.
- SAN. SANITARY SEWER
- STORM DRAIN
- FORCEMAIN
- BT BURIED TELEPHONE
- BE BURIED ELECTRIC
- CATV BURIED CABLE TV
- GAS GASMAIN
- W PROP. FIRMAN, F.H.
- F PROP. FORCEMAN

PROJECT ENGINEER

DESIGNED BY - P.P. | PROJECT NO.

DATE: 12-01-89 | CHECKED BY

SCALE: 1"= 40' | DRAWN BY RWC

BY	REVISION	T.R.	DATE

SARASOTA, FL. 34240

Structures

TOWN OF LONGBOAT KEY, FLOR

LONGBOAT CLUB ROAD - UTILITY REPLACEMENT

ENGINEER & SURVEYOR: BISHOP & ASSOCIATES | 78 SARASOTA

T.L.K. FILE NO.

SHEET NUMBER PRSA-0001 AB 3

REVISION

ISANCTUARY