


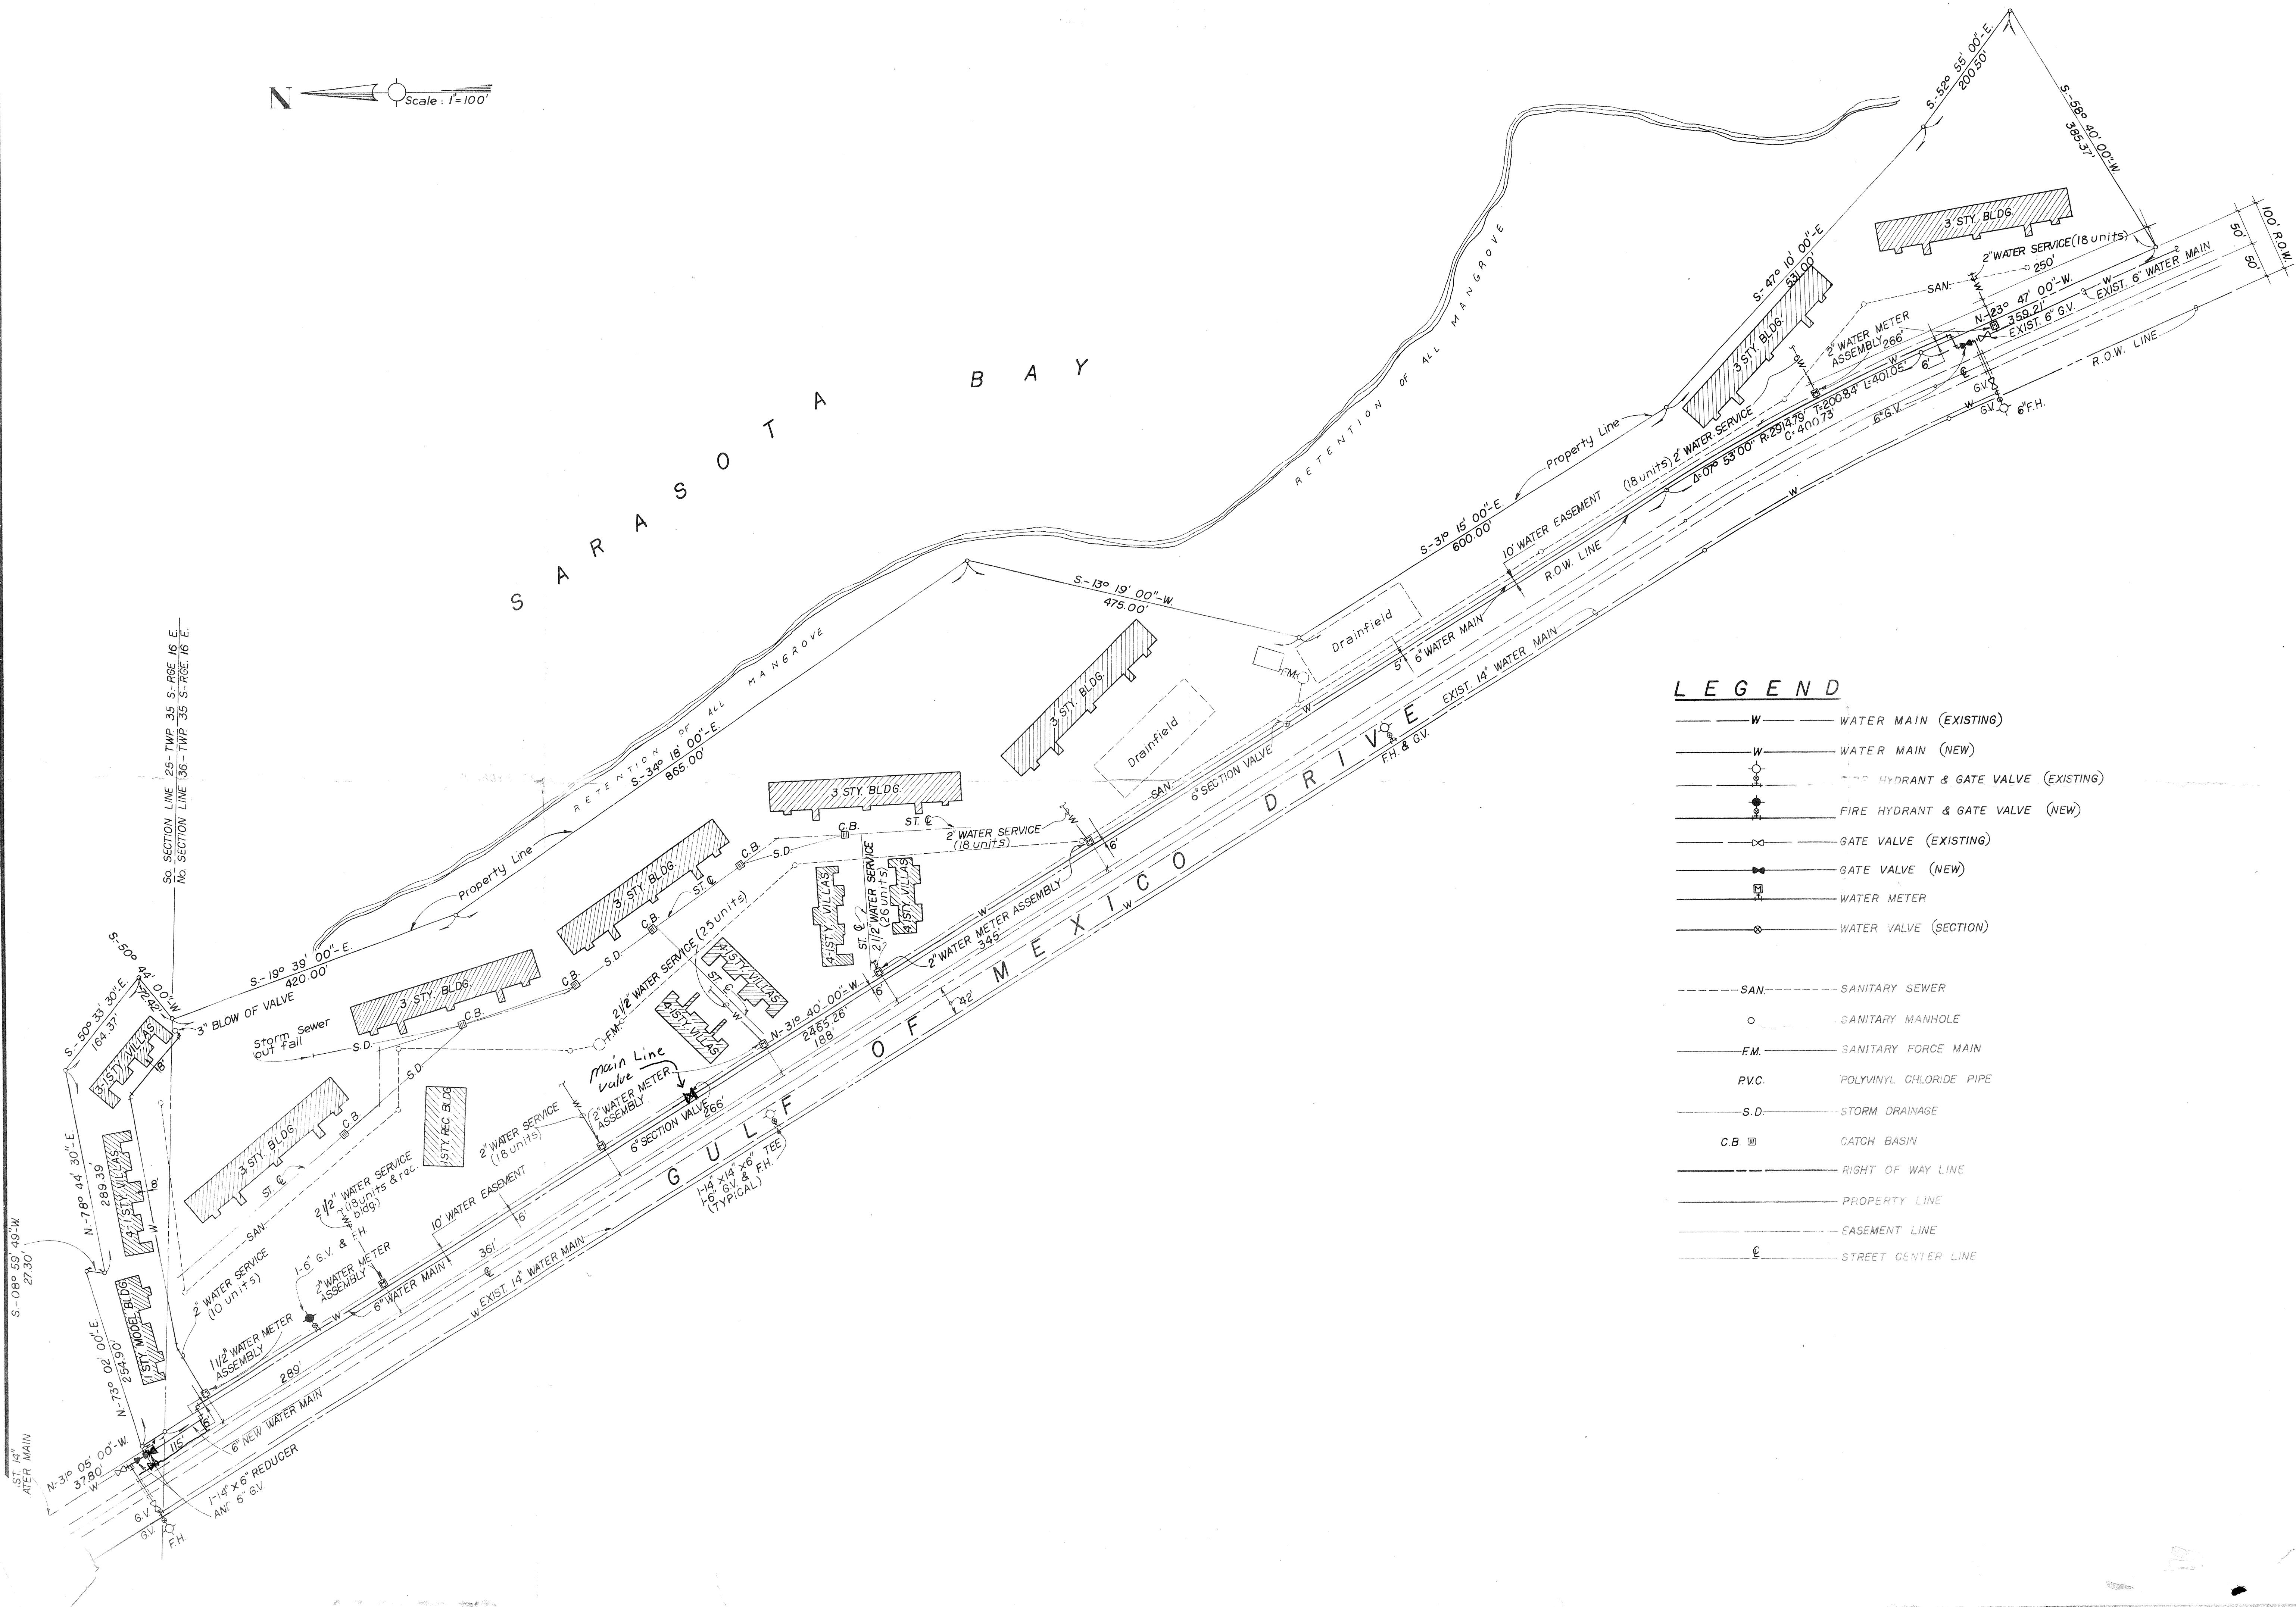

SARASOTA BAY



LEGEND

- W — WATER MAIN (EXISTING)
- W — WATER MAIN (NEW)
- — FIRE HYDRANT & GATE VALVE (EXISTING)
- — FIRE HYDRANT & GATE VALVE (NEW)
- X — GATE VALVE (EXISTING)
- X — GATE VALVE (NEW)
- M — WATER METER
- V — WATER VALVE (SECTION)
- SAN --- SANITARY SEWER
- — SANITARY MANHOLE
- F.M. — SANITARY FORCE MAIN
- P.V.C. — POLYVINYL CHLORIDE PIPE
- S.D. — STORM DRAINAGE
- C.B. — CATCH BASIN
- RIGHT OF WAY LINE
- PROPERTY LINE
- EASEMENT LINE
- E — STREET CENTER LINE

PROJECT ENGINEER		DESIGNED BY		DATE	
G.V.M.		G.V.M.		DEC. 26, 73	
PROJECT NO.		CHECKED BY		SCALE	
J.J. CLARET P.E.		G.V.M.		1" = 100'	
FLA. REG. NO. 11013		P.A. & F.A.		DRAWN BY	
				R.A. & F.A.	
REVISION		BY		DATE	
TOWN OF LONGBOAT KEY, FLORIDA		L.T.R.		DATE	
SHEET NUMBER		ENGINEER'S LOCATION		FLORIDA	
2		J.J. CLARET		SARASOTA, FLORIDA	
REVISION		400 HARDING CIRCLE		SARASOTA, FLORIDA	