

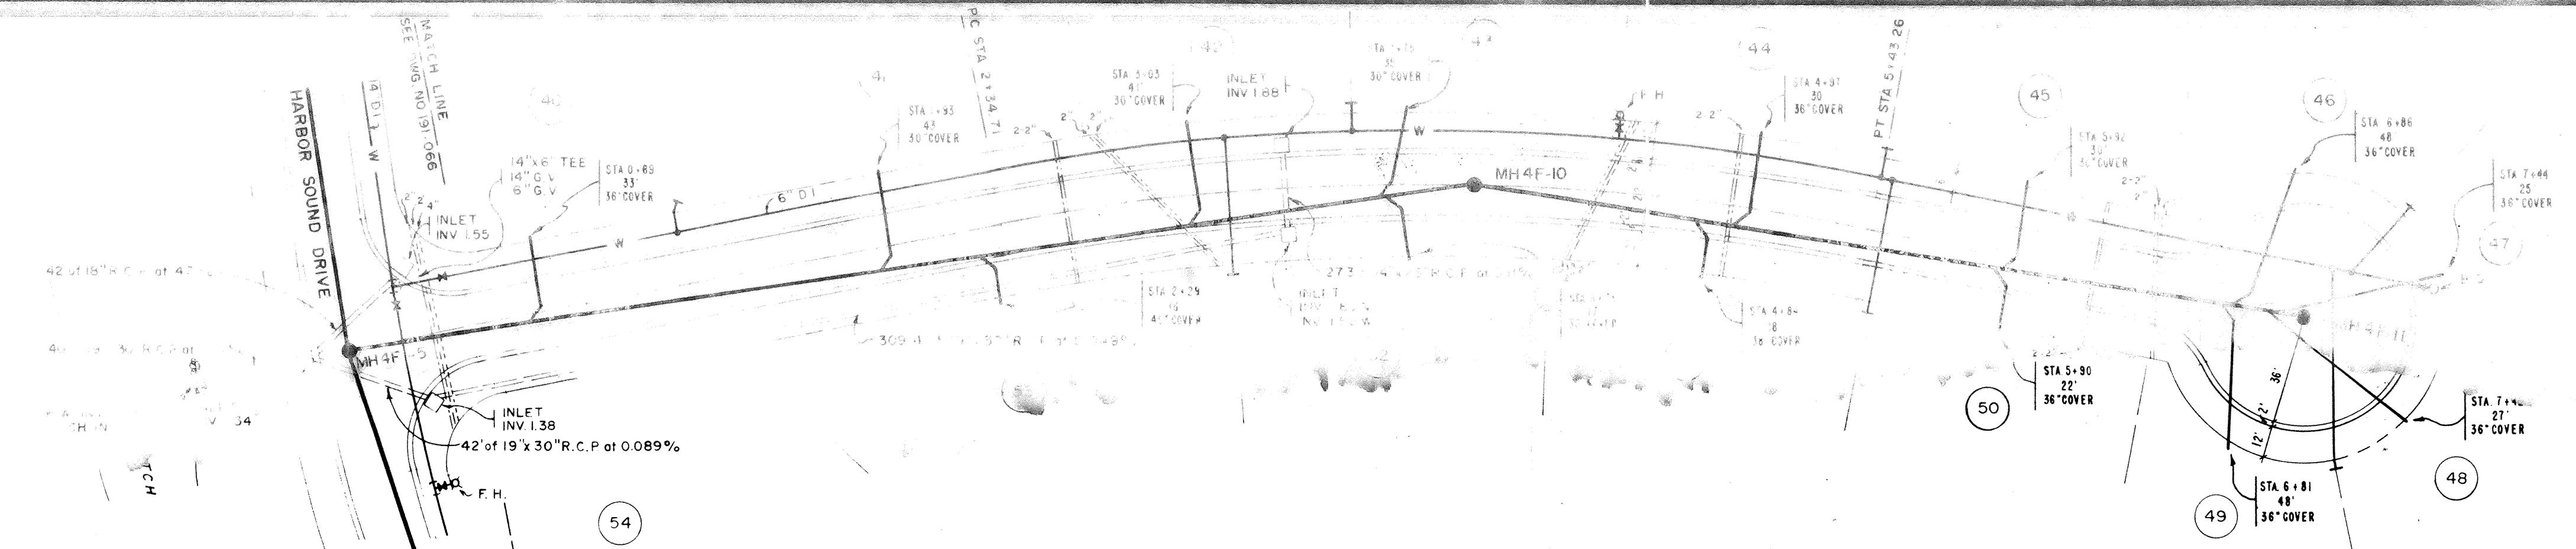


100 x 1/4

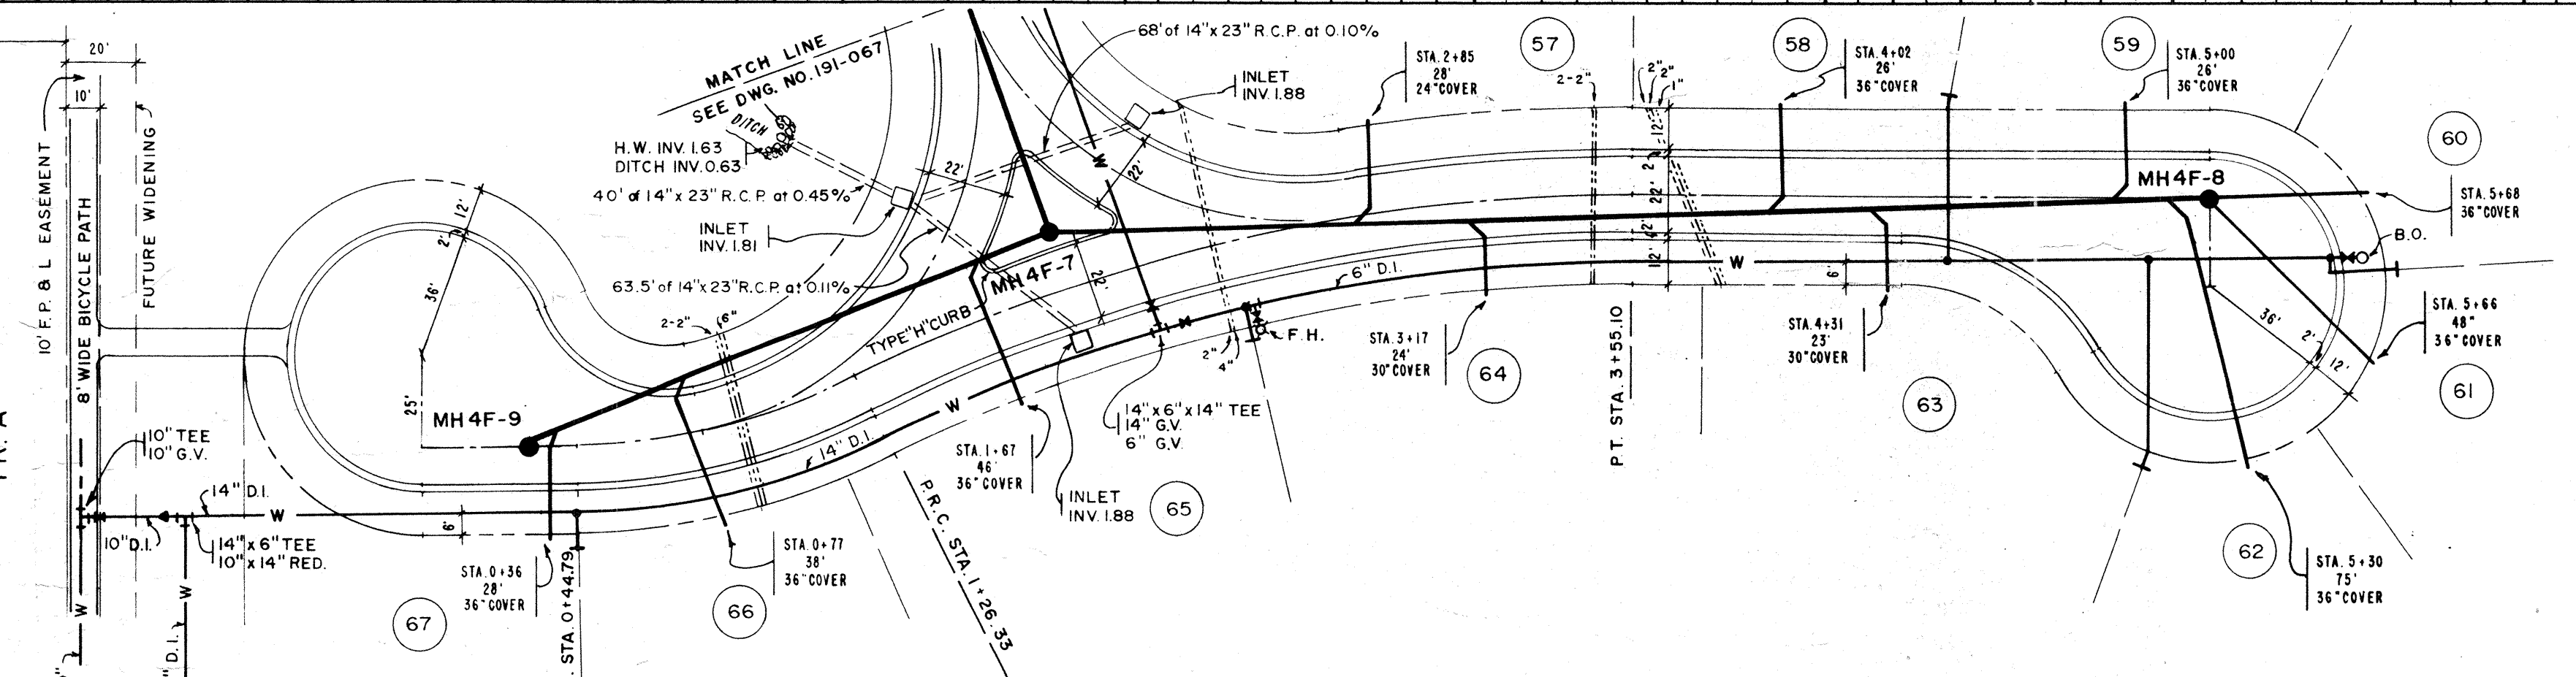


HARBOR POINT ROAD

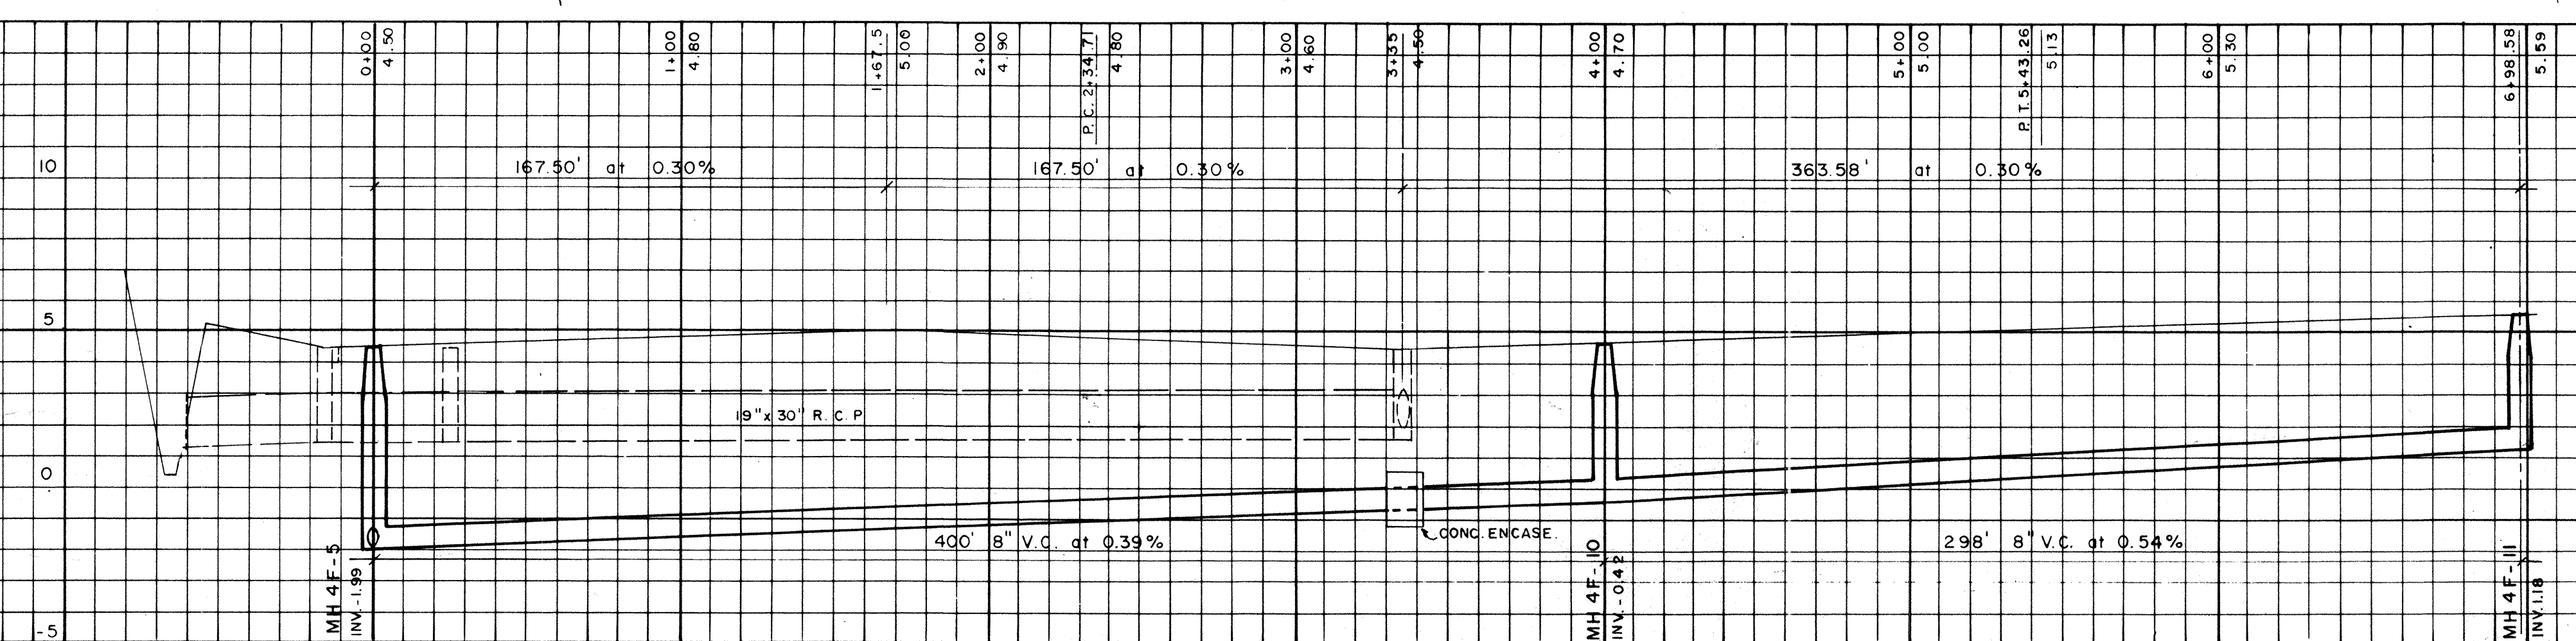

LEGEND
 General Telephone
 Storer Television
 Fla. Power & Light Co.
 Irrigation

HARBOR COVE CIRCLE

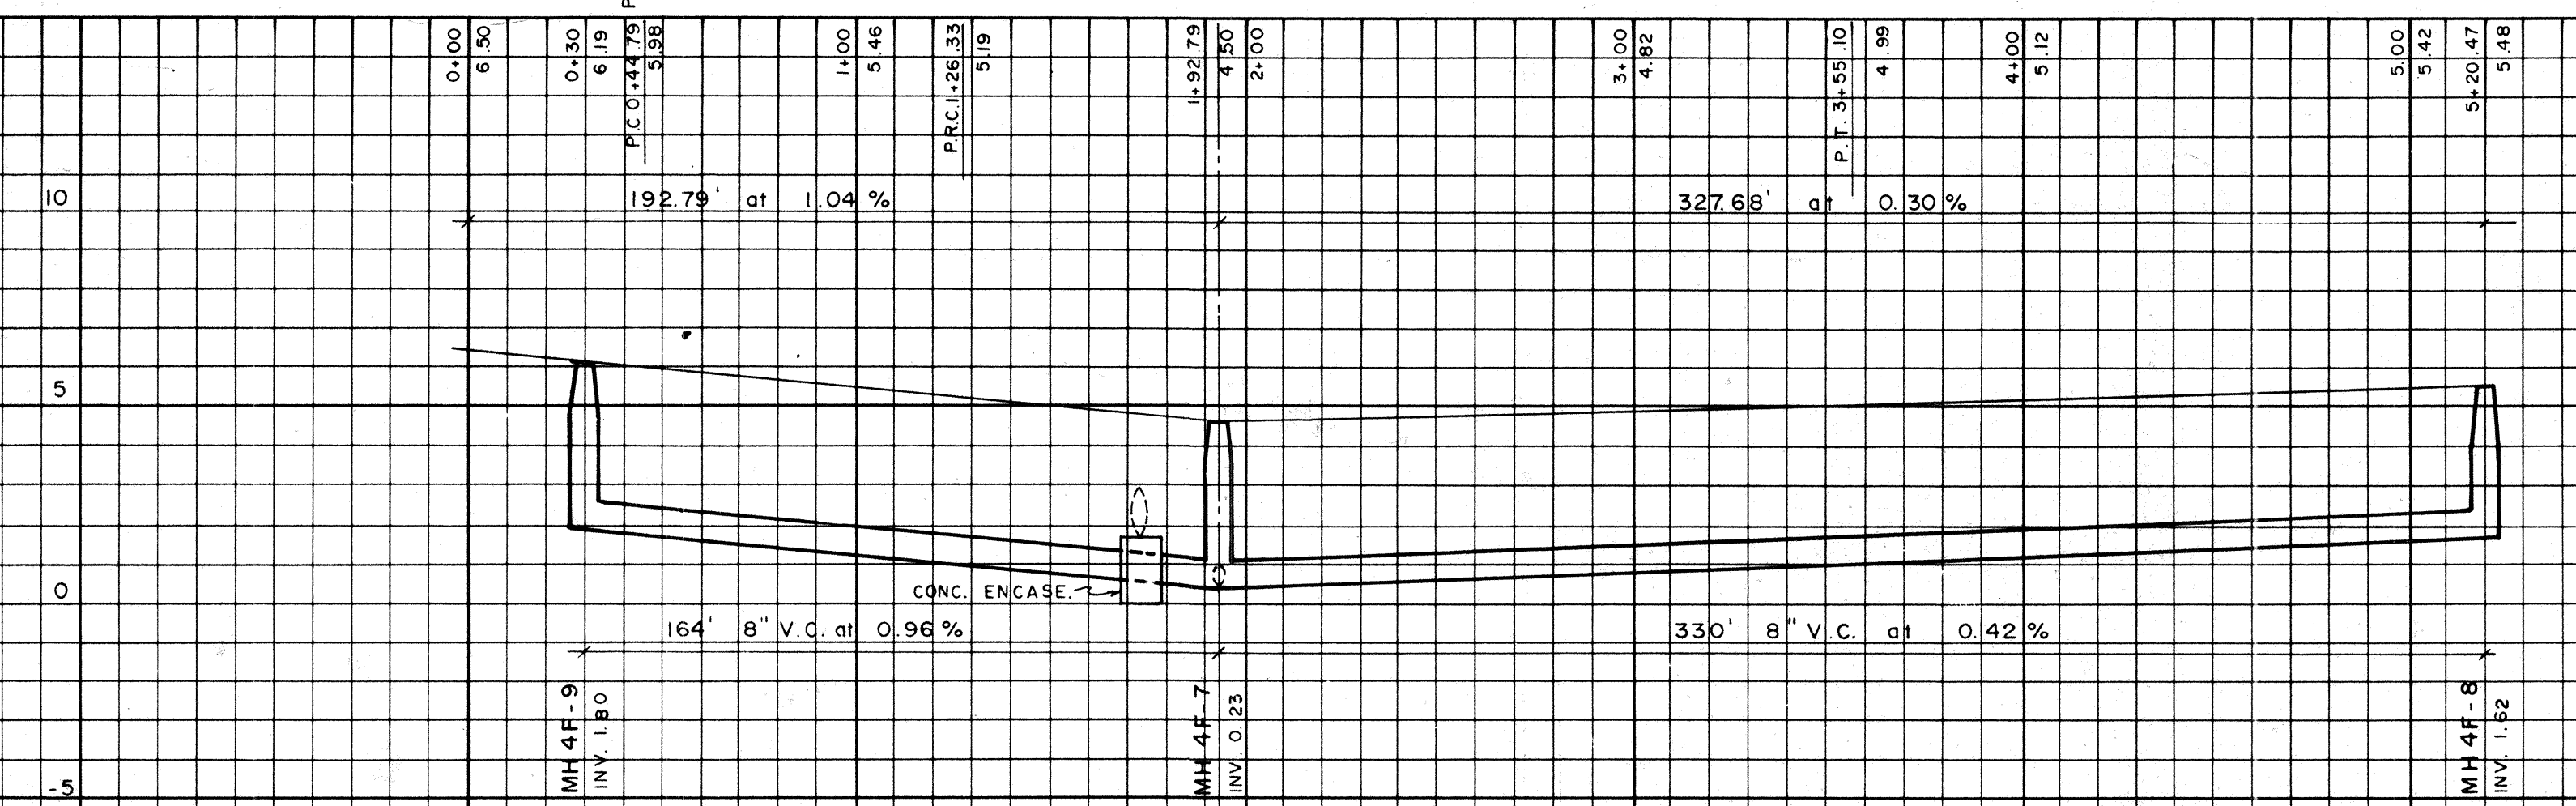

DESIGNED BY PROJECT ENGINEER
 DATE: 10-4-40
 CHECKED BY PROJECT NO.
 SCALE: HORIZ. 1" = 40'
 VERT. 1" = 4'
 DRAWN BY N. B.
 REVISION
 L.T.R. DATE
 TOWN OF LONGBOAT KEY FLORIDA
 ARVIDA CORPORATION
 BAY ISLES UNIT
 SHEET NO. 1217-373
 REVISION

HARBOR POINT ROAD
 HARBOR COVE CIRCLE
 (BAY ISLES UNIT I (HARBOR SECTION))