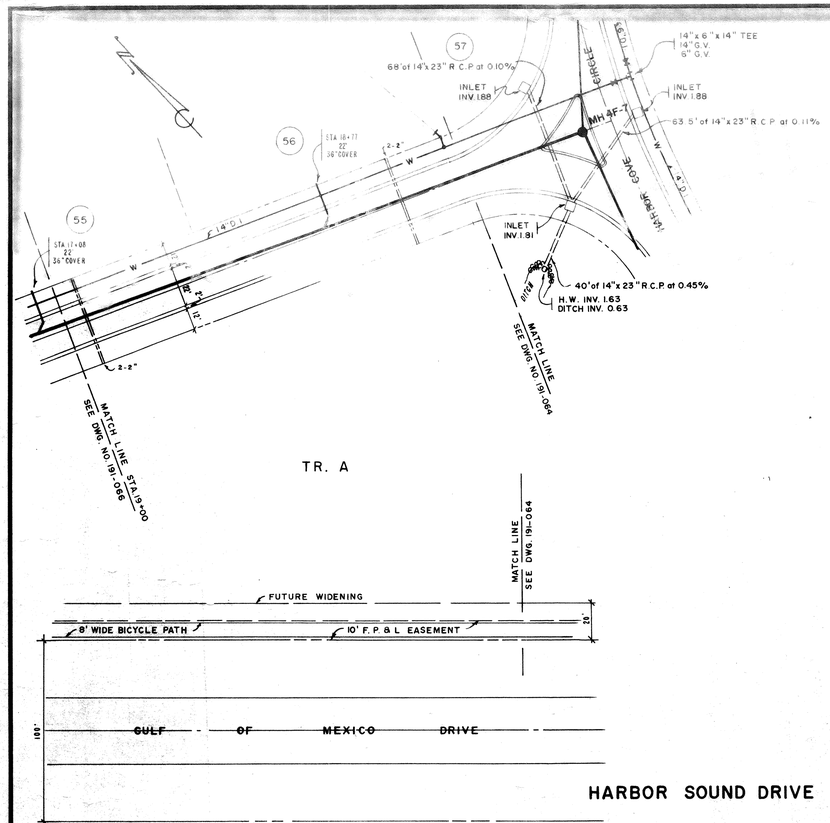

HARBOR SOUND DRIVE

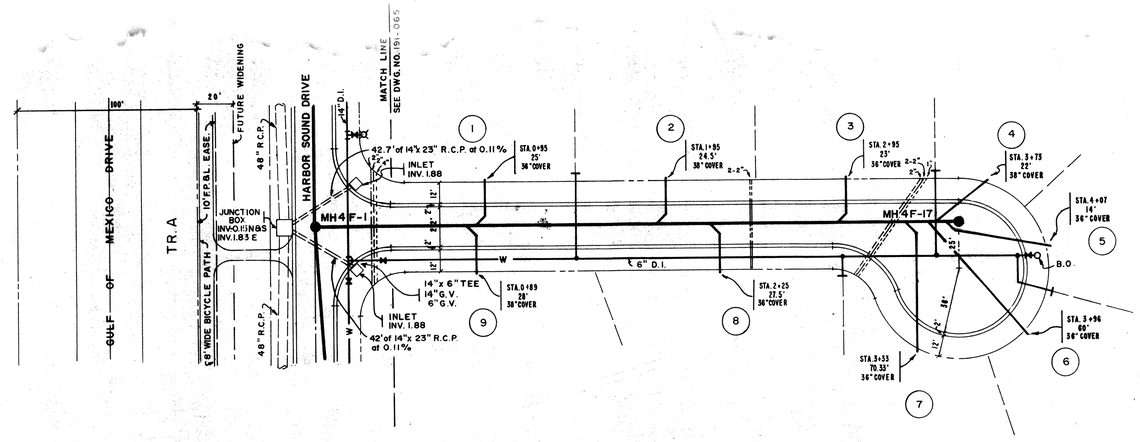

HARBOR GATE WAY

LEGEND
General Telephone
Storer Television
Fla Power & Light Co
Irrigation

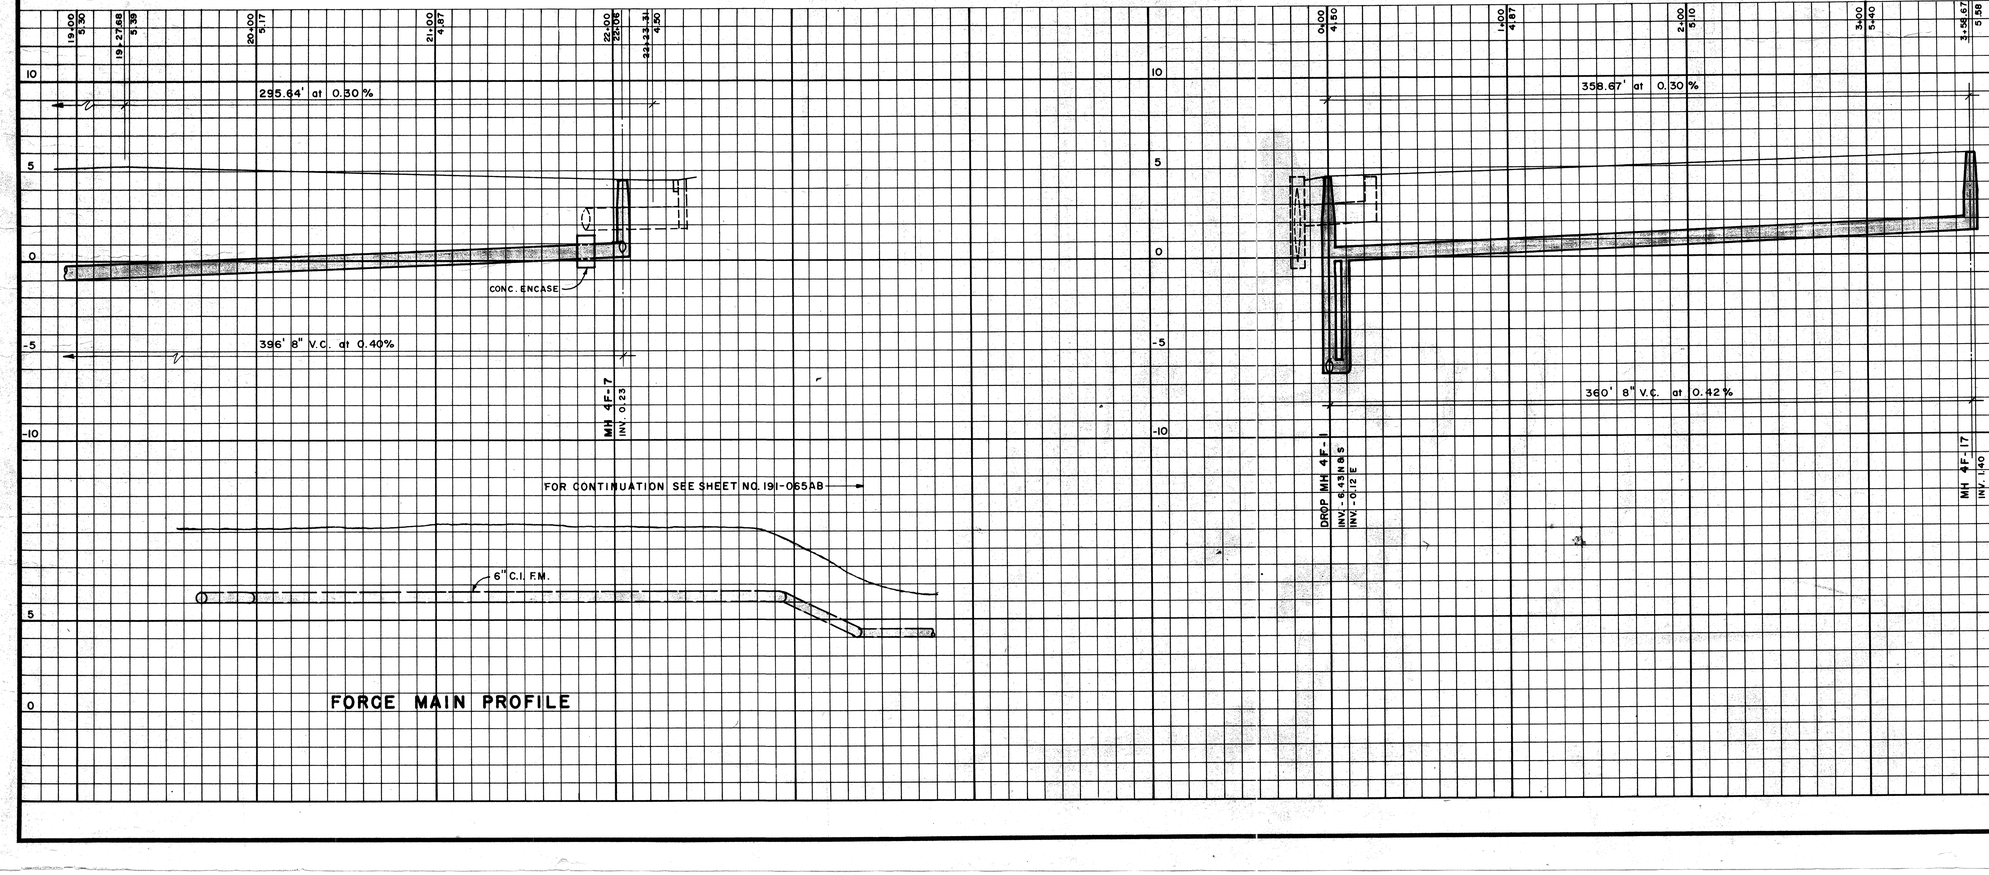

FORCE MAIN PROFILE

HARBOR SOUND DRIVE
HARBOR GATE WAY

DESIGNED BY	PROJECT ENGINEER
DATE: 10-4-78	
SCALE: HORIZ. 1" = 40' VERT. 1" = 4'	
CHECKED BY	PROJECT NO.
DRAWN BY H. B.	

LTR.	DATE	REVISION	BY

TOWN OF LONGBOAT KEY, FLORIDA

ARVIDA CORPORATION
BAY ISLES UNIT NO. 1
SEWAGE COLLECTION

ENGINEER & LOCATION: BENNETT & BISHOP, INC. - CONSULTING ENGINEERS & SURVEYORS - 4509 BEE RIDGE RD. SARASOTA, FLORIDA

T.L.K. FILE NO.

SHEET NUMBER 77-E S

REVISION

HARBOR SOUND DRIVE
HARBOR GATE WAY

3-1817-376

191-067AB