

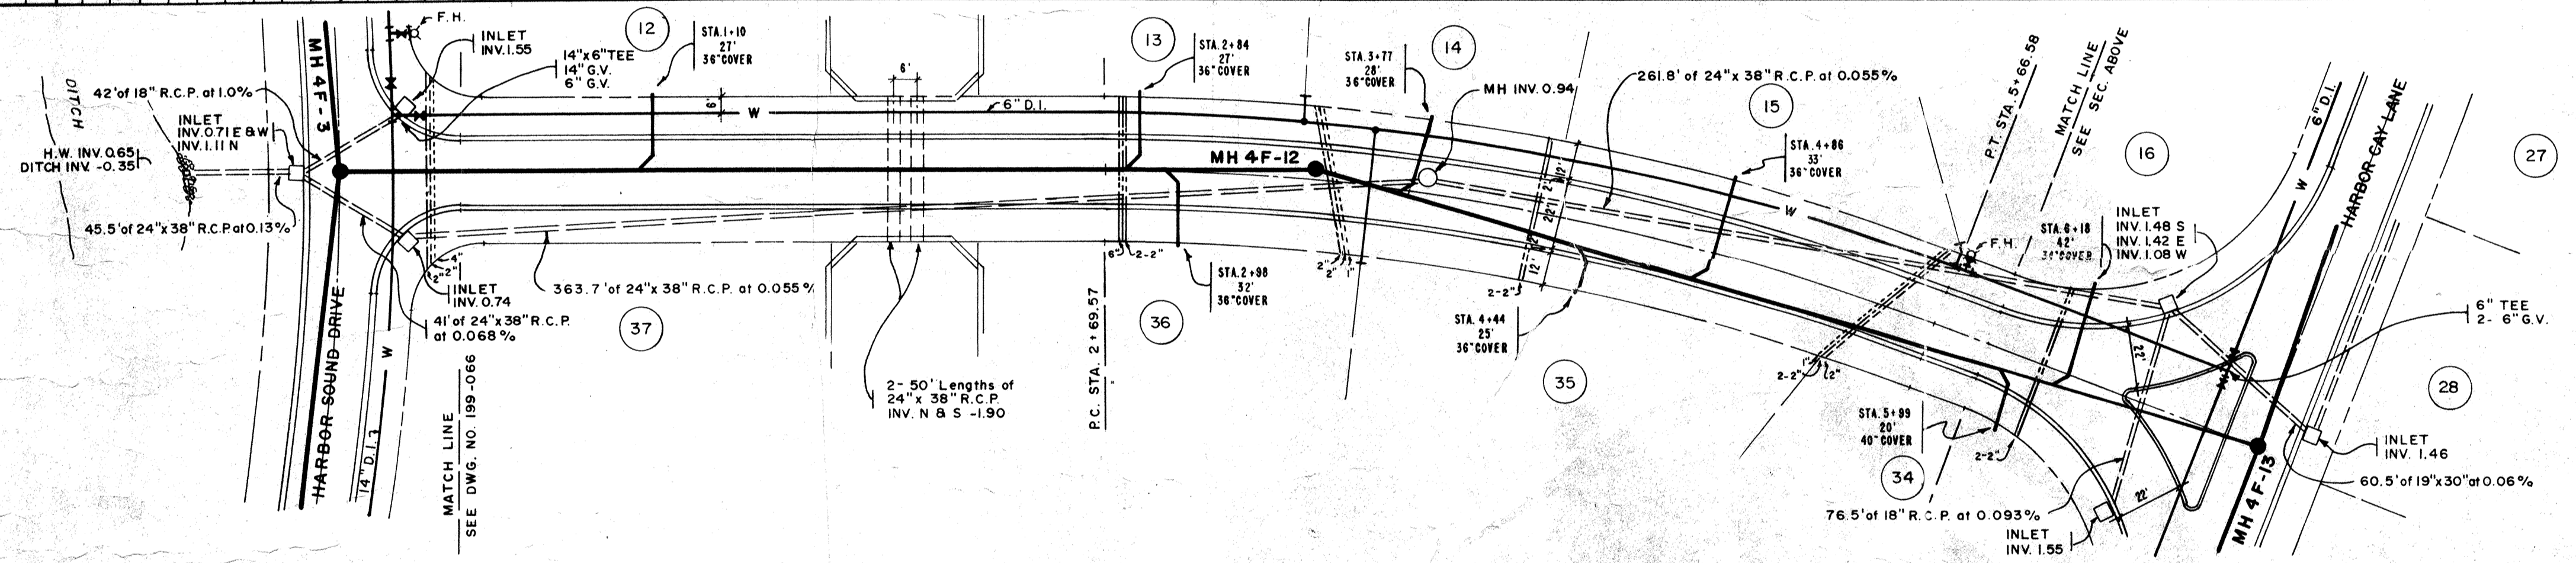


HARBOR CAY LA.

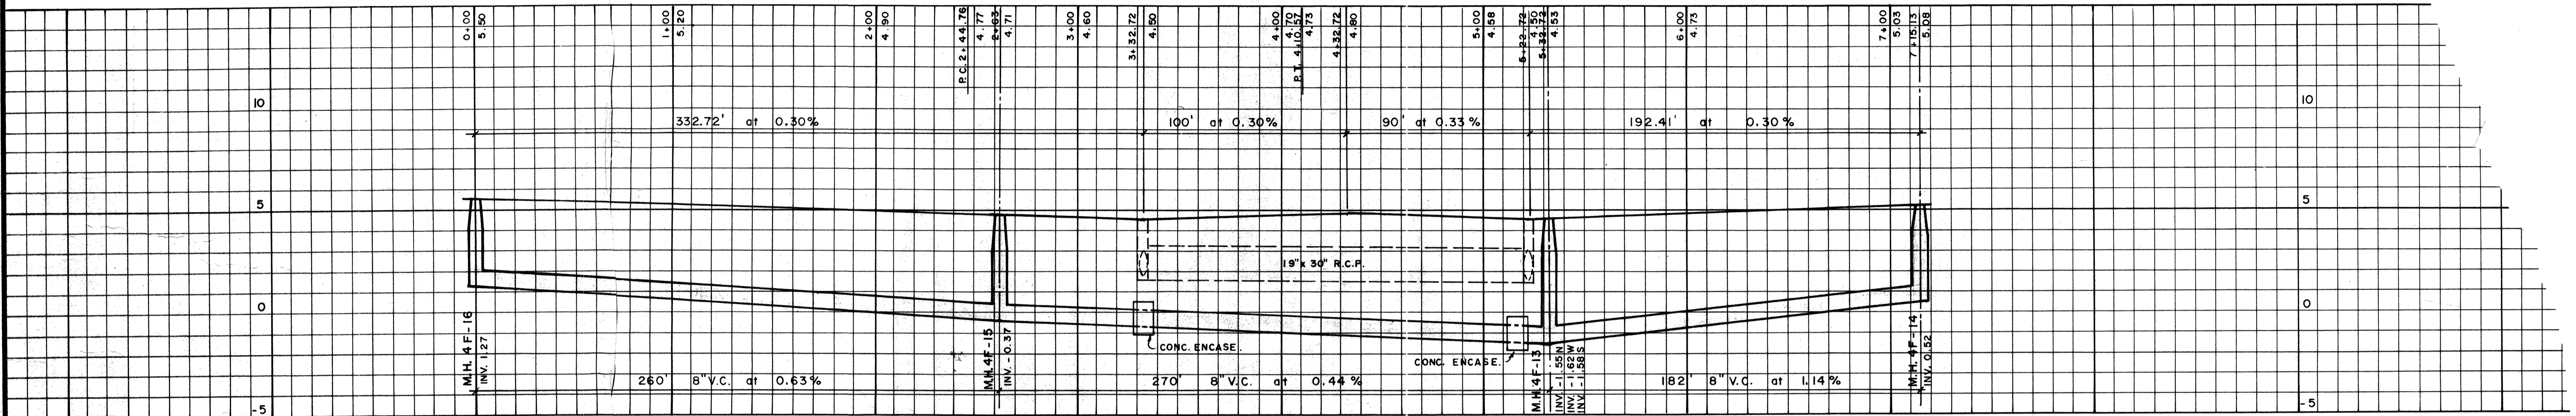

HARBOR CAY DRIVE

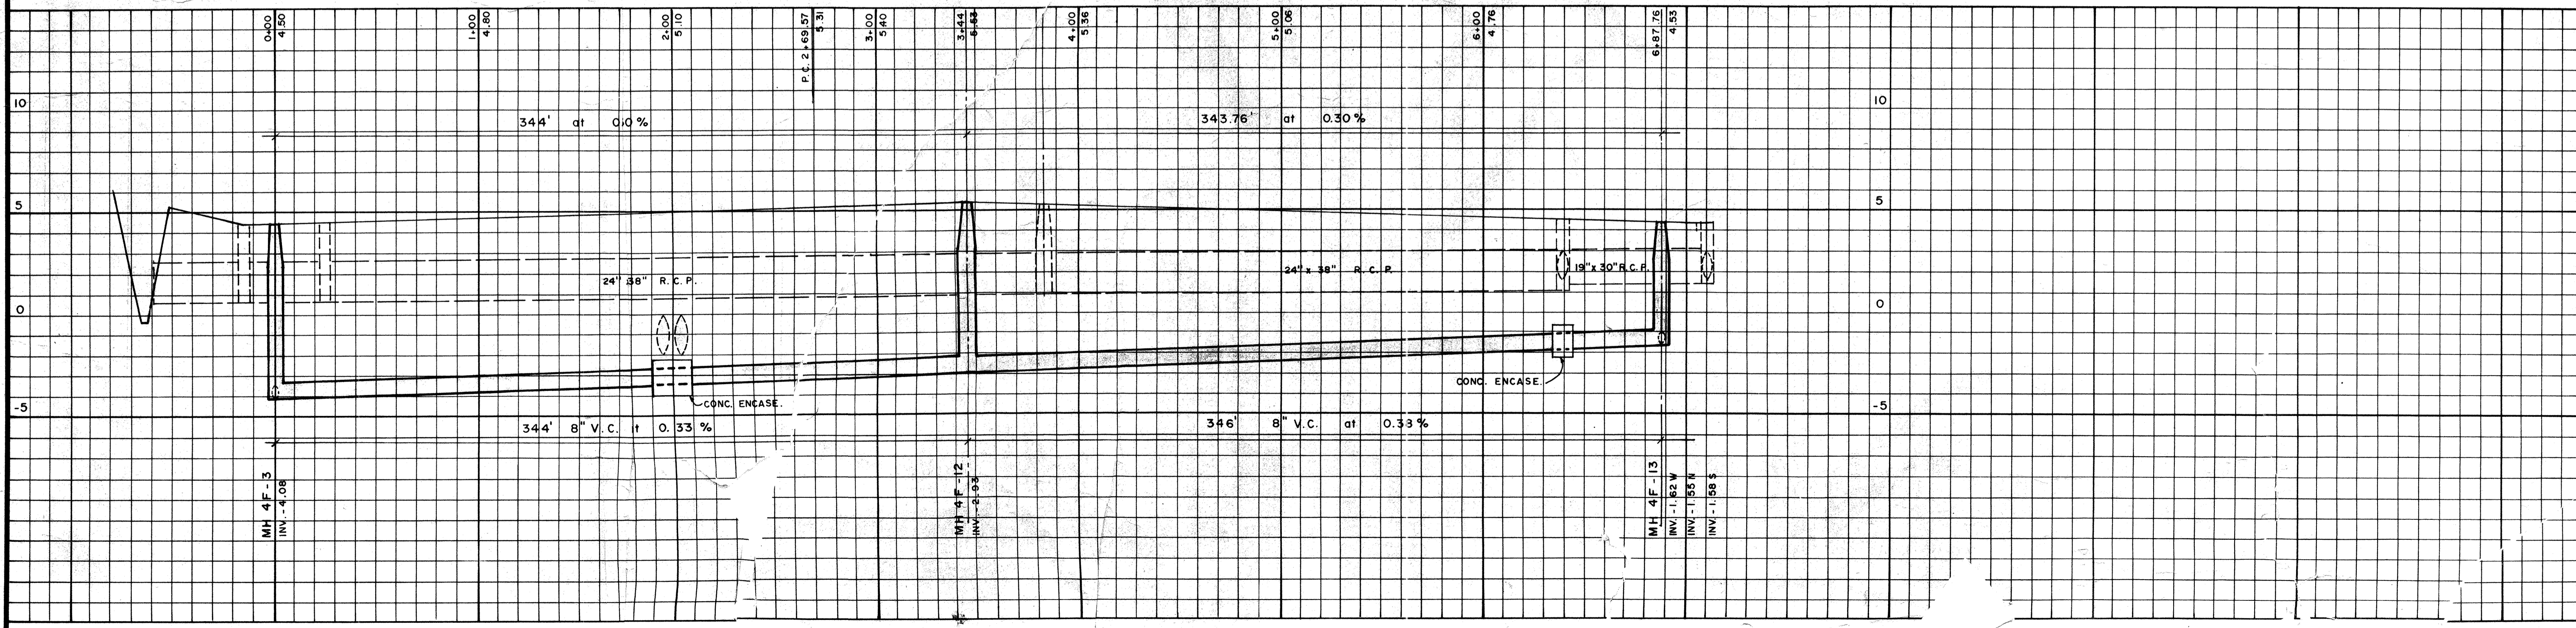

LEGEND
 - - - - - General Telephone
 - - - - - Storer Telephon
 - - - - - Fla. Power & Li
 - - - - - Irrigation

TOWN OF LONGBOAT KEY, FLORIDA
 ARVIDA CORPORATION