


- LEGEND**
- General Telephone
 - Storer Television
 - Fla Power & Light Co.
 - Arvida Corporation

NOTE: Sanitary Lateral Stations are from nearest down stream manhole (0+00)

BAYOU ROAD

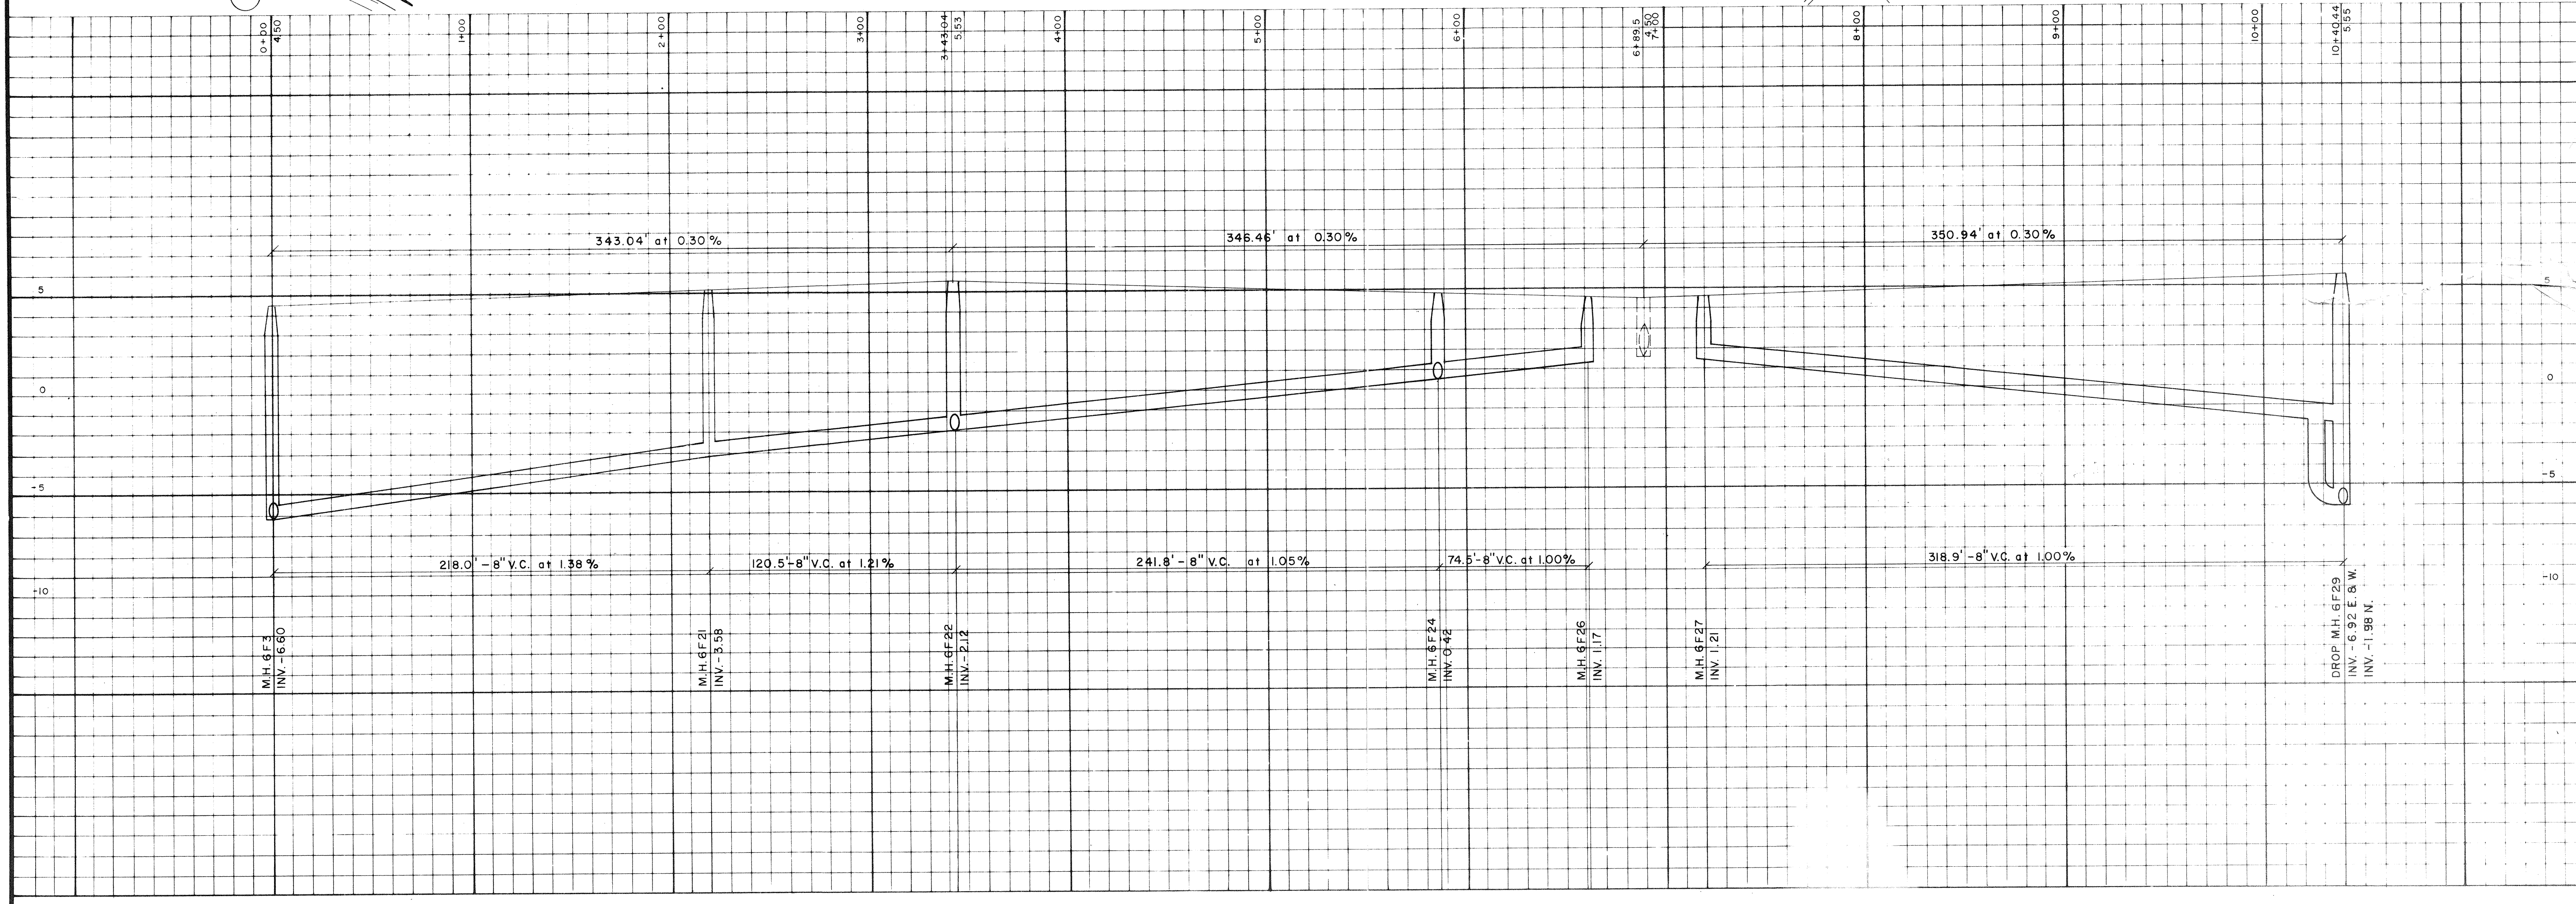

PROJECT	DATE	DESIGNED BY	CHECKED BY	PROJECT NO.
SCALE: HORIZ. 1"=40'	DRAWN BY	BY	REVISION	L.T.R. DATE
<p>TOWN OF LONGBOAT KEY, FLORIDA</p> <p>ARVIDA CORPORATION BAY ISLES UNIT NO. 2 WATER DISTRIBUTION & SEWAGE COLLECTION</p> <p>ENGINEER: BENNETT & BISHOP, INC. CONSULTING ENGINEERS & SURVEYORS - 4809 BEE RIDGE RD., SARASOTA, FLORIDA</p>				
<p>SHEET NUMBER 191-142 AB</p>				
<p>REVISION</p>				