


FOR PROPOSED UNIT 7 CONSTRUCTION  
1. SEE BOXED NOTES.

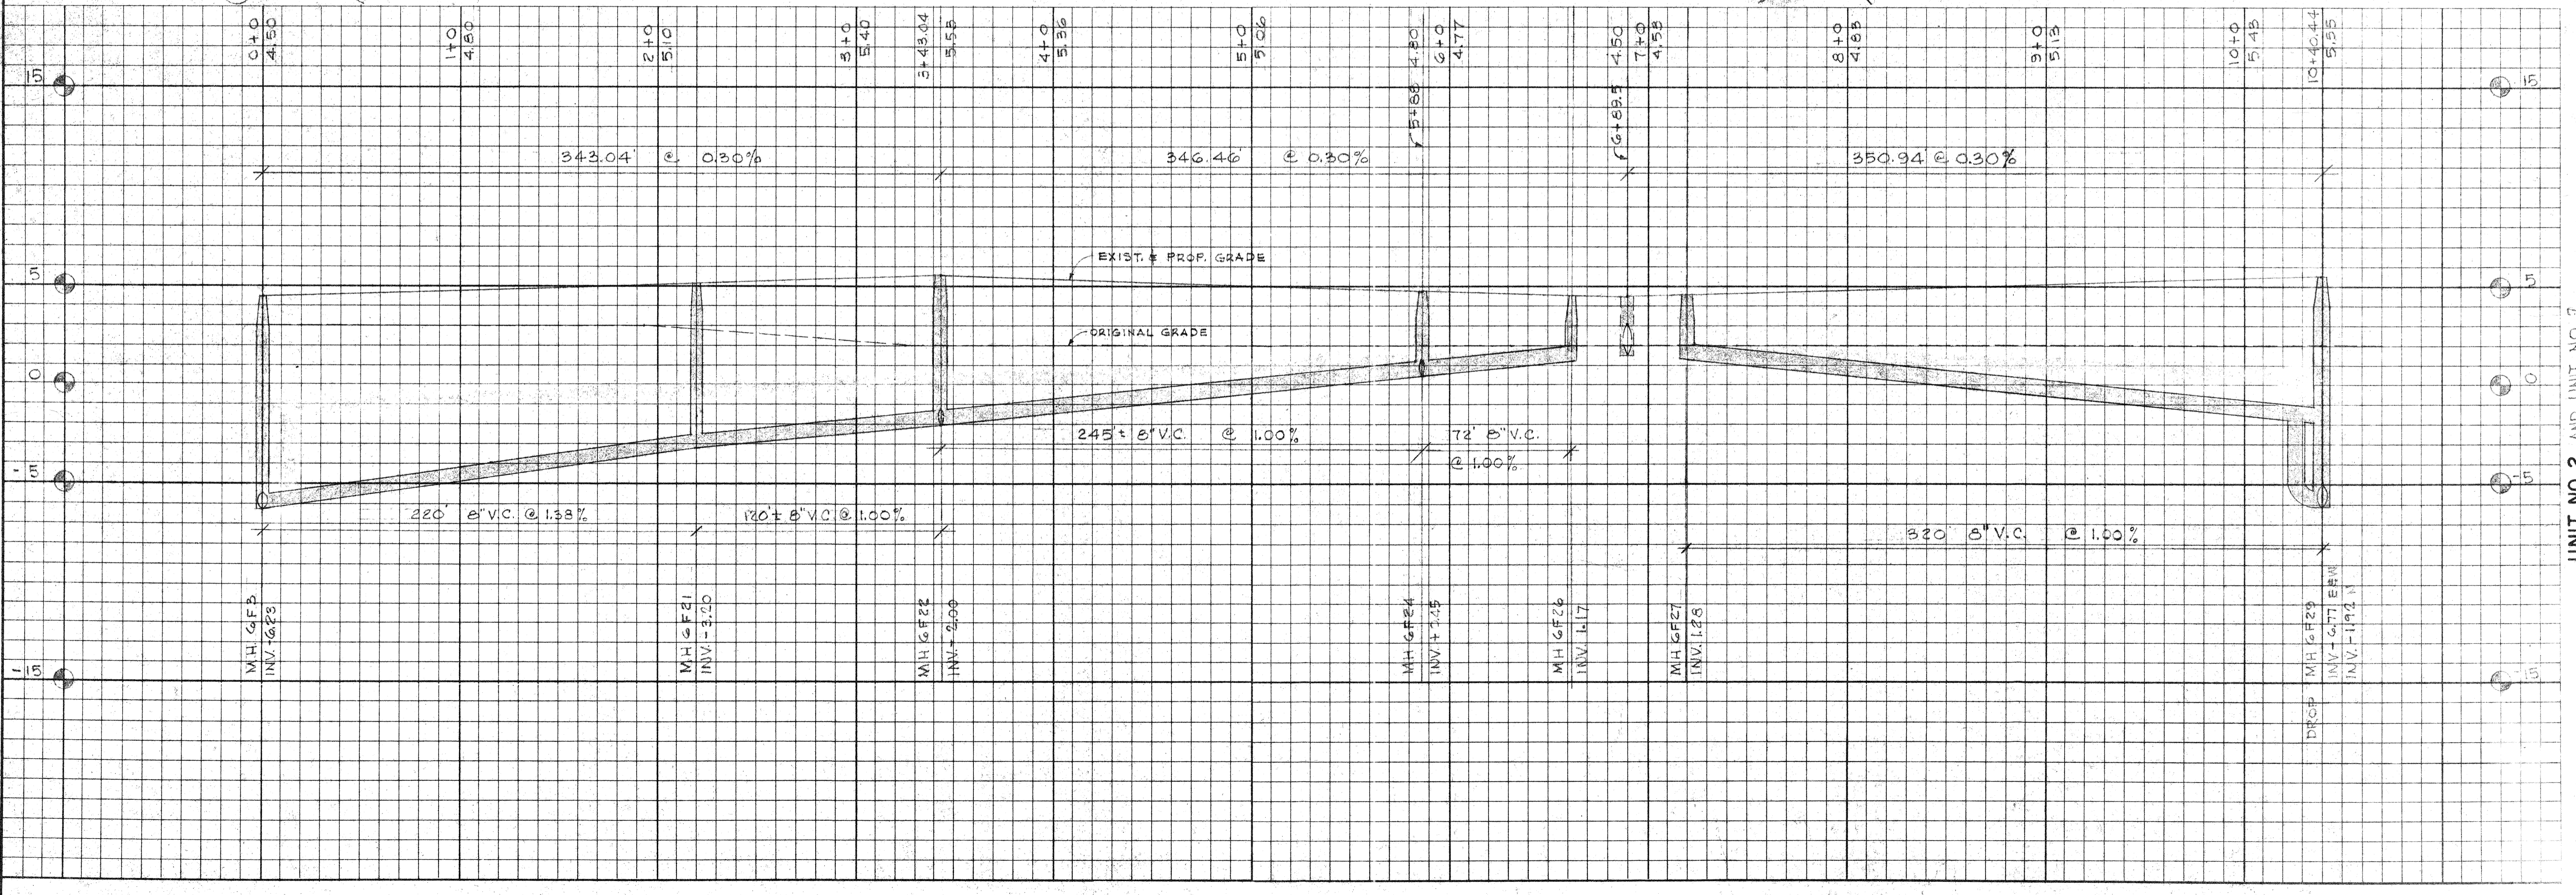

**BENNETT & BISHOP**  
CONSULTING ENGINEERS & SURVEYORS  
TALLAHASSEE, FLORIDA

**ARVIDA CORPORATION**  
**BAY ISLES**  
PLAN & PROFILE

UNIT NO. 2 AND UNIT NO. 7

| DATE     | SCALE    | DESIGN | DRAWN  | CHECK | APPROVED |
|----------|----------|--------|--------|-------|----------|
| 4/16/78  | 1" = 40' | Q.L.B. | M.A.C. | V.P.  |          |
| 12/14/78 |          | Q.L.B. | M.A.C. | V.P.  |          |
| 10/27/79 |          | Q.L.B. | M.A.C. | V.P.  |          |
|          |          | Q.L.B. | M.A.C. | V.P.  |          |

DESCRIPTION: UNIT 7 CONSTRUCTION, ADDED UNIT 7, REVISED SAN SEWER PROFILE, REVISED SAN SEWER PROFILE, ADDED ORIGINAL GRADE.

PHONE 388-3178