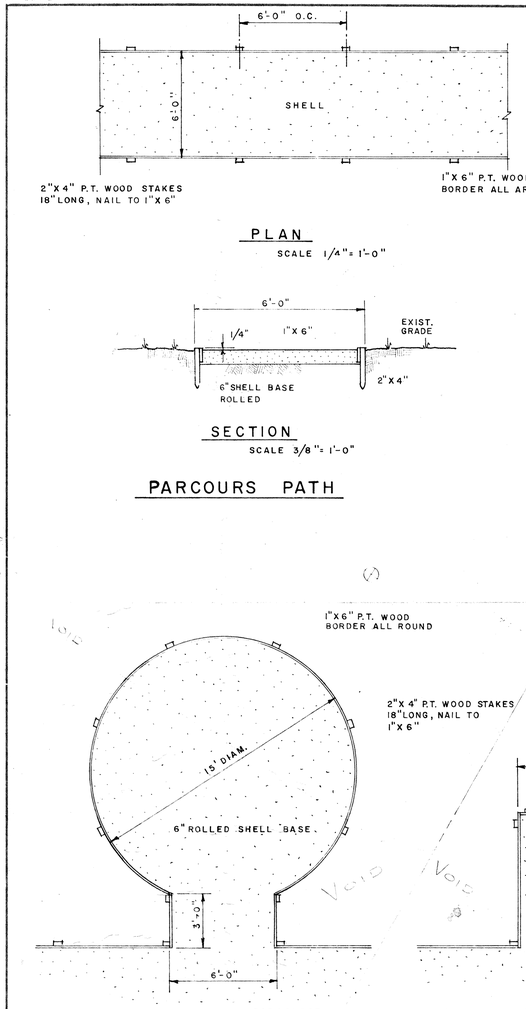

| DATE | DESCRIPTION | BY |
|---|---|---|
| 11-23-81 | ADD FPL TRANSFORMER & DWG. | M.W. |
| 10-1-81 | ADDED & MOVED SEWER LINE | N.A.L. |
| 9-21-81 | CHGE WATER METERS 1 PER BLDG. | M.W. |
| 9-16-81 | MOVED BLDG. No. 22 - REVISED PARKING | N.A.L. |
| 7-30-81 | ADDED SEWER LINE TO REC. BLDG. | N.A.L. |
| 7-28-81 | REVISED SEWER LINES | N.A.L. |
| 7-1-81 | REVISED WATER & SEWER LINES, DRAIN | N.A.L. |
| 6-18-81 | REMOVED PARCOURS EXERCISE STATIONS | N.A.L. |
| 6-10-81 | ADDED ART. MUSEUM - CHANGED PIPE SIZES | N.A.L. |

**BENNETT & BISHOP**
CIVIL ENGINEERS & SURVEYORS
SARASOTA FLORIDA

| | |
|---|---|
| DATE | 5-27-81 |
| SCALE | 1" = 40' |
| DRAWN | N.A.L. |
| CHECKED | |
| APPROVED | |

ARVIDA CORPORATION
FAIRWAY BAY

DETAIL SITE PLAN (CENTRAL)

191-405