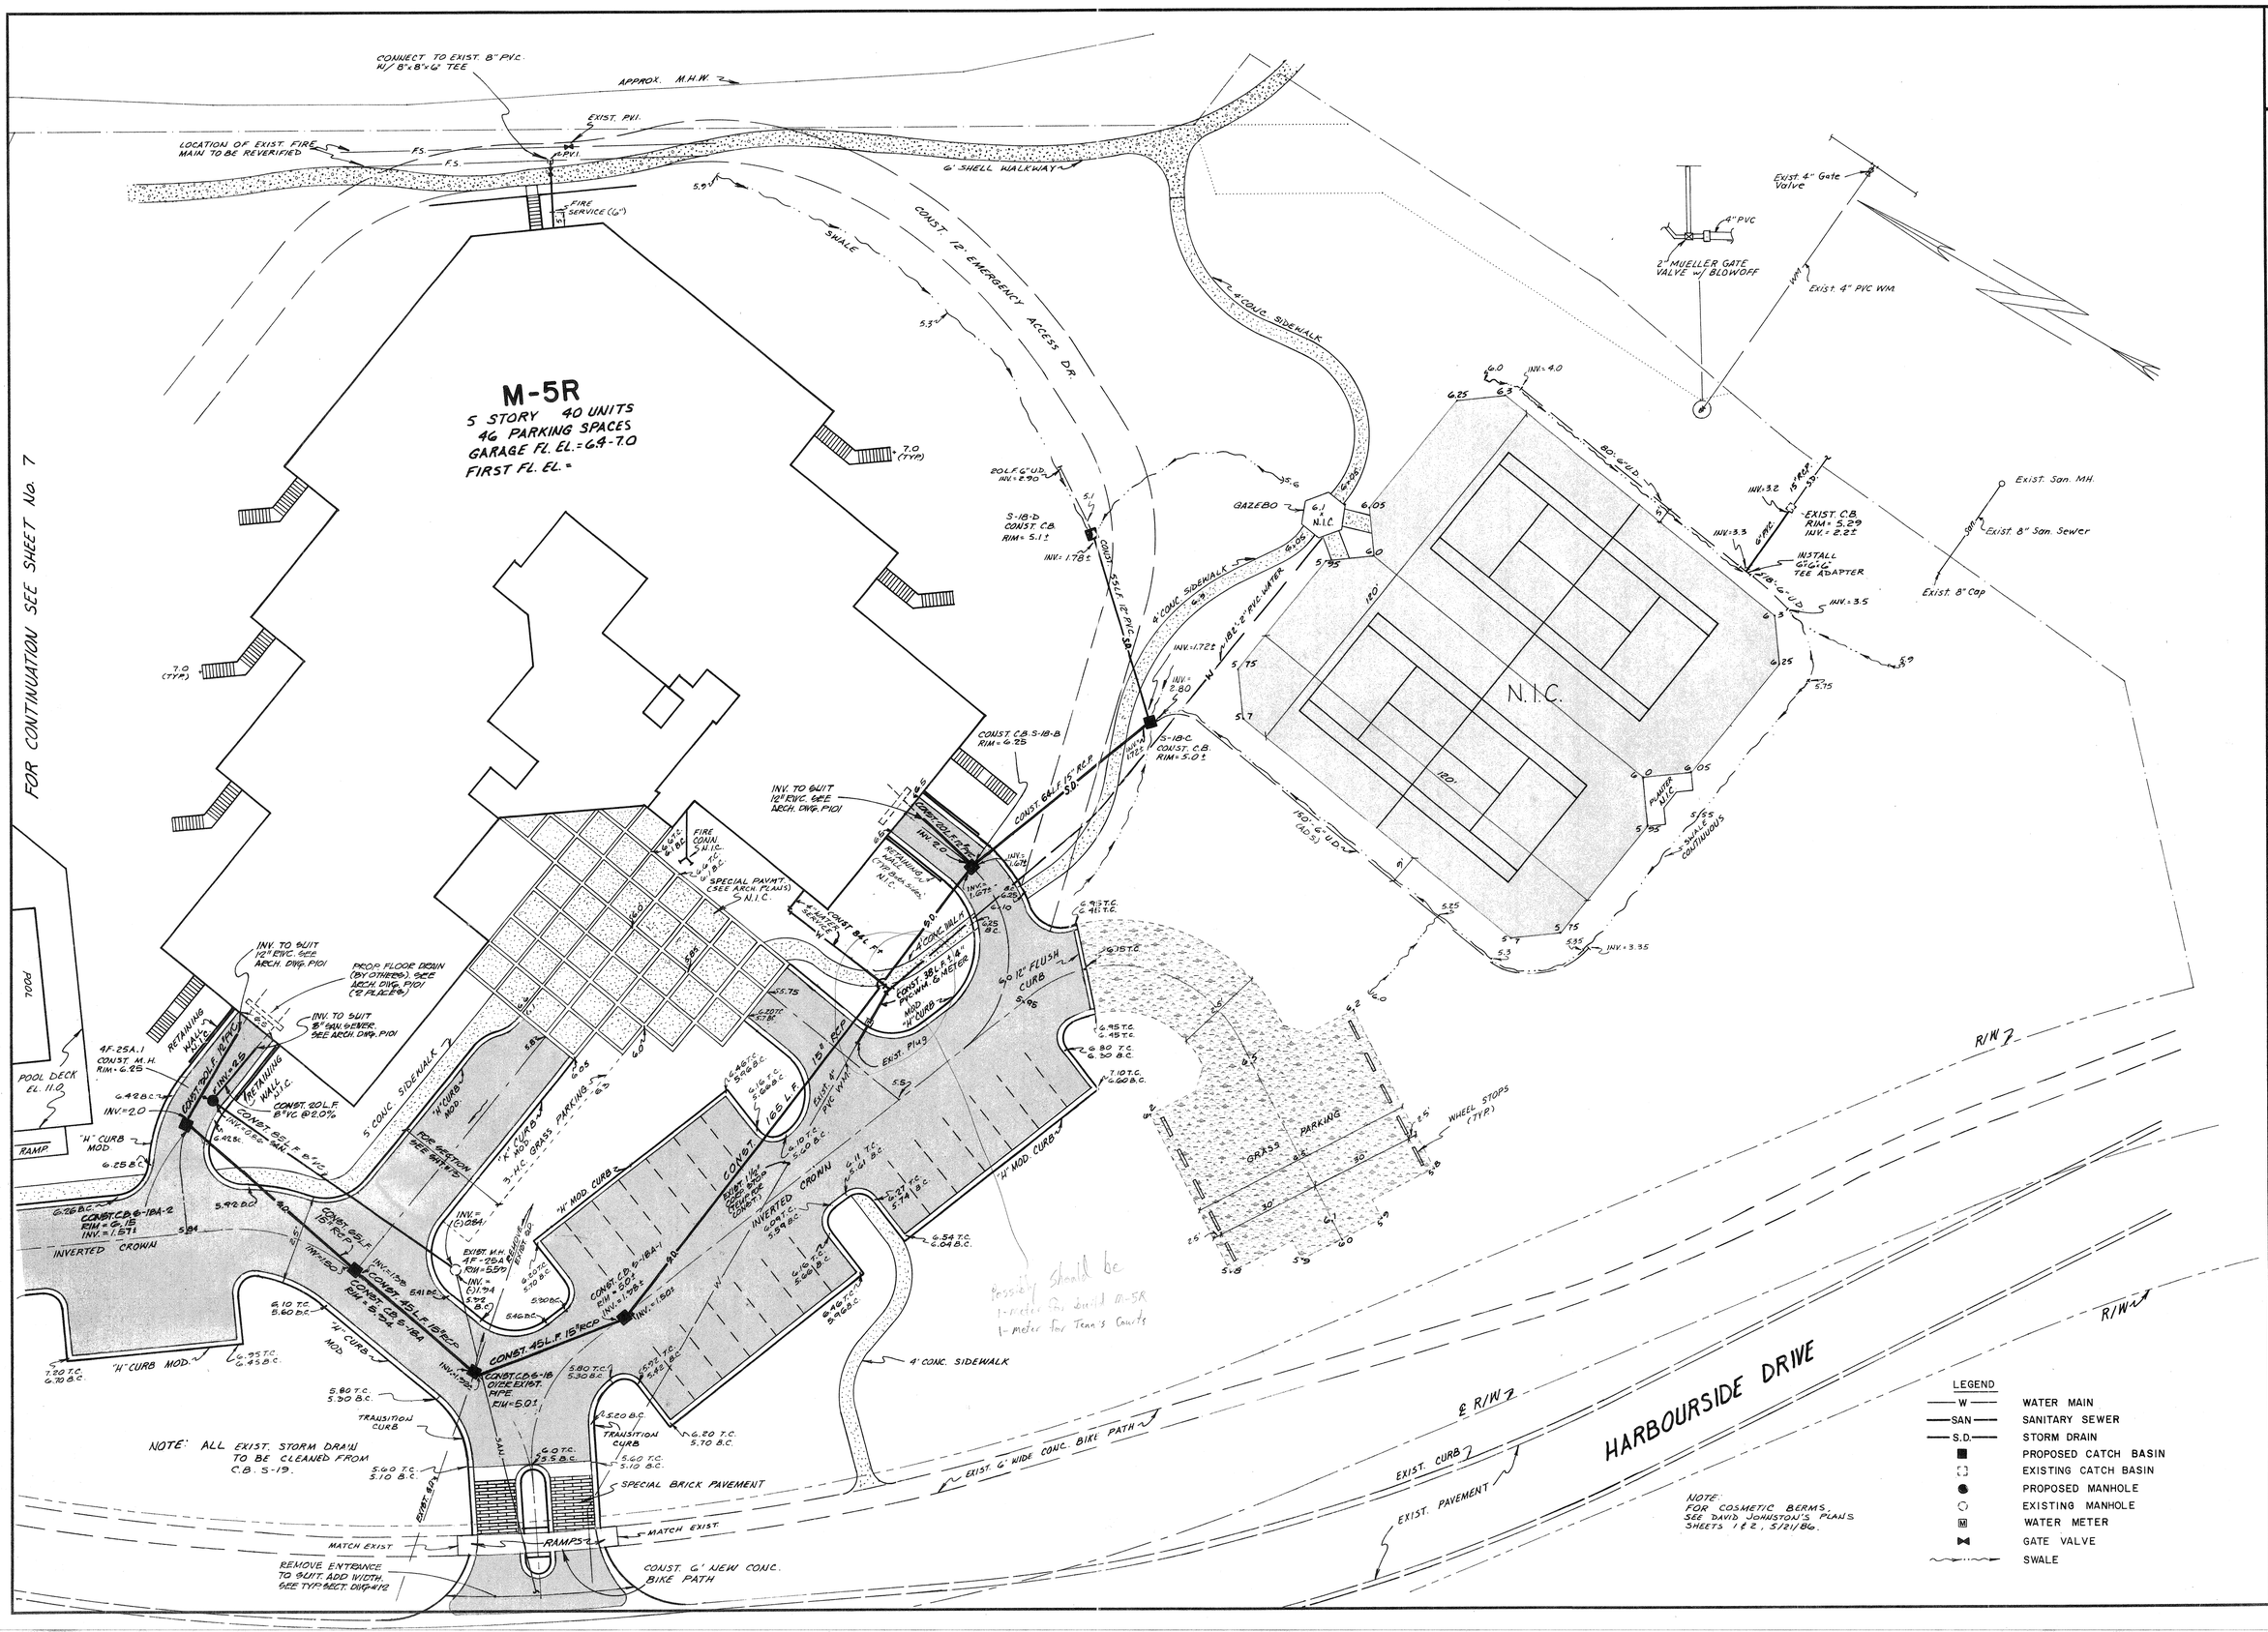

WILLIAM F. BISHOP & ASSOCIATES, INC.
CONSULTING ENGINEERS · SURVEYORS
SARASOTA FLORIDA

APPROVED BY

REVISED			
DATE	DESCRIPTION	BY
01-29-86	STORM & SAN. SEWER LOC. TO SUIT BLDG. K.G.	RWC
10-3-86	REV. WM & STORM SEW. LOC. S.	

DATE	7-21-86
SCALE	1" = 20'
DESIGN	F.V.
DRAWN	P.L./R.W.C.
CHECK	
APPROVED	

ARVIDA CORPORATION
FAIRWAY BAY III

DETAIL SITE PLAN

LONGBOAT KEY SARASOTA, FLORIDA

DWG. NO.
ARVD-0017

6