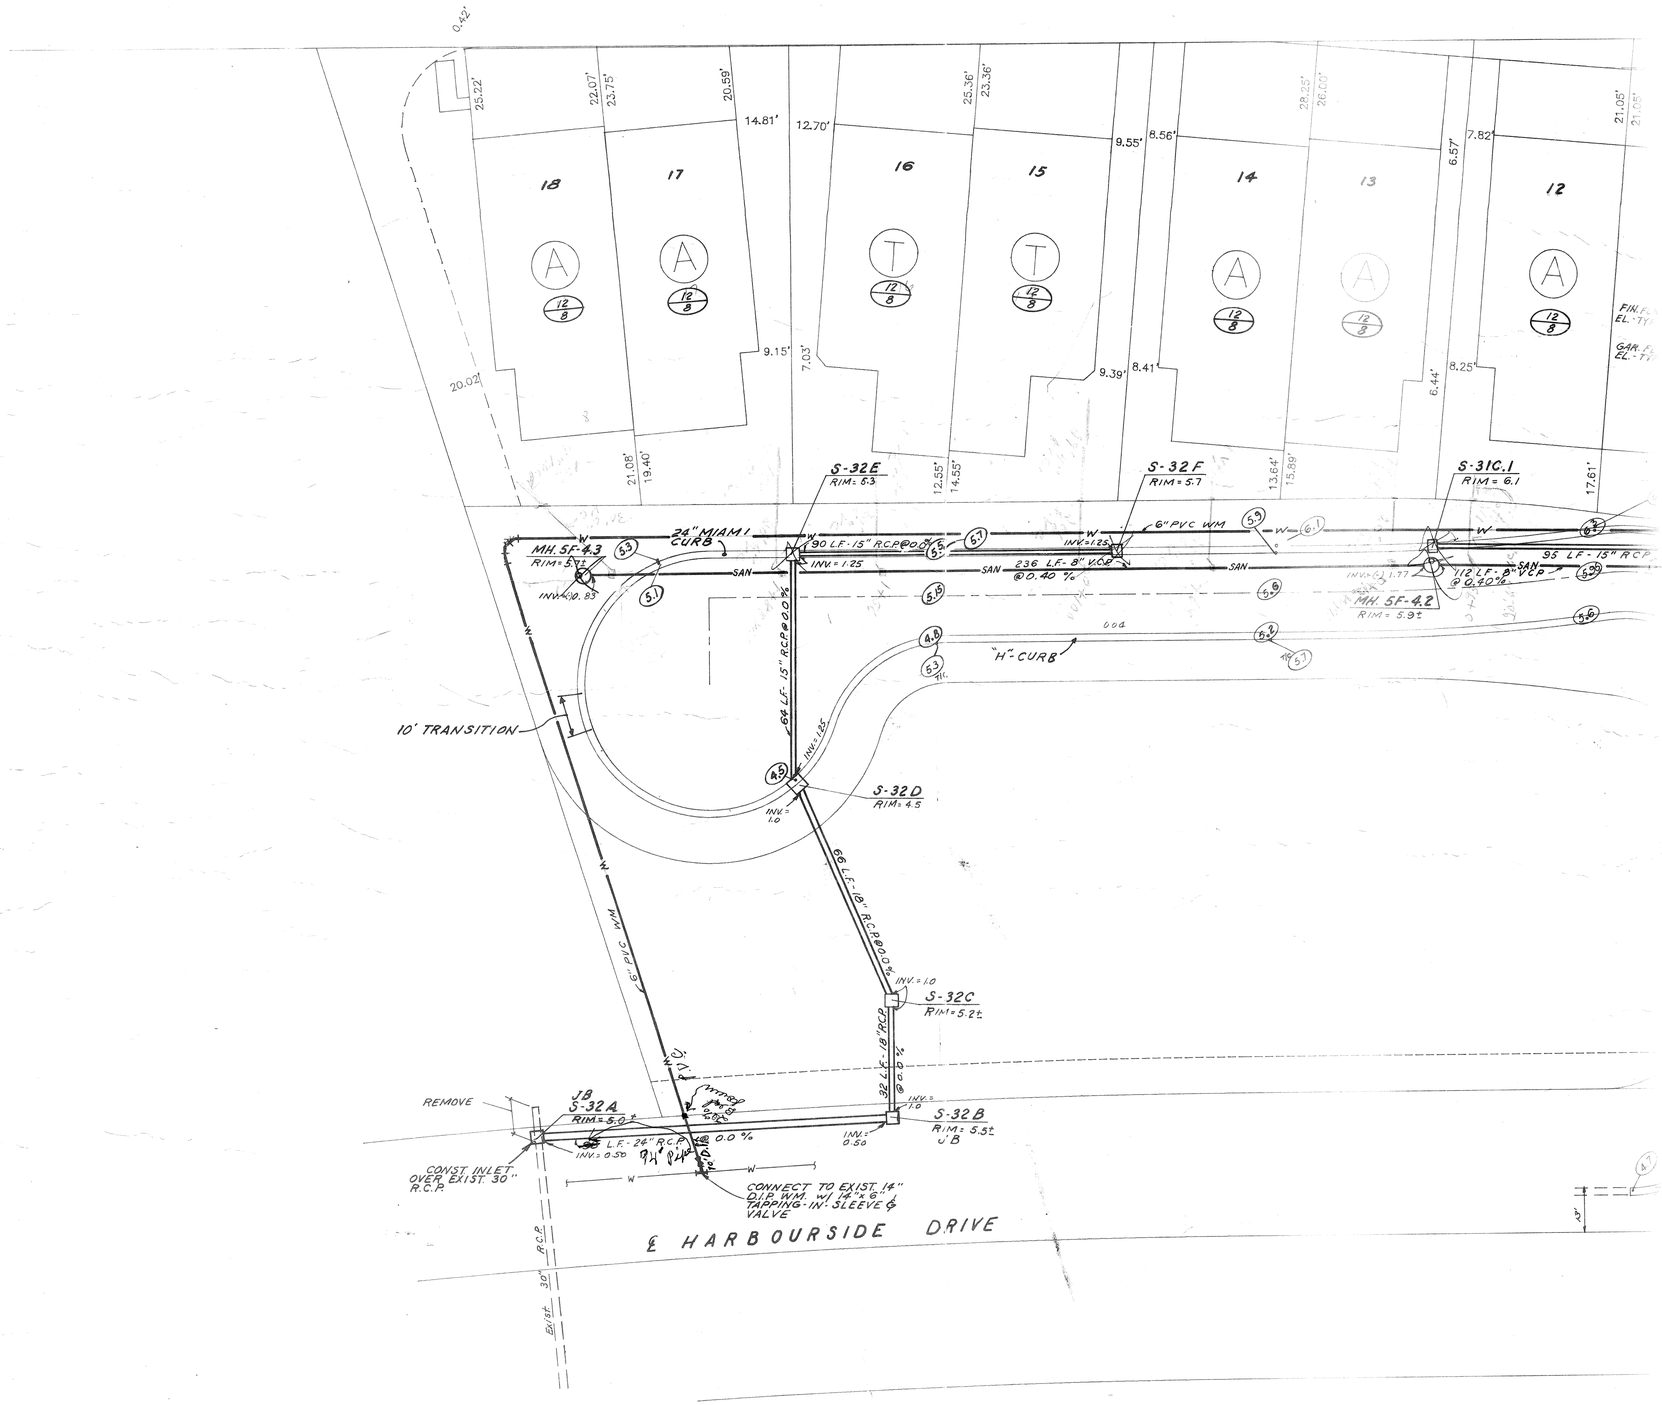

WILLIAM F. BISHOP & ASSOCIATES, INC.
CONSULTING ENGINEERS

HARBOUR COURT