A.F. 18867AB

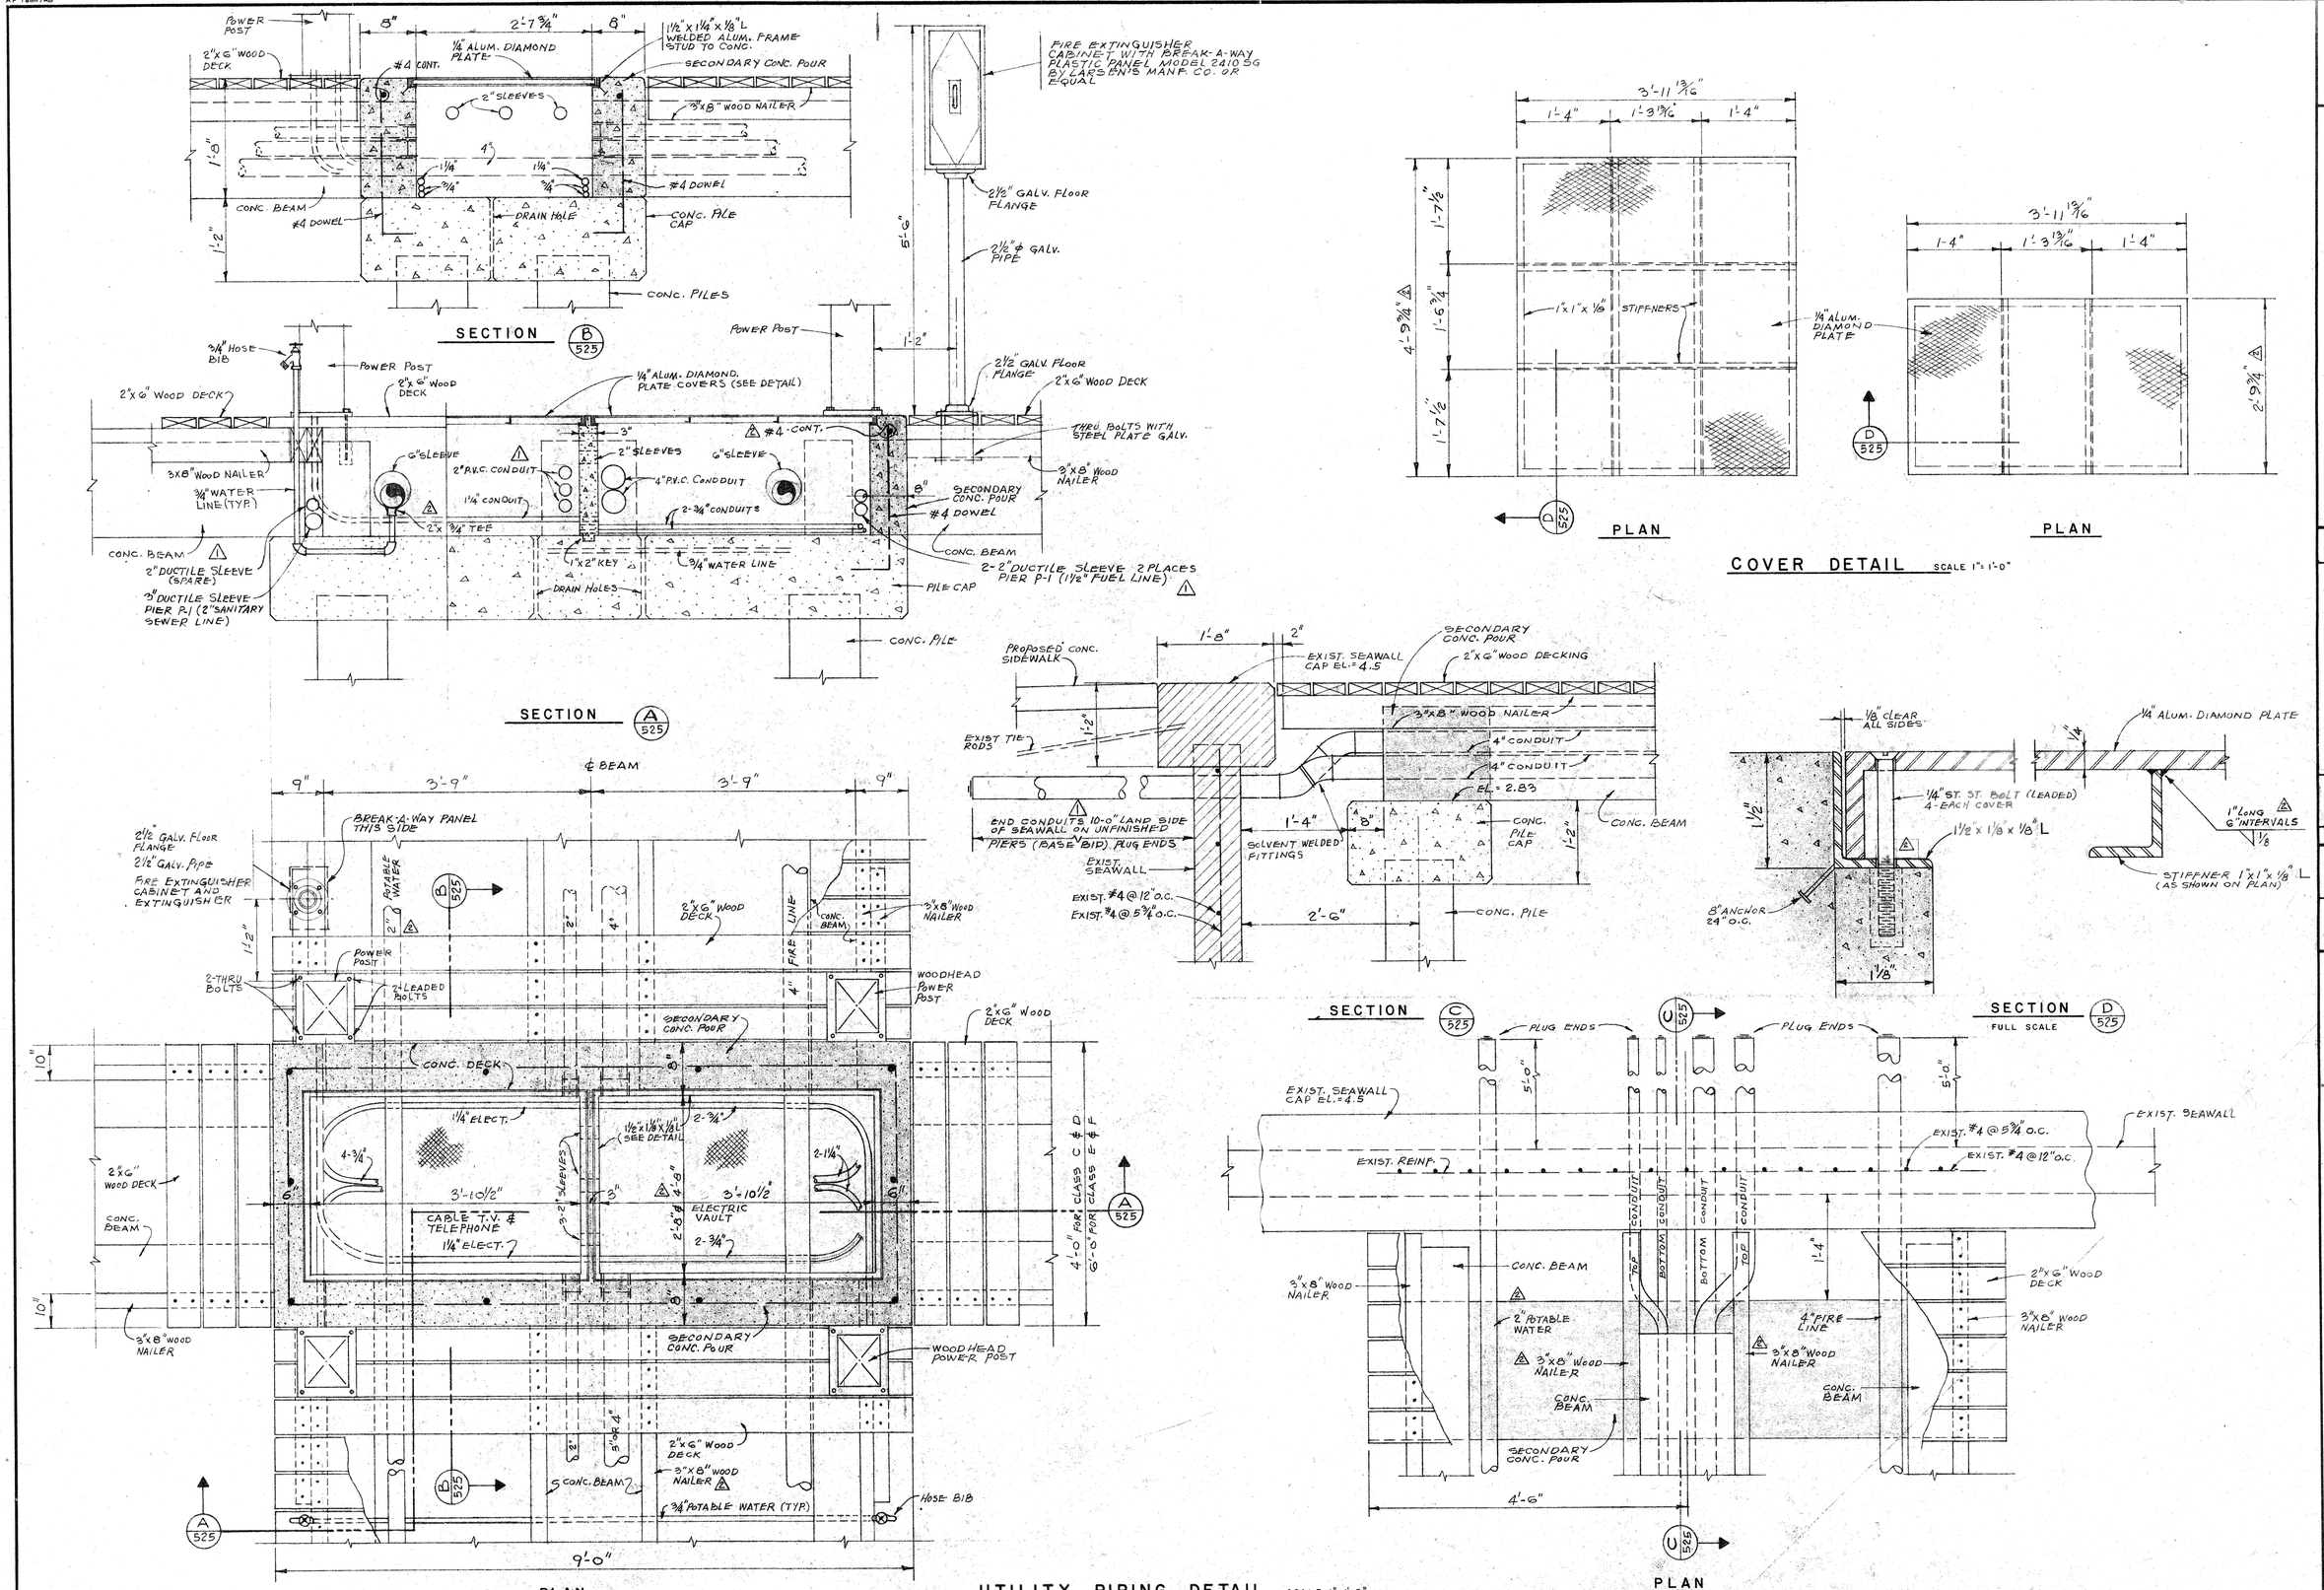

BENNETT & BISHOP
CONSULTING ENGINEERS & SURVEYORS
SARASOTA FLORIDA

APPROVED BY

DATE	DESCRIPTION	BY
9-24-82	REV. PIPE & COVER SIZES ADDED P-105	N.A.L.
9-5-82	REVISED SECTION A & C	N.A.L.

0351A38

DATE	JAN. 11, 1982
SCALE	AS NOTED
DESIGN	F.V.
DRAWN	N.A.L.
CHECK	
APPROVED	

ARVIDA CORPORATION
BAY ISLES – HARBOUR MOORINGS
LONGBOAT KEY SARASOTA, FLORIDA

DOCK UTILITY LAYOUT

DWRG. No
191-525