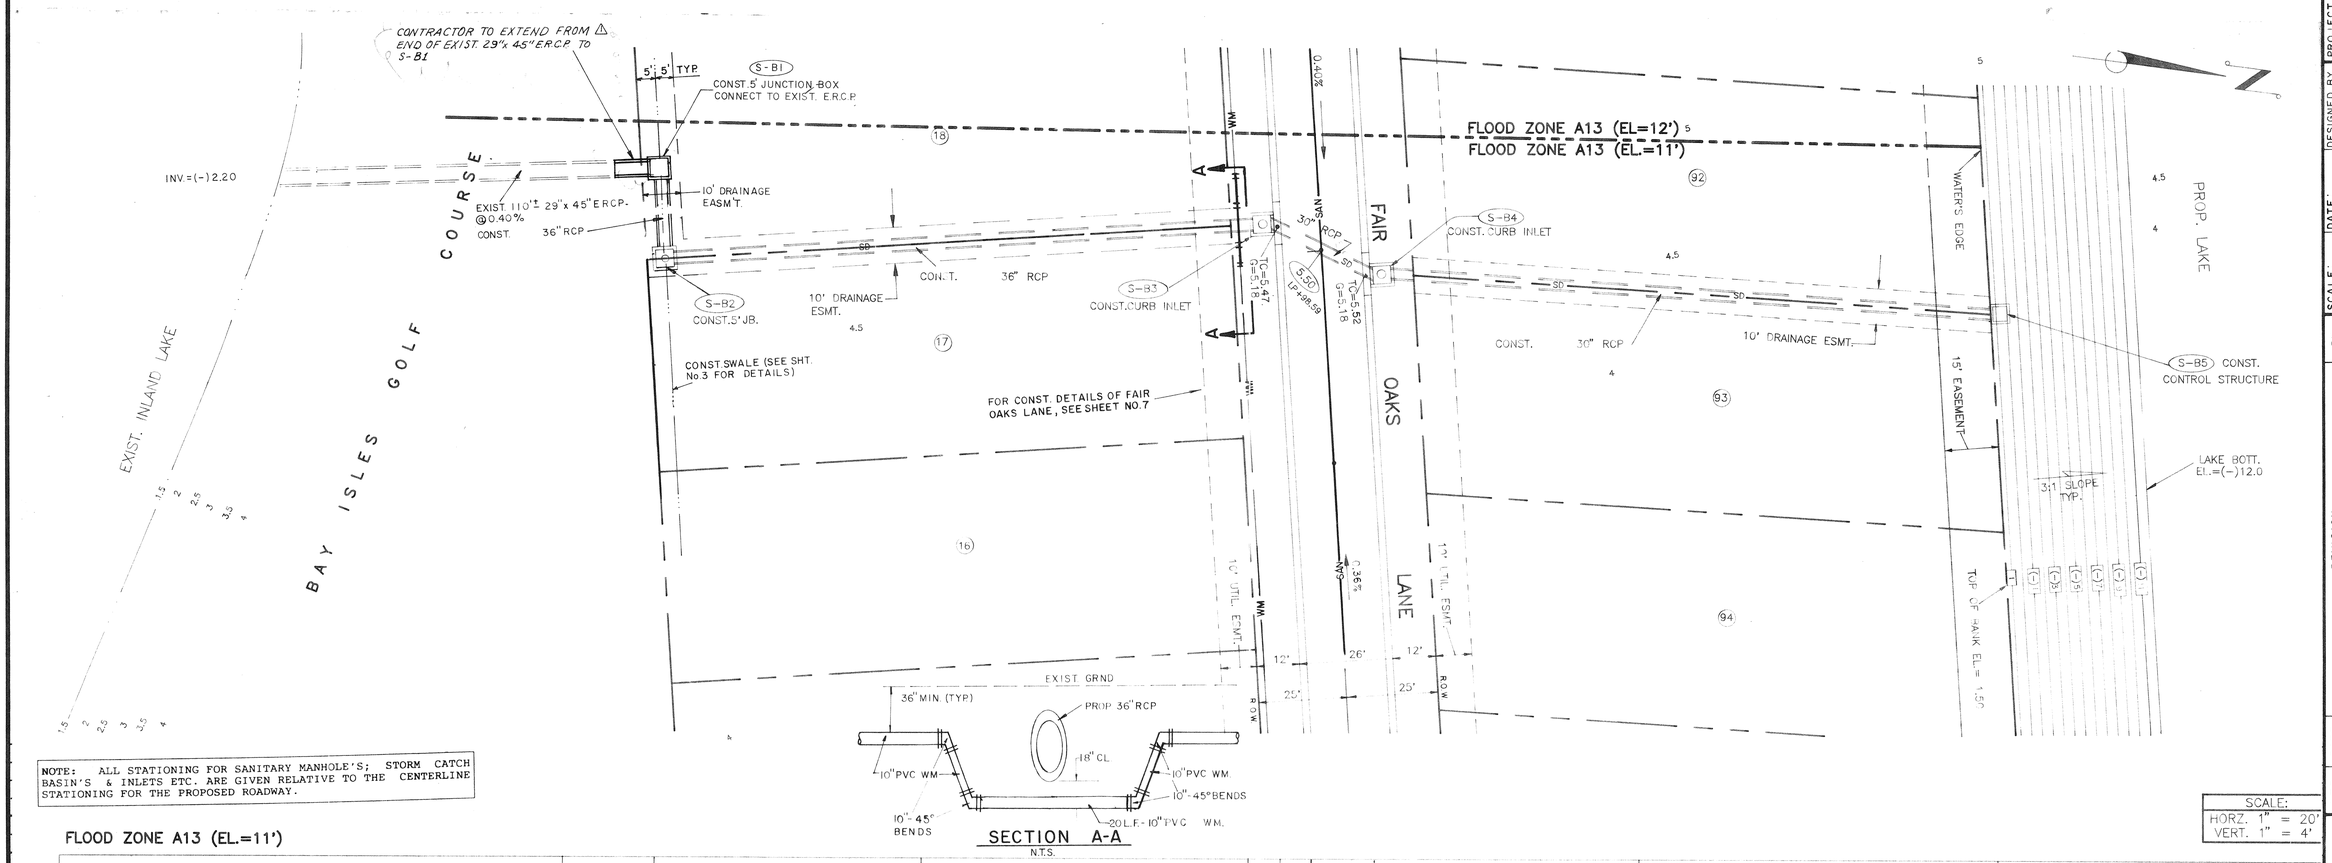

NOTE: ALL STATIONING FOR SANITARY MANHOLE'S; STORM CATCH BASIN'S & INLETS ETC. ARE GIVEN RELATIVE TO THE CENTERLINE STATIONING FOR THE PROPOSED ROADWAY.

SCALE:
HORZ. 1" = 20'
VERT. 1" = 4'

FLOOD ZONE A13 (EL.=11')

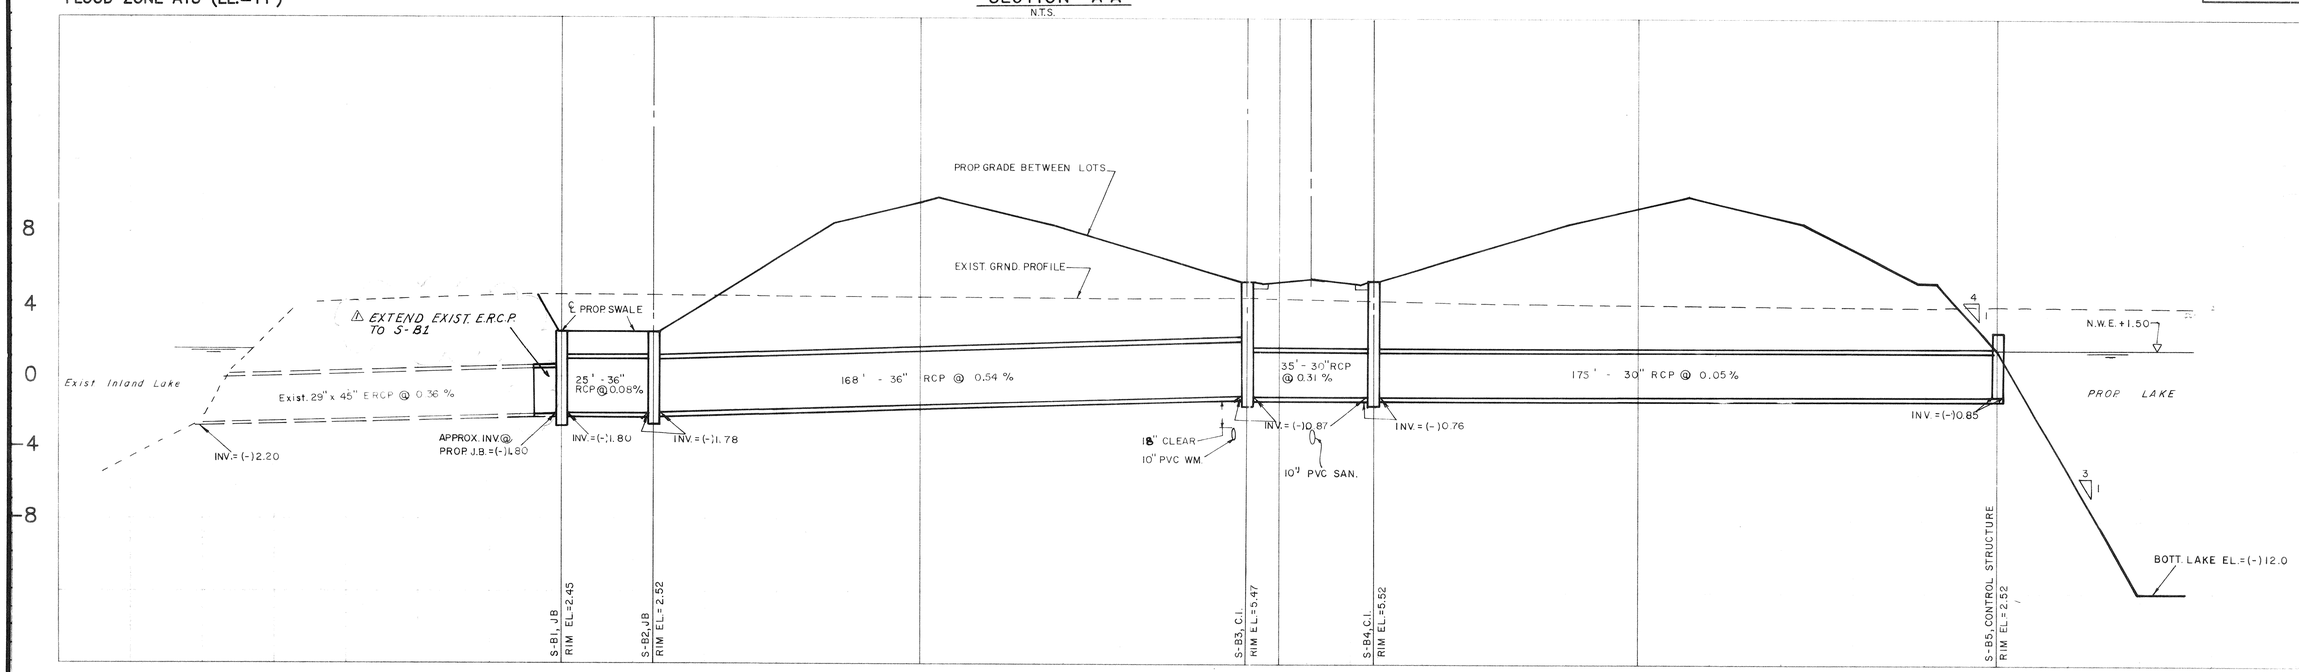

LTR.	DATE	REVISION	BY

PROJECT ENGINEER

DESIGNED BY S.R.
DATE: 9-8-89
SCALE: 1"=20'
PROJECT NO. DBDS-0018
CHECKED BY PP/CJ/S.R.
DRAWN BY R.W.C.

Ph (813) 371-6362

78 Sarasota Center Blvd. Sarasota, Florida 34240

TOWN OF LONGBOAT KEY, FLORIDA

MANCHESTER BAY
DIAMOND – CARVER, INC.
AS BUILT RECORD DRAWING OF STORM SEWER

ENGINEER & LOCATION BISHOP & ASSOCIATES, INC. CONSULTING ENGINEERS - SURVEYORS

SHEET NUMBER 14RD

REVISION

K FILE NO.