NOTE: ALL STATIONING FOR SANITARY MANHOLE'S; STORM CATCH BASIN'S & INLETS ETC. ARE GIVEN RELATIVE TO THE CENTERLINE STATIONING FOR THE PROPOSED ROADWAY.

LEGEND

- PROP. STORM DRAIN w/CURB INLET
- PROP. SANITARY SEWER w/MANHOLE
- PROP. WATERMAIN w/GATE VALVE
- EXISTING SPOT ELEVATION
- PROPOSED SPOT ELEVATION

NOTE: ALL CURB IS TYPE "K" CURB UNLESS OTHERWISE NOTED

MATCH LINE 11+60.16 SEE SHEET NO.7

MATCH LINE STA.5+30.45 SEE SHEET NO.5

FLOOD ZONE A13 (EL.11')

NOTE: ~~~~ INDICATES RELOCATION OF PROP. WM. OR STORM DRAIN DUE TO FIELD CONDITIONS.

SCALE: HORZ. 1" = 20' VERT. 1" = 4'

(2) REFERS TO H.R.S. WATER SAMPLE COLLECTION NO. TYP.

FOR DETAILS OF CONSTRUCTION OF FAIR OAKS CT. SEE SHT. 12

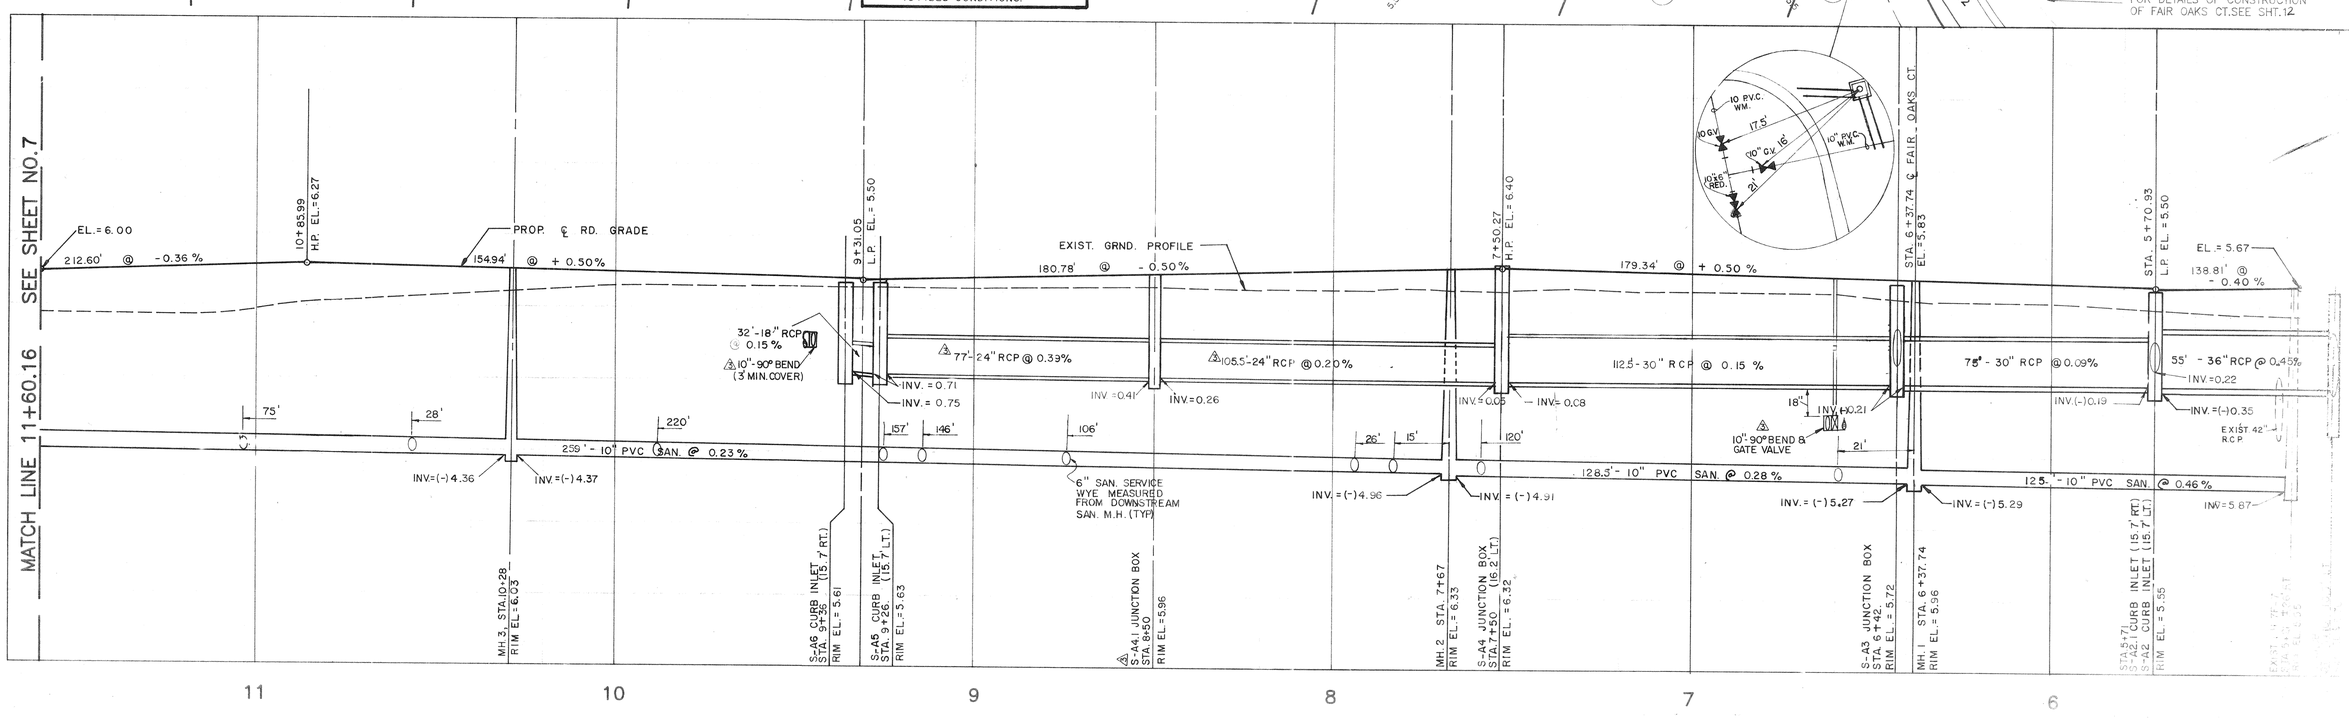

LTR.	DATE	REVISION	BY

SCALE: 1" = 20'	DATE: 9-8-89	DESIGNED BY S.R.	PROJECT ENGINEER
DRAWN BY R.W.C.	CHECKED BY PP/CJ/SR	PROJECT NO. DBDS-0018	

Sarasota Center Blvd. Sarasota, Florida 34240 Ph (813) 371-6362

COUNTY OF LONGBOAT KEY, FLORIDA
MANCHESTER BAY
DIAMOND - CARVER, INC.
WATER MAIN, SAN. & STORM SEWER
78 Sarasota