



CURBS POURED WITH CONTINUOUS PAVING MACHINE SHALL HAVE JOINTS SAW CUT EVERY 10' FOLLOWING COMPLETION OF POUR. CONSTRUCTION JOINTS SHALL BE 10' O.C. AND 1/2" PREMOLDED EXP. JOINTS AT 40' O.C.


TYPE "K" CURB  
n.t.s.

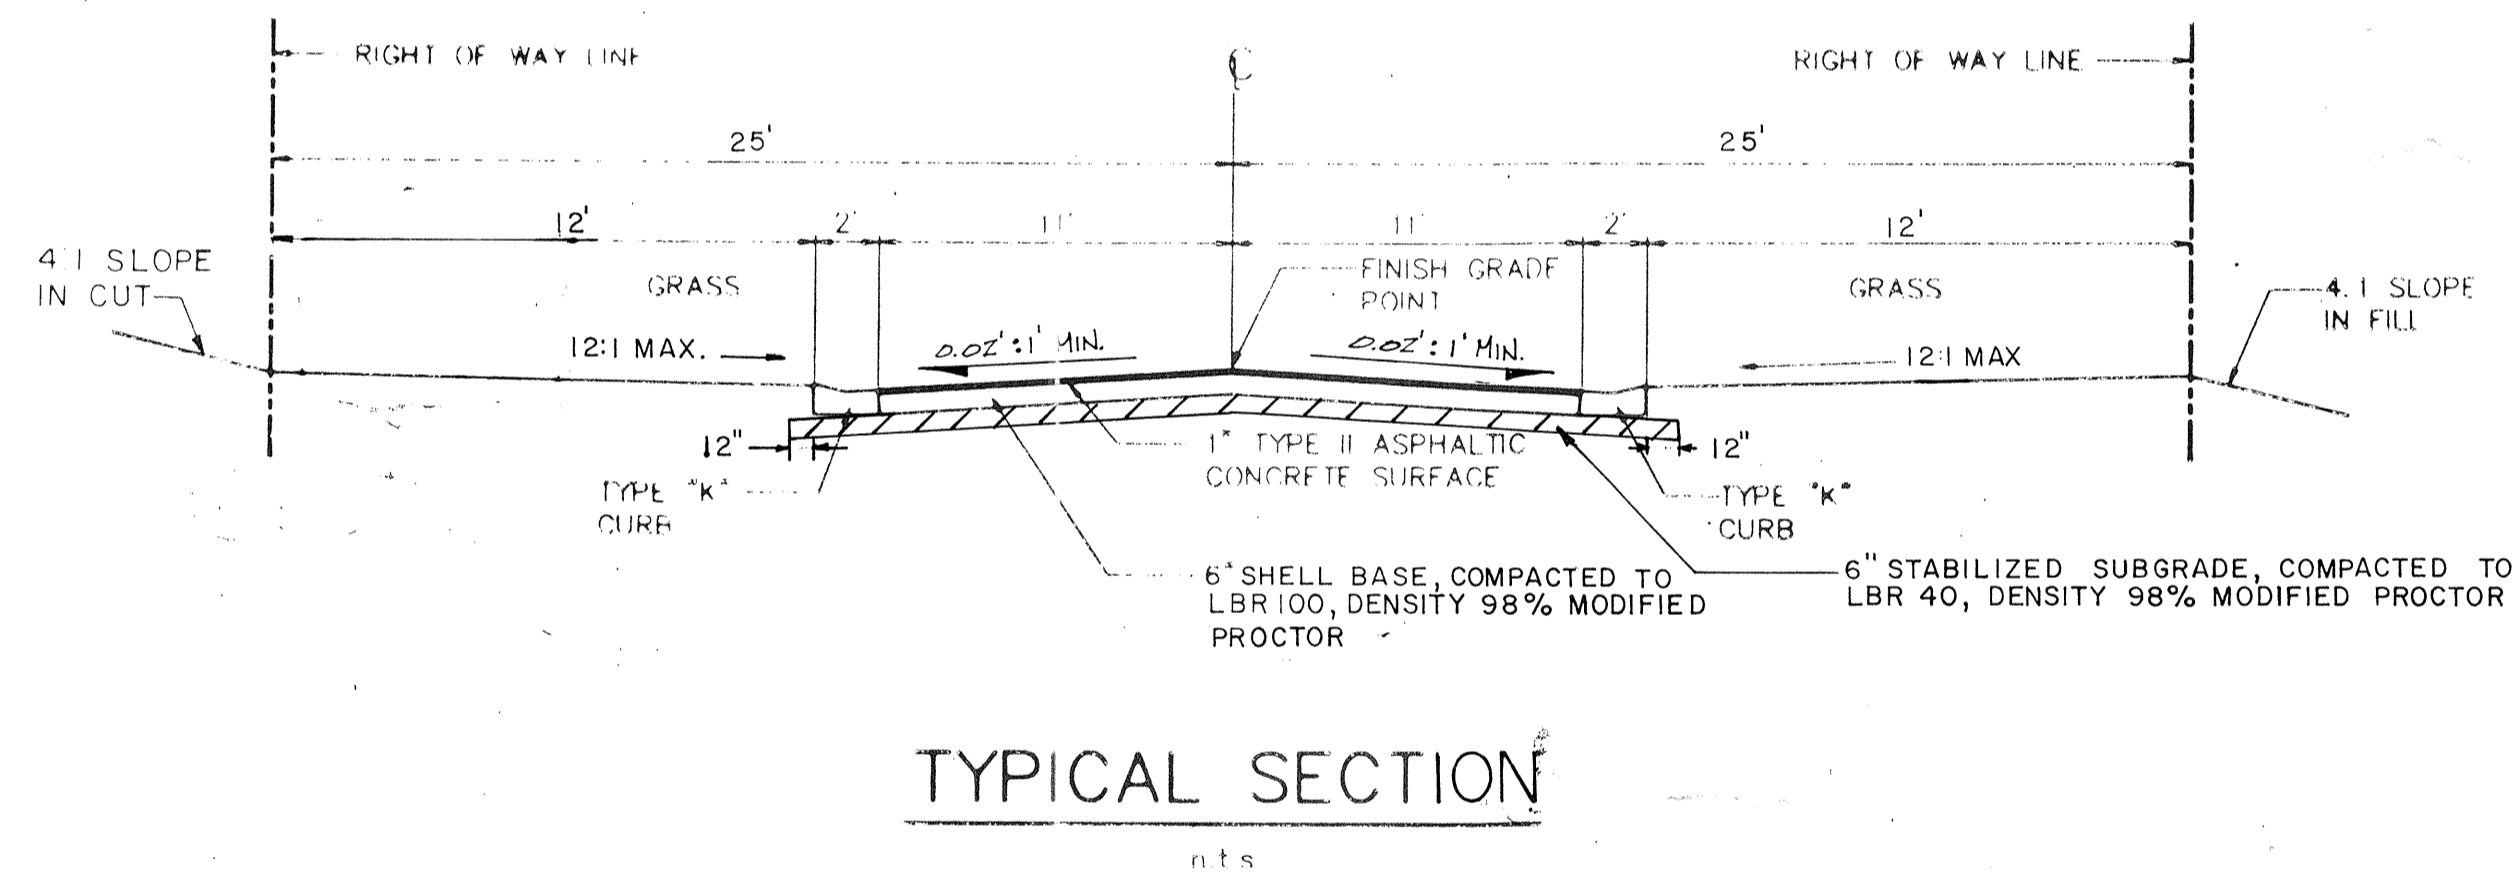


TYPICAL SECTION  
n.t.s.

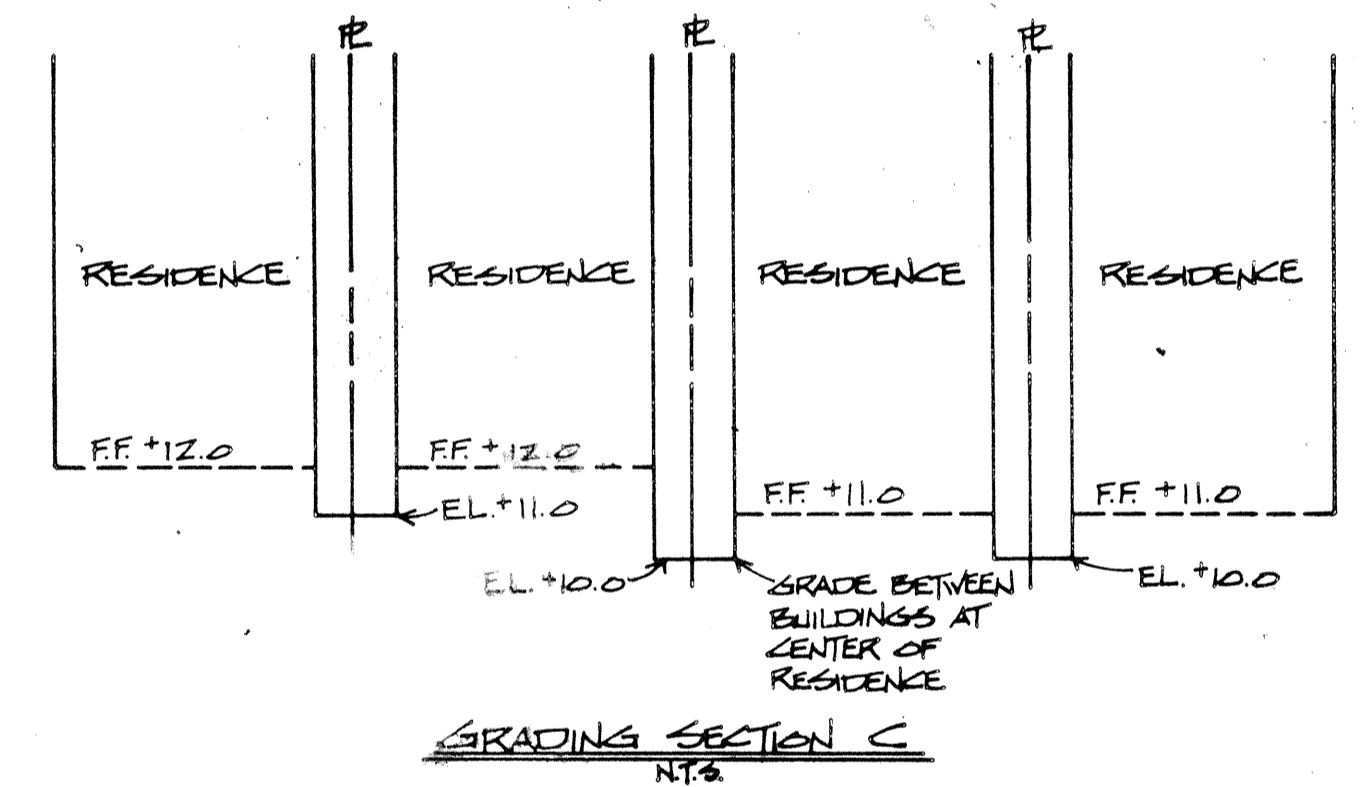


CURBS POURED WITH CONTINUOUS MACHINE SHALL HAVE JOINTS SAW CUT EVERY 10' FOLLOWING COMPLETION OF POUR. CONSTRUCTION JOINTS SHALL BE 10' O.C. AND 1/2" PREMOLDED EXP. JOINTS AT 40' O.C.

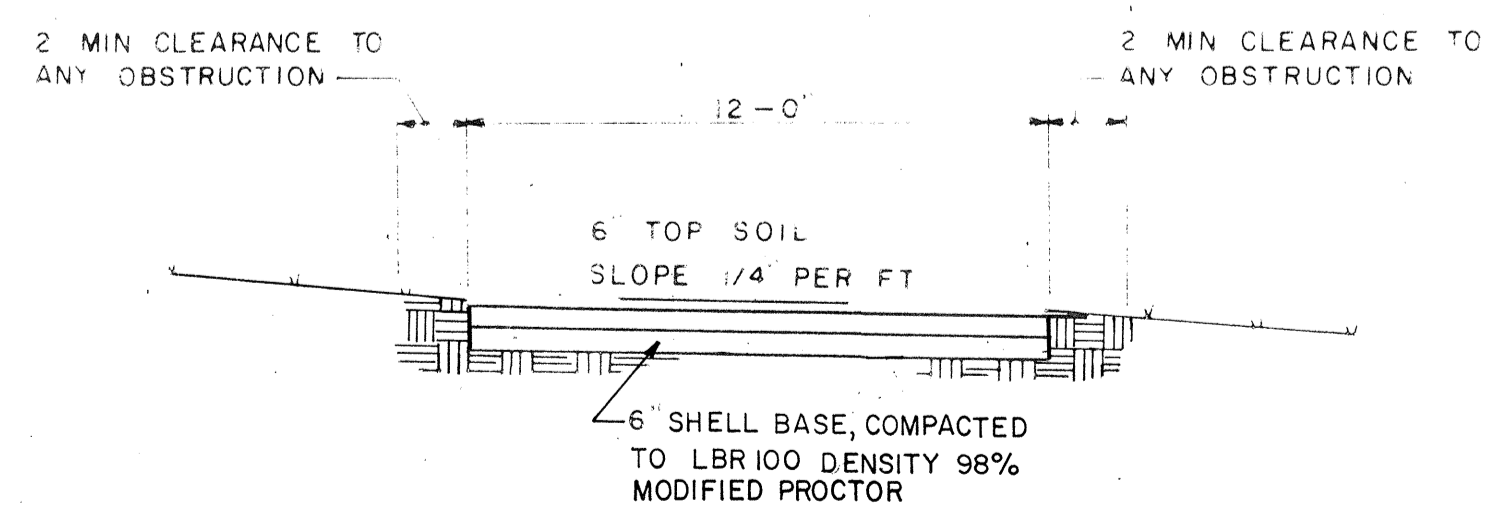


TYPICAL SECTION OF 12'  
EMERGENCY VEHICLE ACCESS DRIVE  
n.t.s.

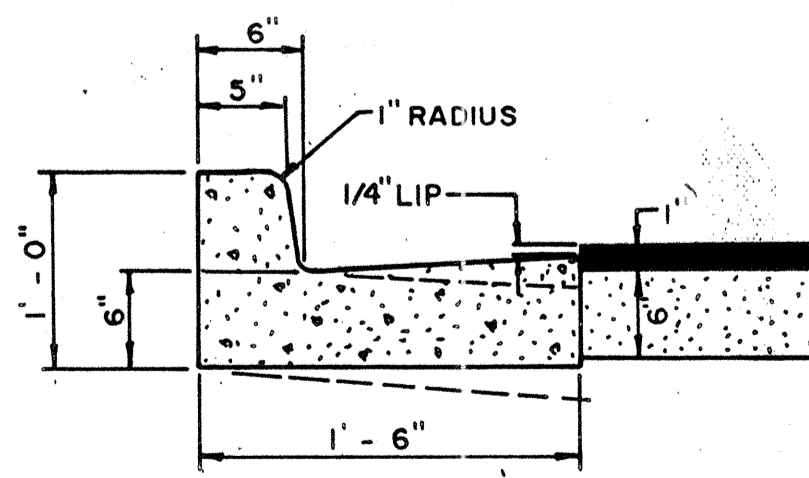

TYPE "H" CURB  
n.t.s.

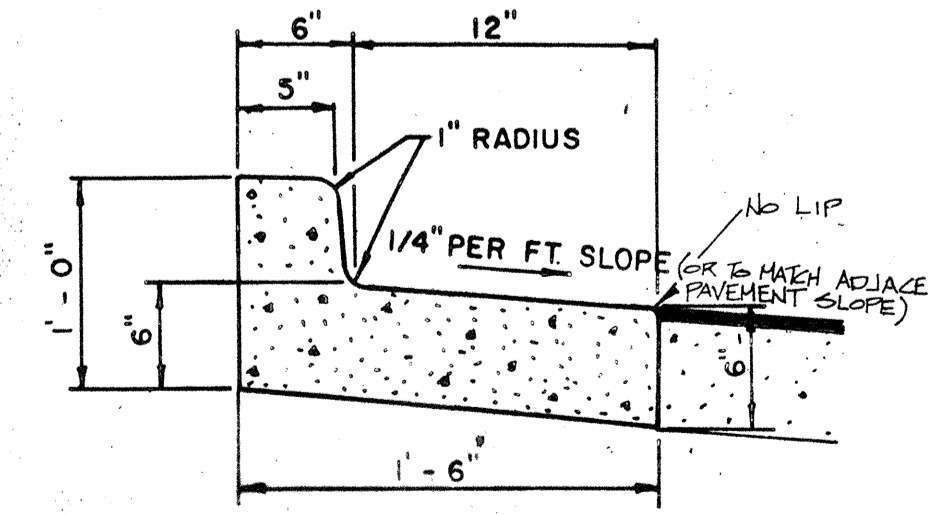

TYPE "H" CURB MODIFIED  
n.t.s.

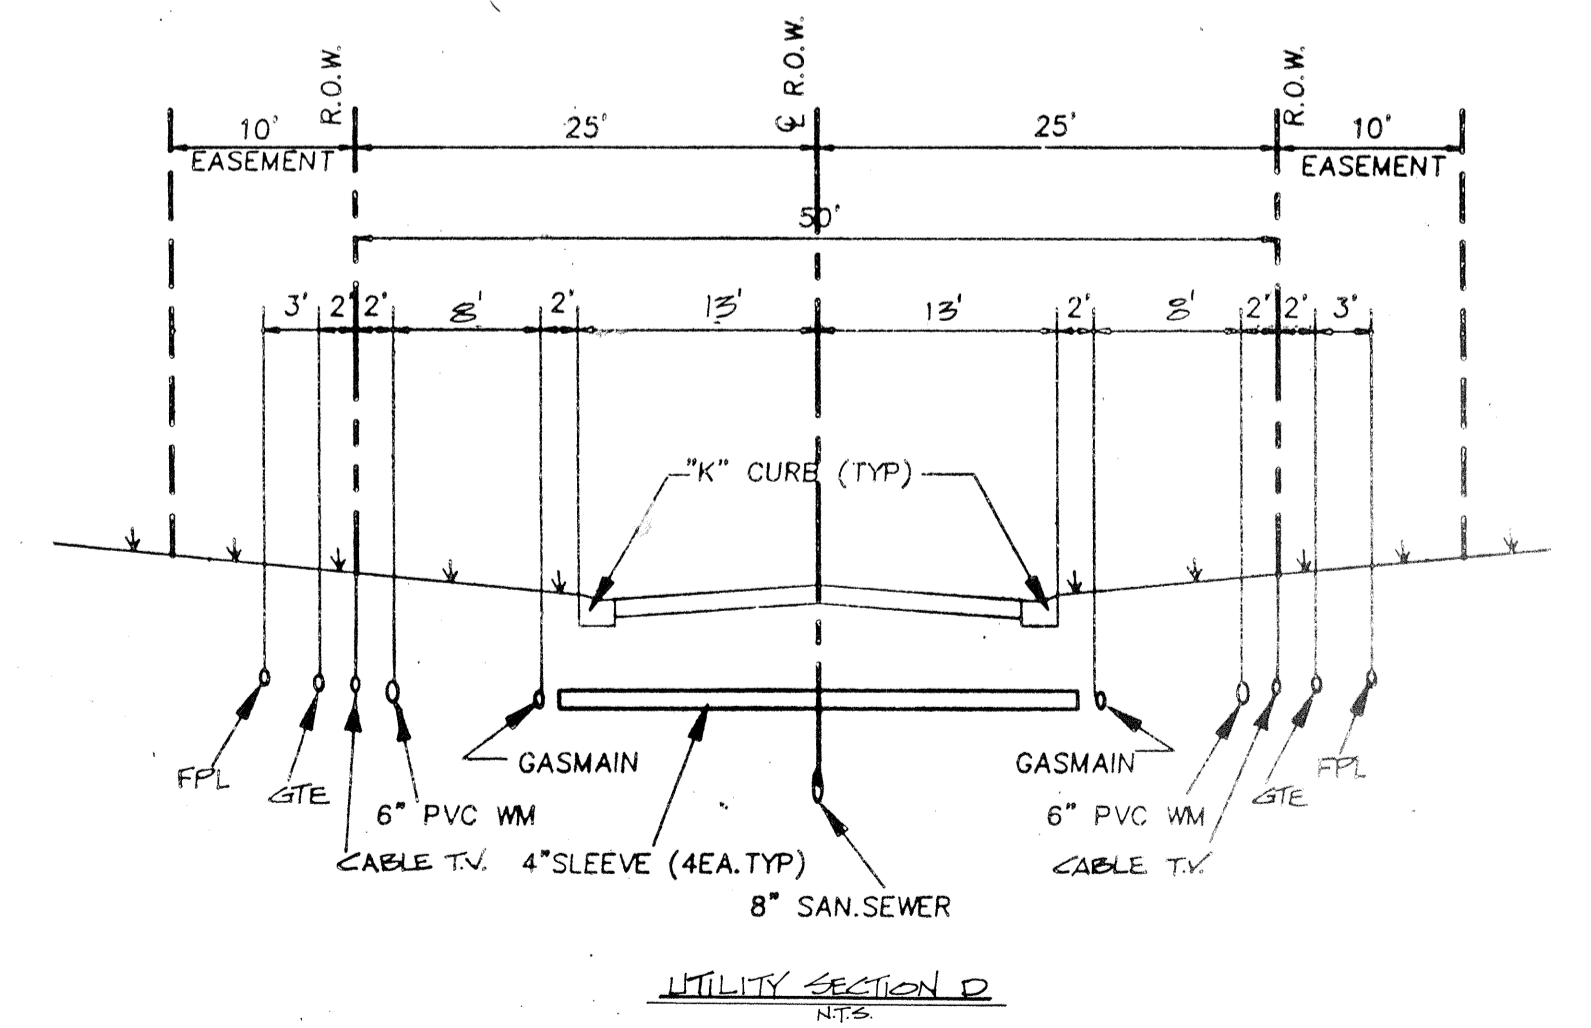

UTILITY SECTION D  
n.t.s.

REVISED	BY	DATE	DESCRIPTION

DATE	2/1/89
SCALE	AS SHOWN
DESIGN	STAFF
DRAWN	STAFF
CHECKED	WFB
APPROVED	WFB