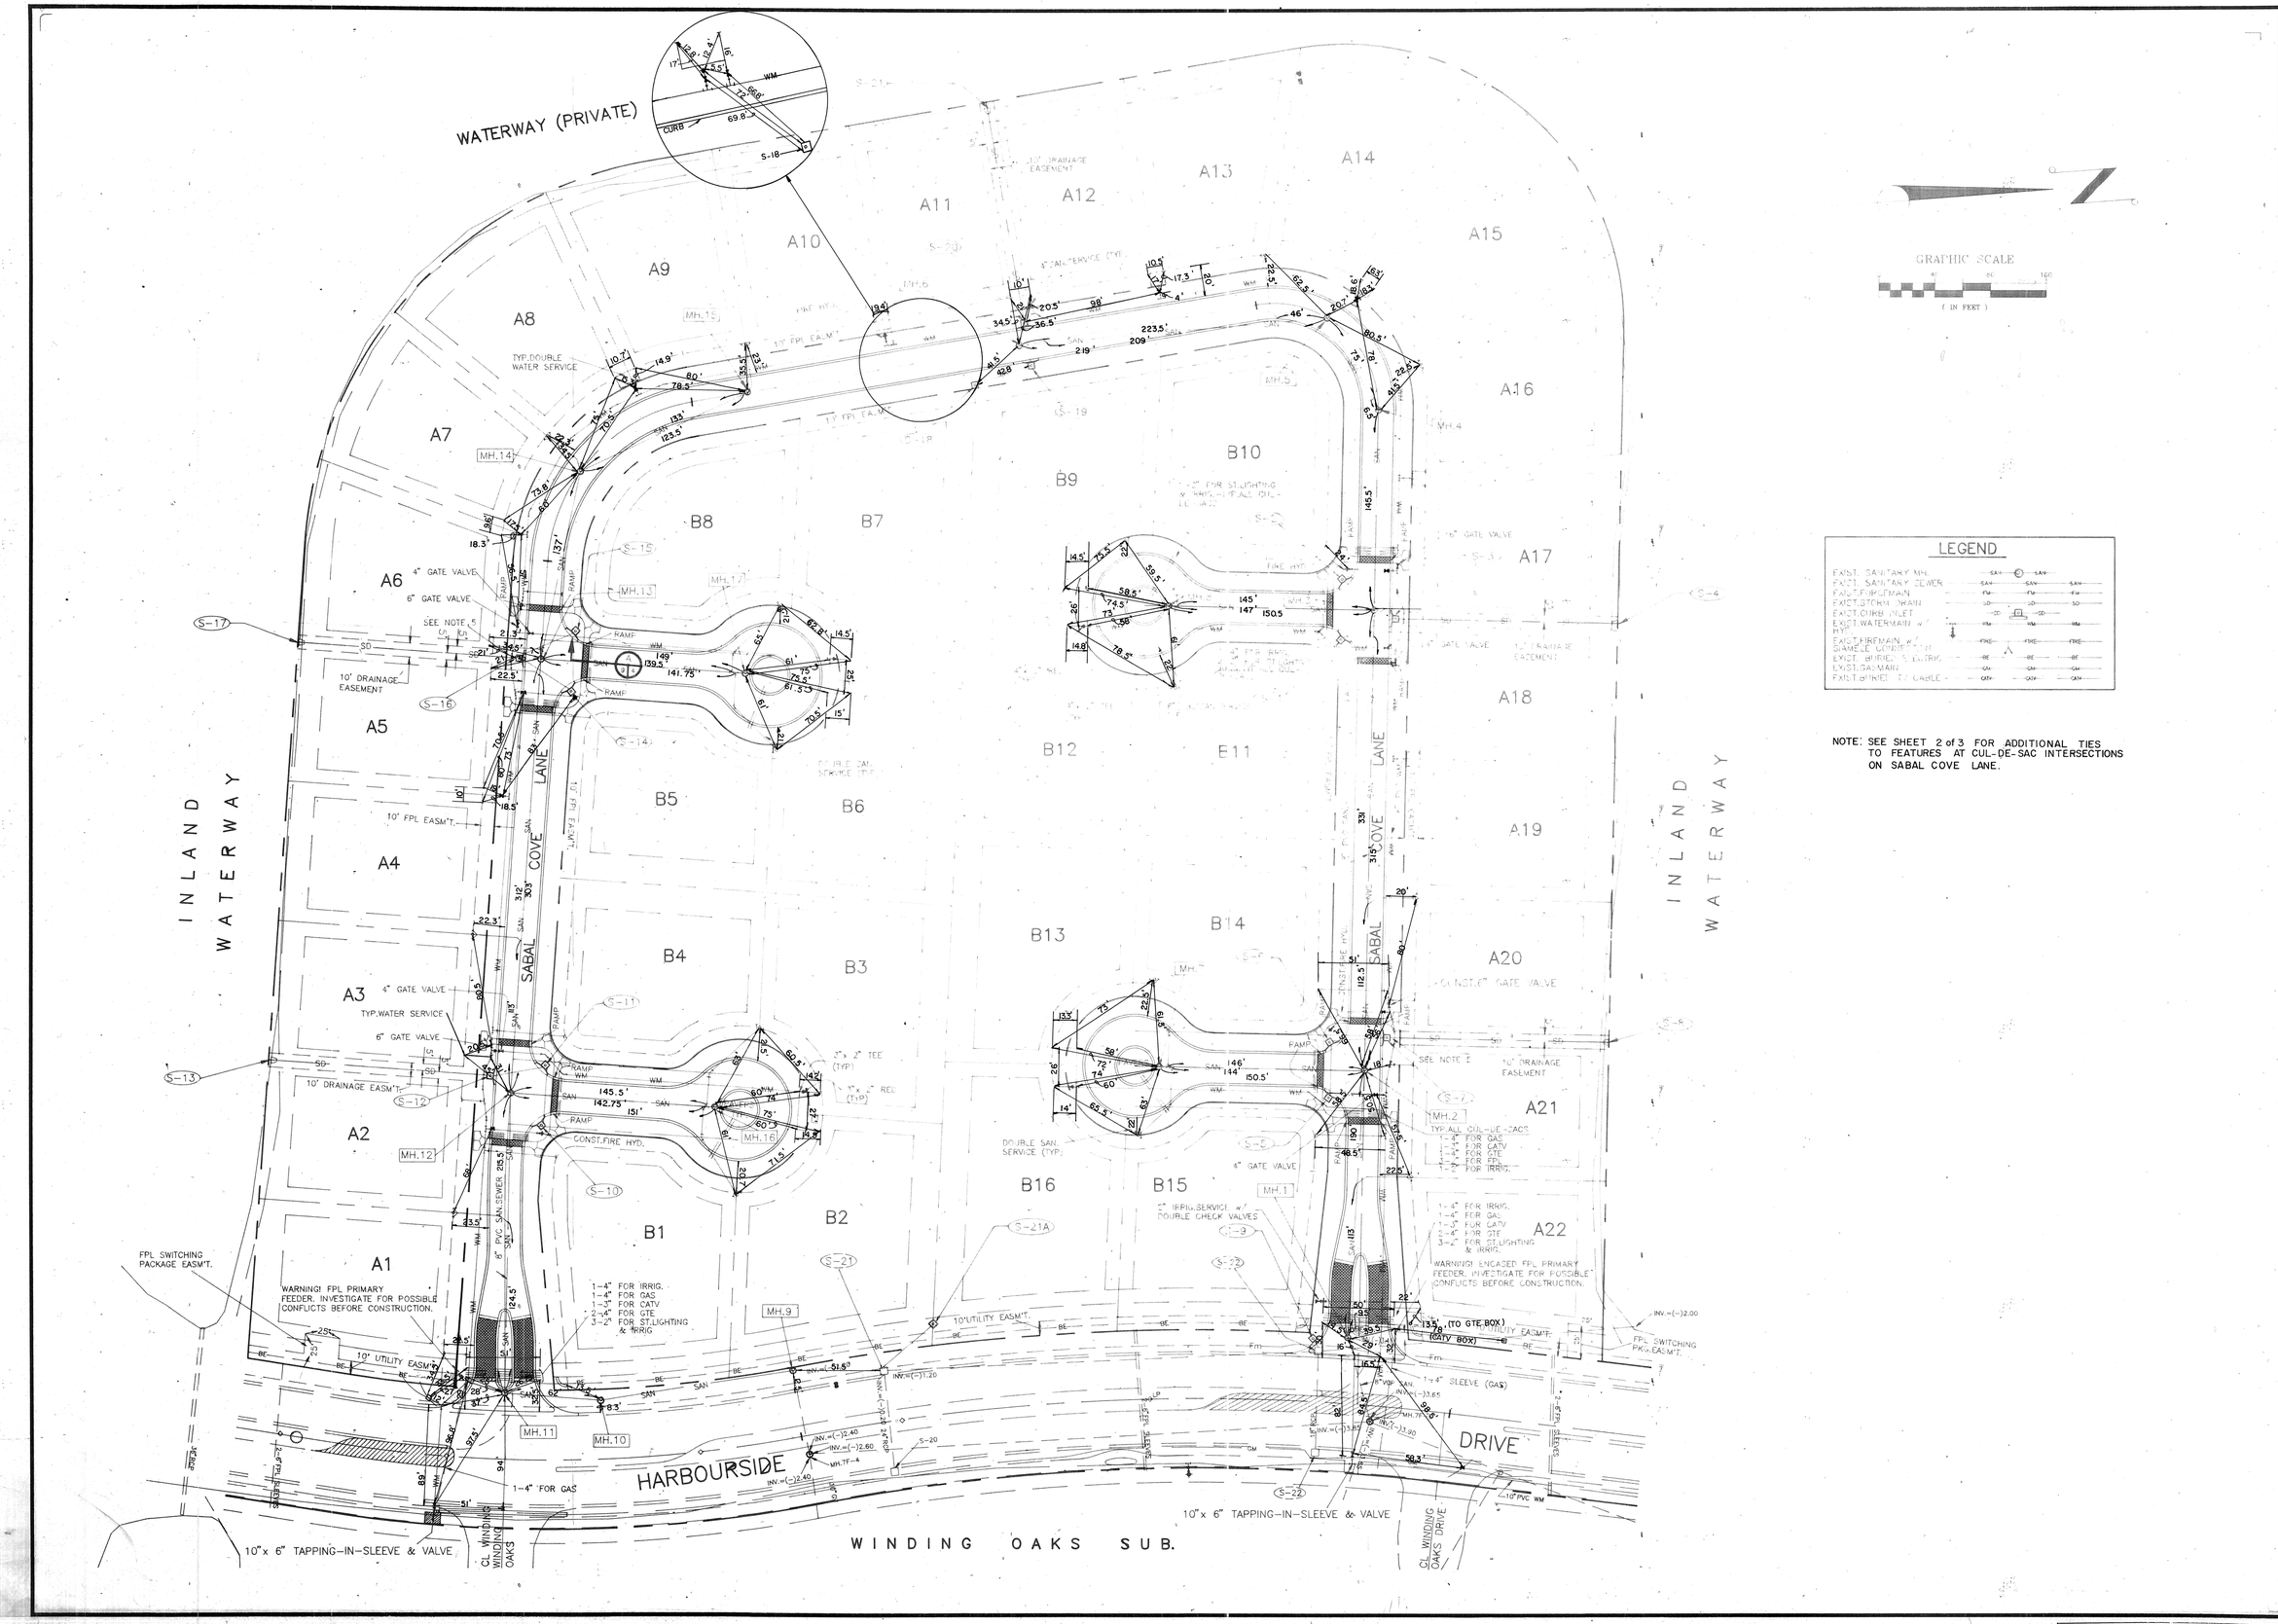

LTR.	DATE	REVISION	BY

SCALE:	DATE:	DESIGNED BY:	PROJECT ENGINEER
1" = 50'	2/06/89	S.R./F.L.C.	WILLIAM F. BISHOP
DRAWN BY	CHECKED BY	PROJECT NO.	PE No. 8189
R.W.C./T.D.	WFB	ARVD-0478	

TOWN OF LONGBOAT KEY, FLORIDA

SABAL COVE
ARVIDA / JMB PARTNERS, INC.
RECORD DRAWING

ENGINEER & LOCATION: BISHOP & ASSOCIATES, INC. CONSULTING ENGINEERS • SURVEYORS 78 Sarasota Center Blvd. Sarasota, Florida 34240 Ph (813) 371-6362

T.L.K. FILE NO.

SHEET NUMBER ARVD-0478 1 of 3

REVISION

SABAL COVE