STRUCTURE	MONUMENTS		DESCRIPTION
1	MH#4 / 62.7'	FH#2 / 138.0'	WATER SERVICE
2	MH#4 / 50.2'	FH#2 / 127.2'	BLOW OFF
3	MH#4 / 51.0'	FH#2 / 125.3'	WATER SERVICE
4	MH#4 / 27.2'	FH#2 / 84.6'	SANITARY SEWER SERVICE
5	MH#4 / 66.0'	FH#2 / 12.8'	WATER SERVICE
6	MH#4 / 70.1'	FH#2 / 8.18'	WATER SERVICE
7	MH#4 / 77.0'	FH#2 / 3.6'	WATER VALVE
8	MH#4 / 127.8'	MH#3 / 79.6'	SANITARY SEWER SERVICE
9	MH#2 / 71.7'	MH#3 / 30.7'	WATER SERVICE
10	MH#2 / 62.0'	MH#3 / 28.1'	WATER SERVICE
11	MH#2 / 43.1'	MH#3 / 42.8'	SANITARY SEWER SERVICE
12	MH#2 / 33.0'	MH#3 / 47.7'	WATER SERVICE
13	MH#2 / 28.1'	MH#5 / 27.8'	WATER SERVICE
14	MH#2 / 50.6'	MH#5 / 29.1'	SANITARY SEWER SERVICE
15	FH#1 / 22.3'	MH#6 / 115.6'	WATER SERVICE
16	FH#1 / 15.6'	MH#6 / 109.4'	WATER SERVICE
17	FH#1 / 4.3'	MH#6 / 93.9'	WATER VALVE
18	FH#1 / 52.0'	MH#6 / 44.2'	SANITARY SEWER SERVICE
19	FH#1 / 116.7'	MH#6 / 42.7'	WATER SERVICE
20	FH#1 / 128.5'	MH#6 / 35.2'	WATER SERVICE
21	MH#6 / 23.0'	FH#1 / 96.1'	SANITARY SEWER SERVICE
22	MH#6 / 38.7'	FH#1 / 76.1'	SANITARY SEWER SERVICE
23	MH#6 / 89.0'	FH#1 / 53.5'	WATER SERVICE
24	MH#6 / 95.1'	FH#1 / 53.9'	WATER SERVICE
25	MH#5 / 50.8'	FH#1 / 82.0'	SANITARY SEWER SERVICE
26	FH#1 / 41.9'	MH#5 / 93.0'	WATER SERVICE
27	FH#2 / 75.1'	MH#4 / 52.2'	SANITARY SEWER SERVICE
28	MH#6 / 154.8'	1 / 99.0'	WATER VALVE

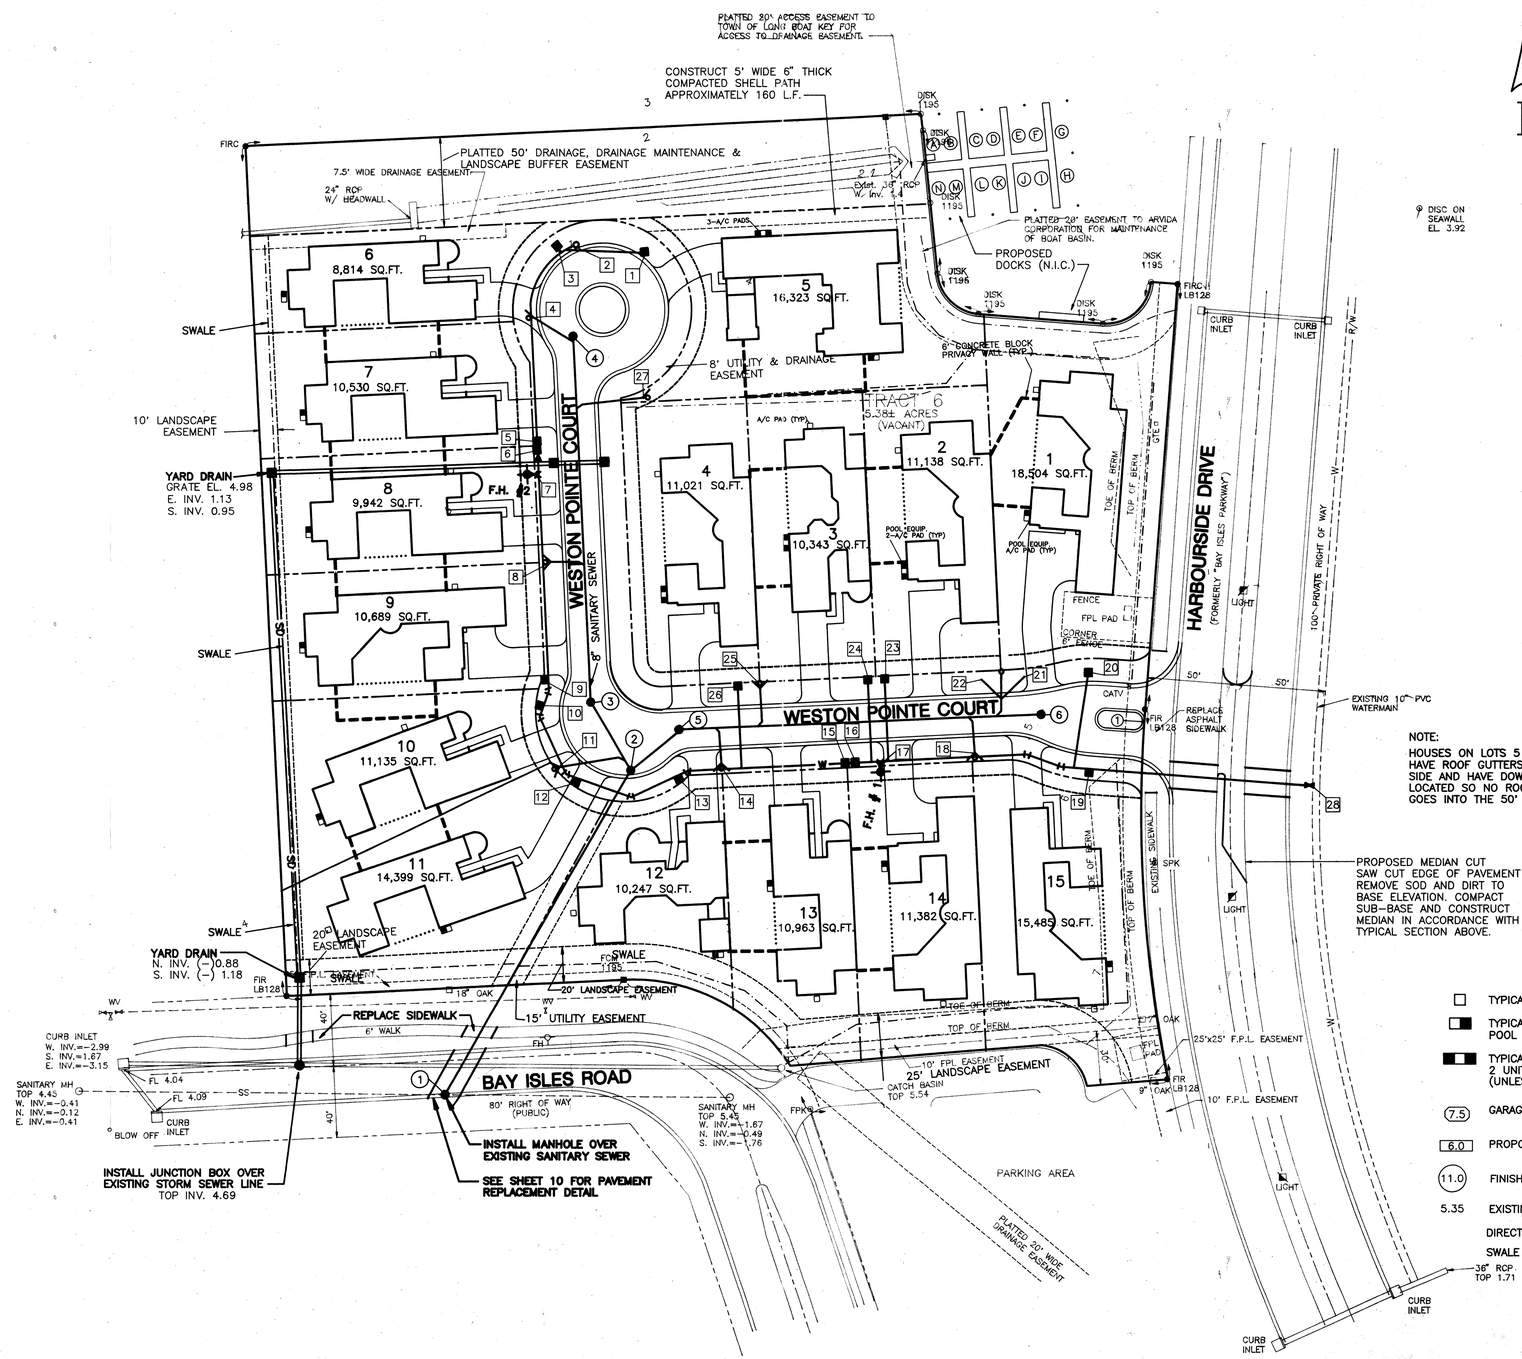

RECORD DRAWING

18	5/18/93	ADD RECORD DRAWING INFORMATION	DBH
17	3/16/93	ADD SWALES, SECTION F-F	DBH
16	3/9/93	MOVE UNIT 1,7,8,& 11	DBH
15	3/5/93	ADD SWALE & CROSS SECTIONS. ADD GRADES	DSM
14	2/19/93	REVISE UNIT 1 & 11	DSM
13	2/17/93	REVISE LOT COVERAGE TABLE	DBH
12	2/16/93	CHANGE LOT 14 TO "G" FLOORPLAN, ADD GAS LINE	DBH

11	2/9/93	MOVE UNITS 13, 14, & 15	DBH
10	2/8/93	ADD GARAGE FOR UNIT 6	DBH
9	1/28/93	ADD POOL & A/C PADS, REV. UNIT 10	DBH
8	1/22/93	ADD COURTYARD WALLS	DBH
7	1/18/93	ADD SIDEWALKS	DBH
6	1/15/93	REV. HARBOUR DRIVE, 11 & ADD WALL	DBH
5	1/13/93	REV. LOT 10 & 11 BLDG. LOCATIONS	DBH
4	1/11/93	REV. LOT 15 PER P. SPENCER	DBH
3	1/7/93	REV. BLDG. FOOTPRINTS PER P. SPENCER	DBH
2	1/4/93	REV. BLDG. SIZES & LOCATIONS	DBH
1	10/8/92	ADD BOAT SLIP DESIG., FLIP BLDG. 3	DBH

MINDER & RHODES ENGINEERING CORPORATION

Engineers - Planners - Surveyors

3900 CLARK ROAD
SARASOTA, FL. 34233
(813) 922-7505

Designed: MJR | Checked: DBH | Date: 5/9/92
Drawn: DBH | Scale: 1"=40' | Prj. No. S1088

APPROVED
P.E. No. 33150
Date 12/10/93
Dwg. No. S1088NEW

WESTON POINTE
LONGBOAT KEY
SARASOTA COUNTY, FLORIDA

GRADING & GENERAL SITE PLAN

SHEET
4

5/18/93