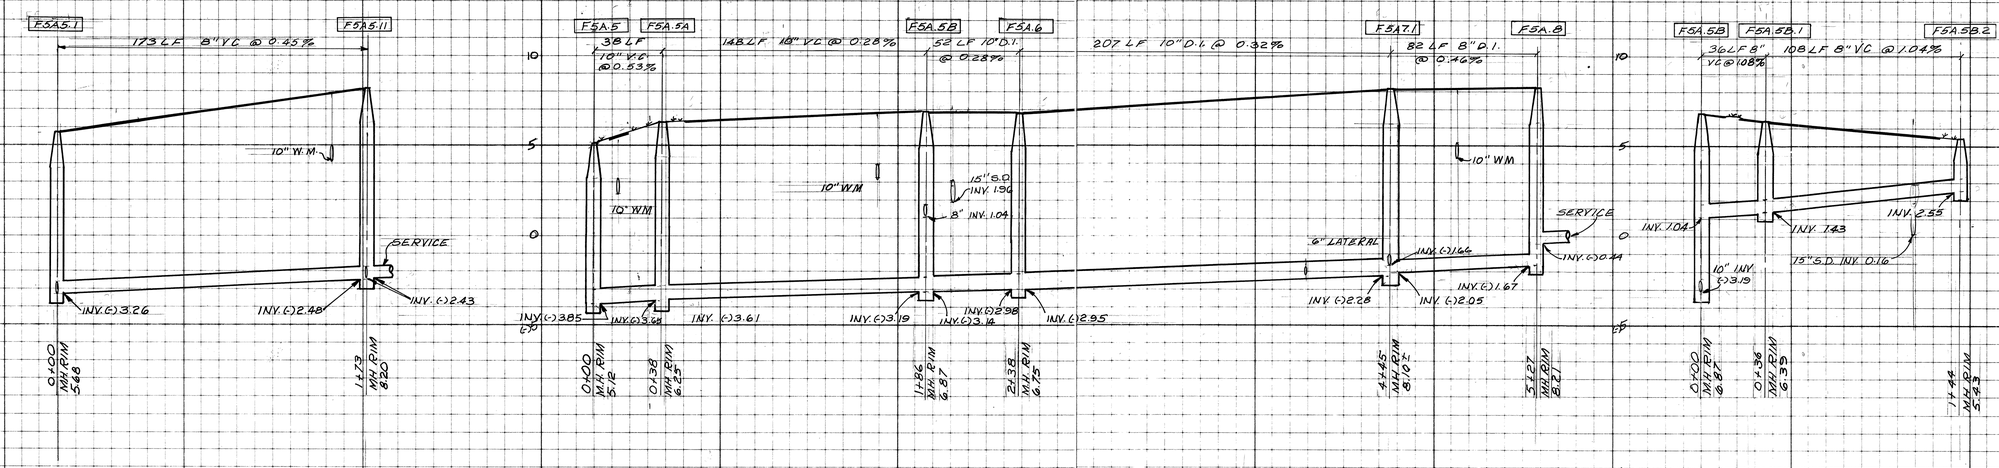

LTR.	DATE	REVISION	BY

PROJECT ENGINEER: Marc S. Chandler

DESIGNED BY | PROJECT NO

DATE 4-8-88 | CHECKED BY M.B.

SCALE: H. 1" = 40' V. 1" = 4' | DRAWN BY STAFF

TOWN OF LONGBOAT KEY, FLORIDA

ARVIDA CORPORATION

TOWN PLAZA – PHASE II

SANITARY SEWER PROFILES RECORD DRAWING

ENGINEER & LOCATION

SHEET NUMBER ARVD-0037 2 of 2

REVISION

T.L.K. FILE NO.