




REFERENCE PARKING @ 4 PER 1000 FT.² = 92 MAXIMUM
 PARKING PROVIDED = 76

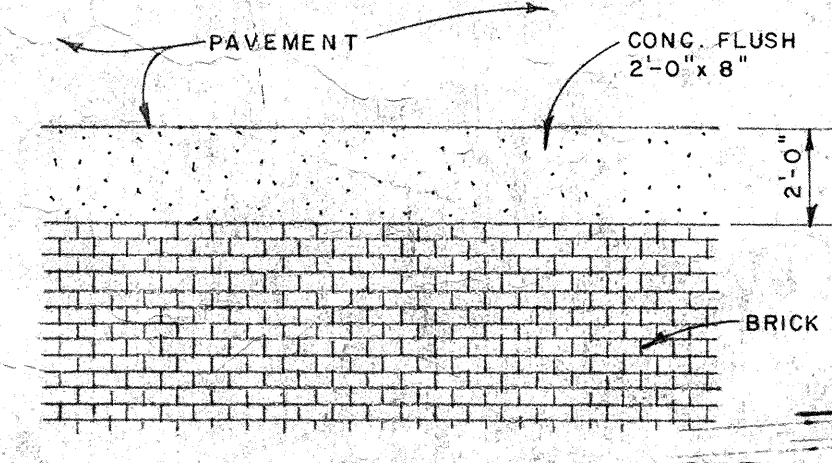

BRICK PAVING PLAN
 NO SCALE

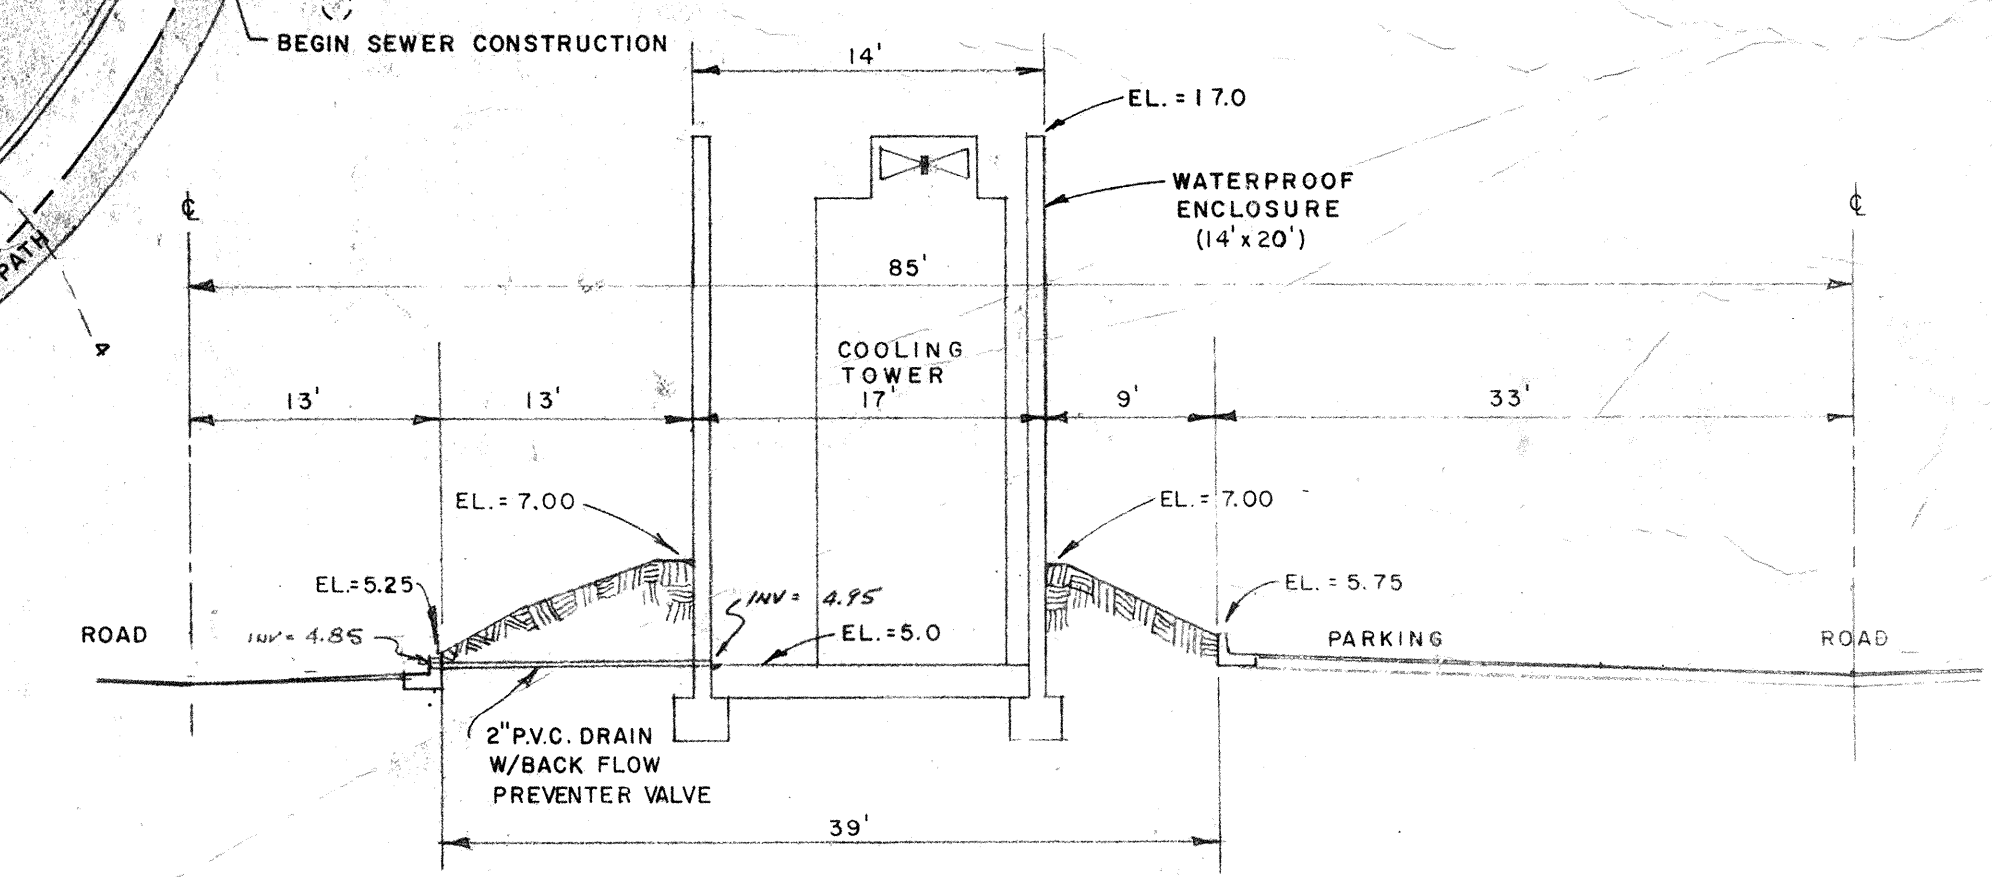

SECTION B
 SCALE HORZ. 1" = 10'
 VERT. 1" = 4'

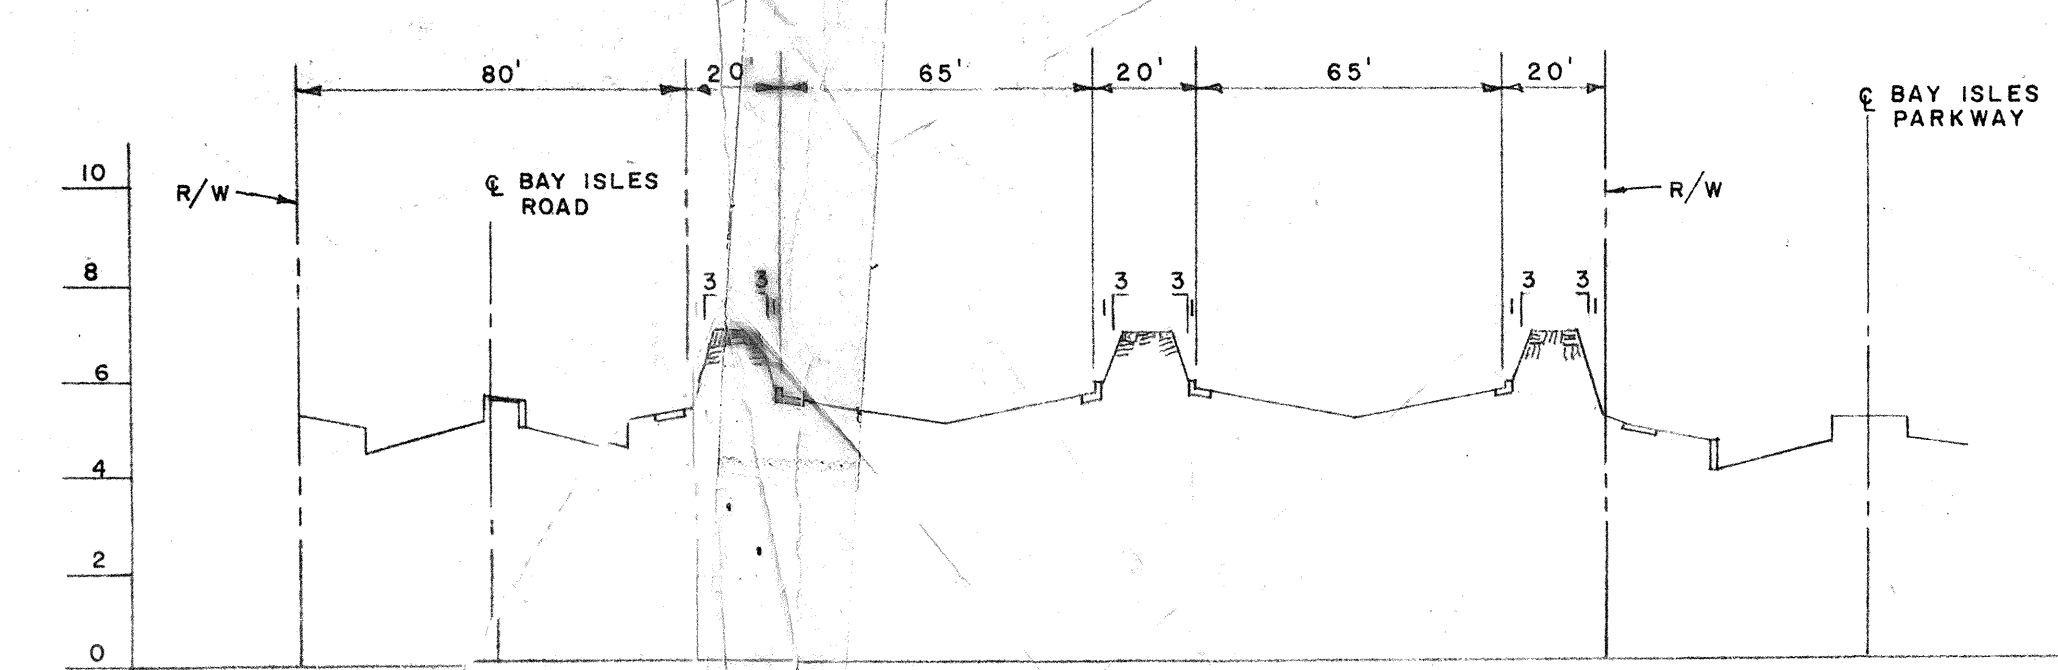

SECTION A
 SCALE HORZ. 1" = 40'
 VERT. 1" = 4'

- LEGEND**
- EXISTING STORM SEWER
 - EXISTING SANITARY SEWER
 - EXISTING WATER SYSTEM
 - PROPOSED STORM SEWER SYSTEM
 - PROPOSED SANITARY SEWER SYSTEM
 - PROPOSED WATER SUPPLY SYSTEM
 - EXISTING CONTOURS
 - PROPOSED GRADE ELEVATIONS
 - PROPOSED CONTOURS
 - PROPOSED TOP OF CURB ELEVATIONS
 - PROPOSED TOP OF WALL ELEVATIONS
 - CURB CUT RAMP

ARVIDA CORPORATION
 CIVIL ENGINEERING
 191
 BAY ISLES CIVIC COMMERCIAL CENTER