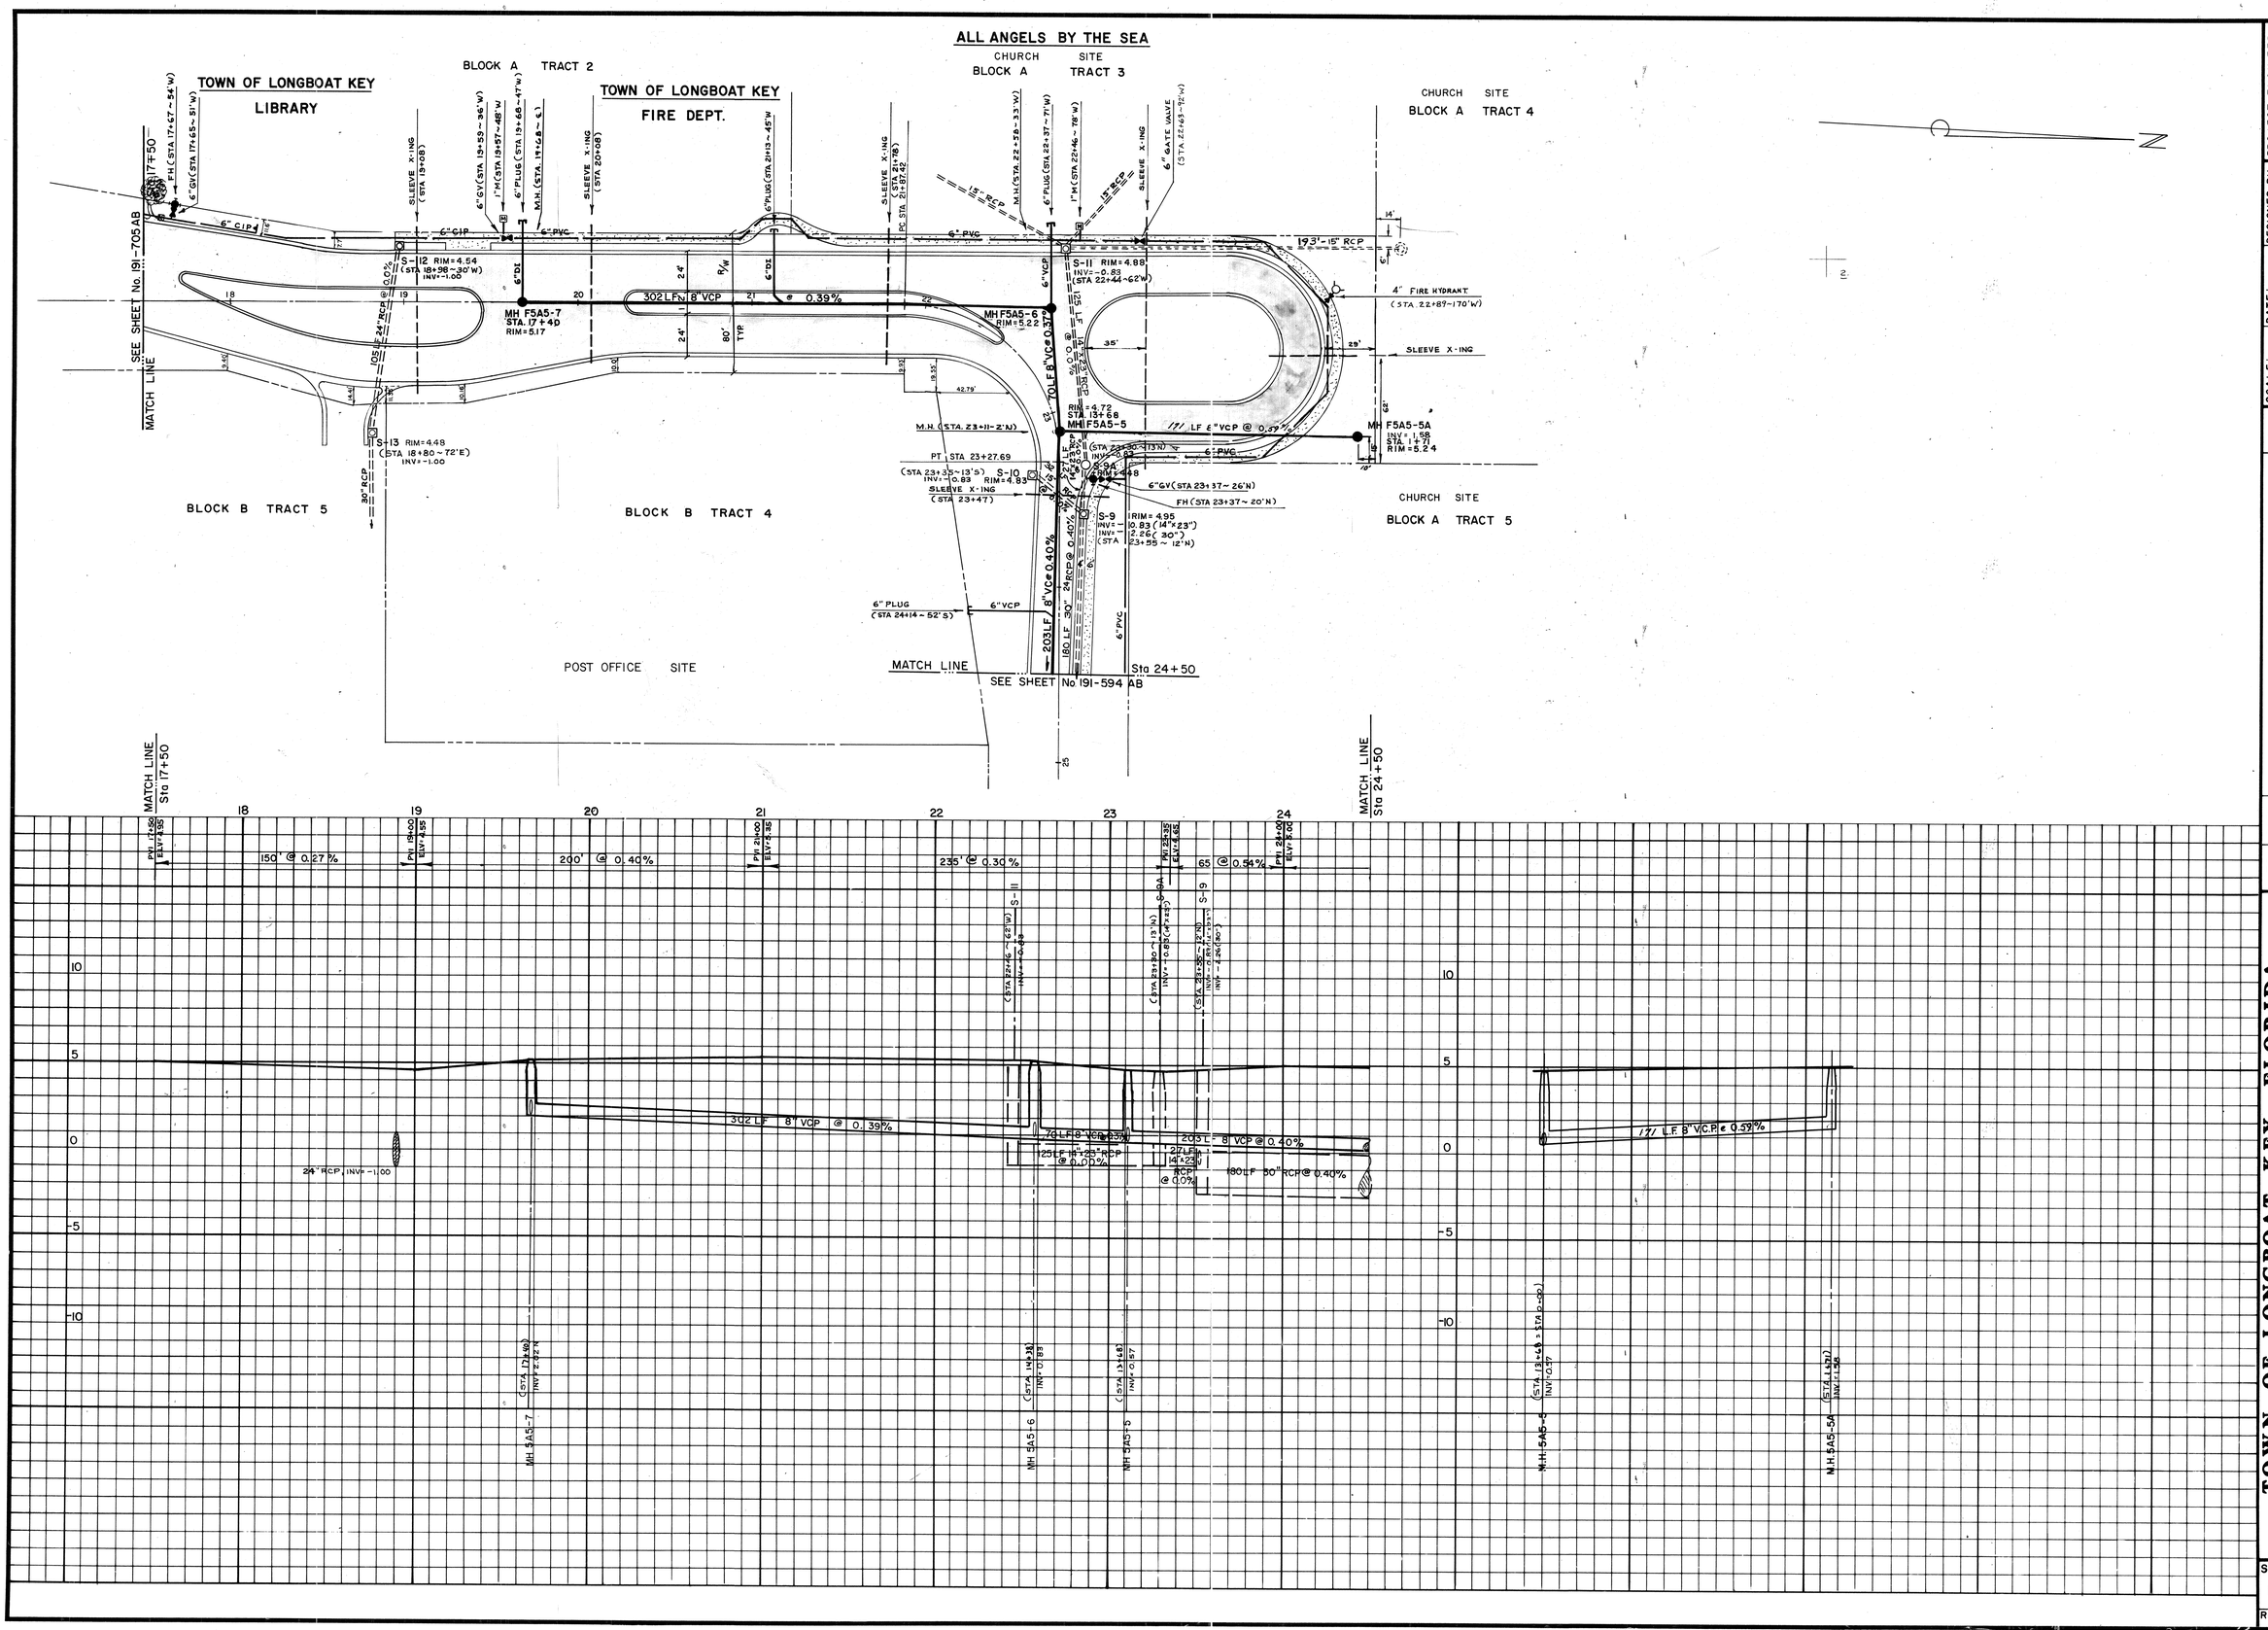

PROJECT ENGINEER	
DESIGNED BY	
DATE: JAN., 1983	
PROJECT NO.	
SCALE: 1"=40' HORIZ. 1"=4' VERT.	
CHECKED BY	
DRAWN BY D. DALLAS	

LTR.	DATE	REVISION	BY

TOWN OF LONGBOAT KEY, FLORIDA

AS-BUILT

ARVIDA CORPORATION

BAY ISLES ROAD

SARASOTA, FLORIDA

ENGINEER & LOCATION: BENNETT & BISHOP INC. ENGINEERS & SURVEYORS 4509 BEE RIDGE ROAD

SHEET NUMBER: 191-593 AB

REVISION

T.L.K. FILE NO.