

ALL ANGELS BY THE SEA

CHURCH SITE
BLOCK A TRACT 3

CHURCH SITE
BLOCK A TRACT 4

TOWN OF LONGBOAT KEY
LIBRARY

TOWN OF LONGBOAT KEY
FIRE DEPT.

BLOCK A TRACT 2

SEE SHEET No. 191-705 AB
MATCH LINE
Sta 17+50

BLOCK B TRACT 5




BLOCK B TRACT 4

POST OFFICE SITE

MATCH LINE

SEE SHEET No. 191-594 AB
Sta 24+50

MATCH LINE
Sta 24+50

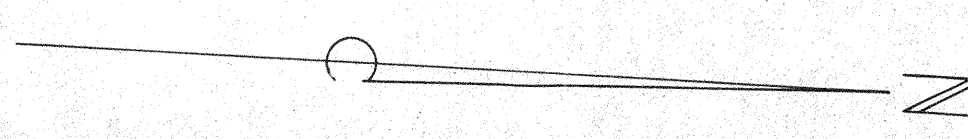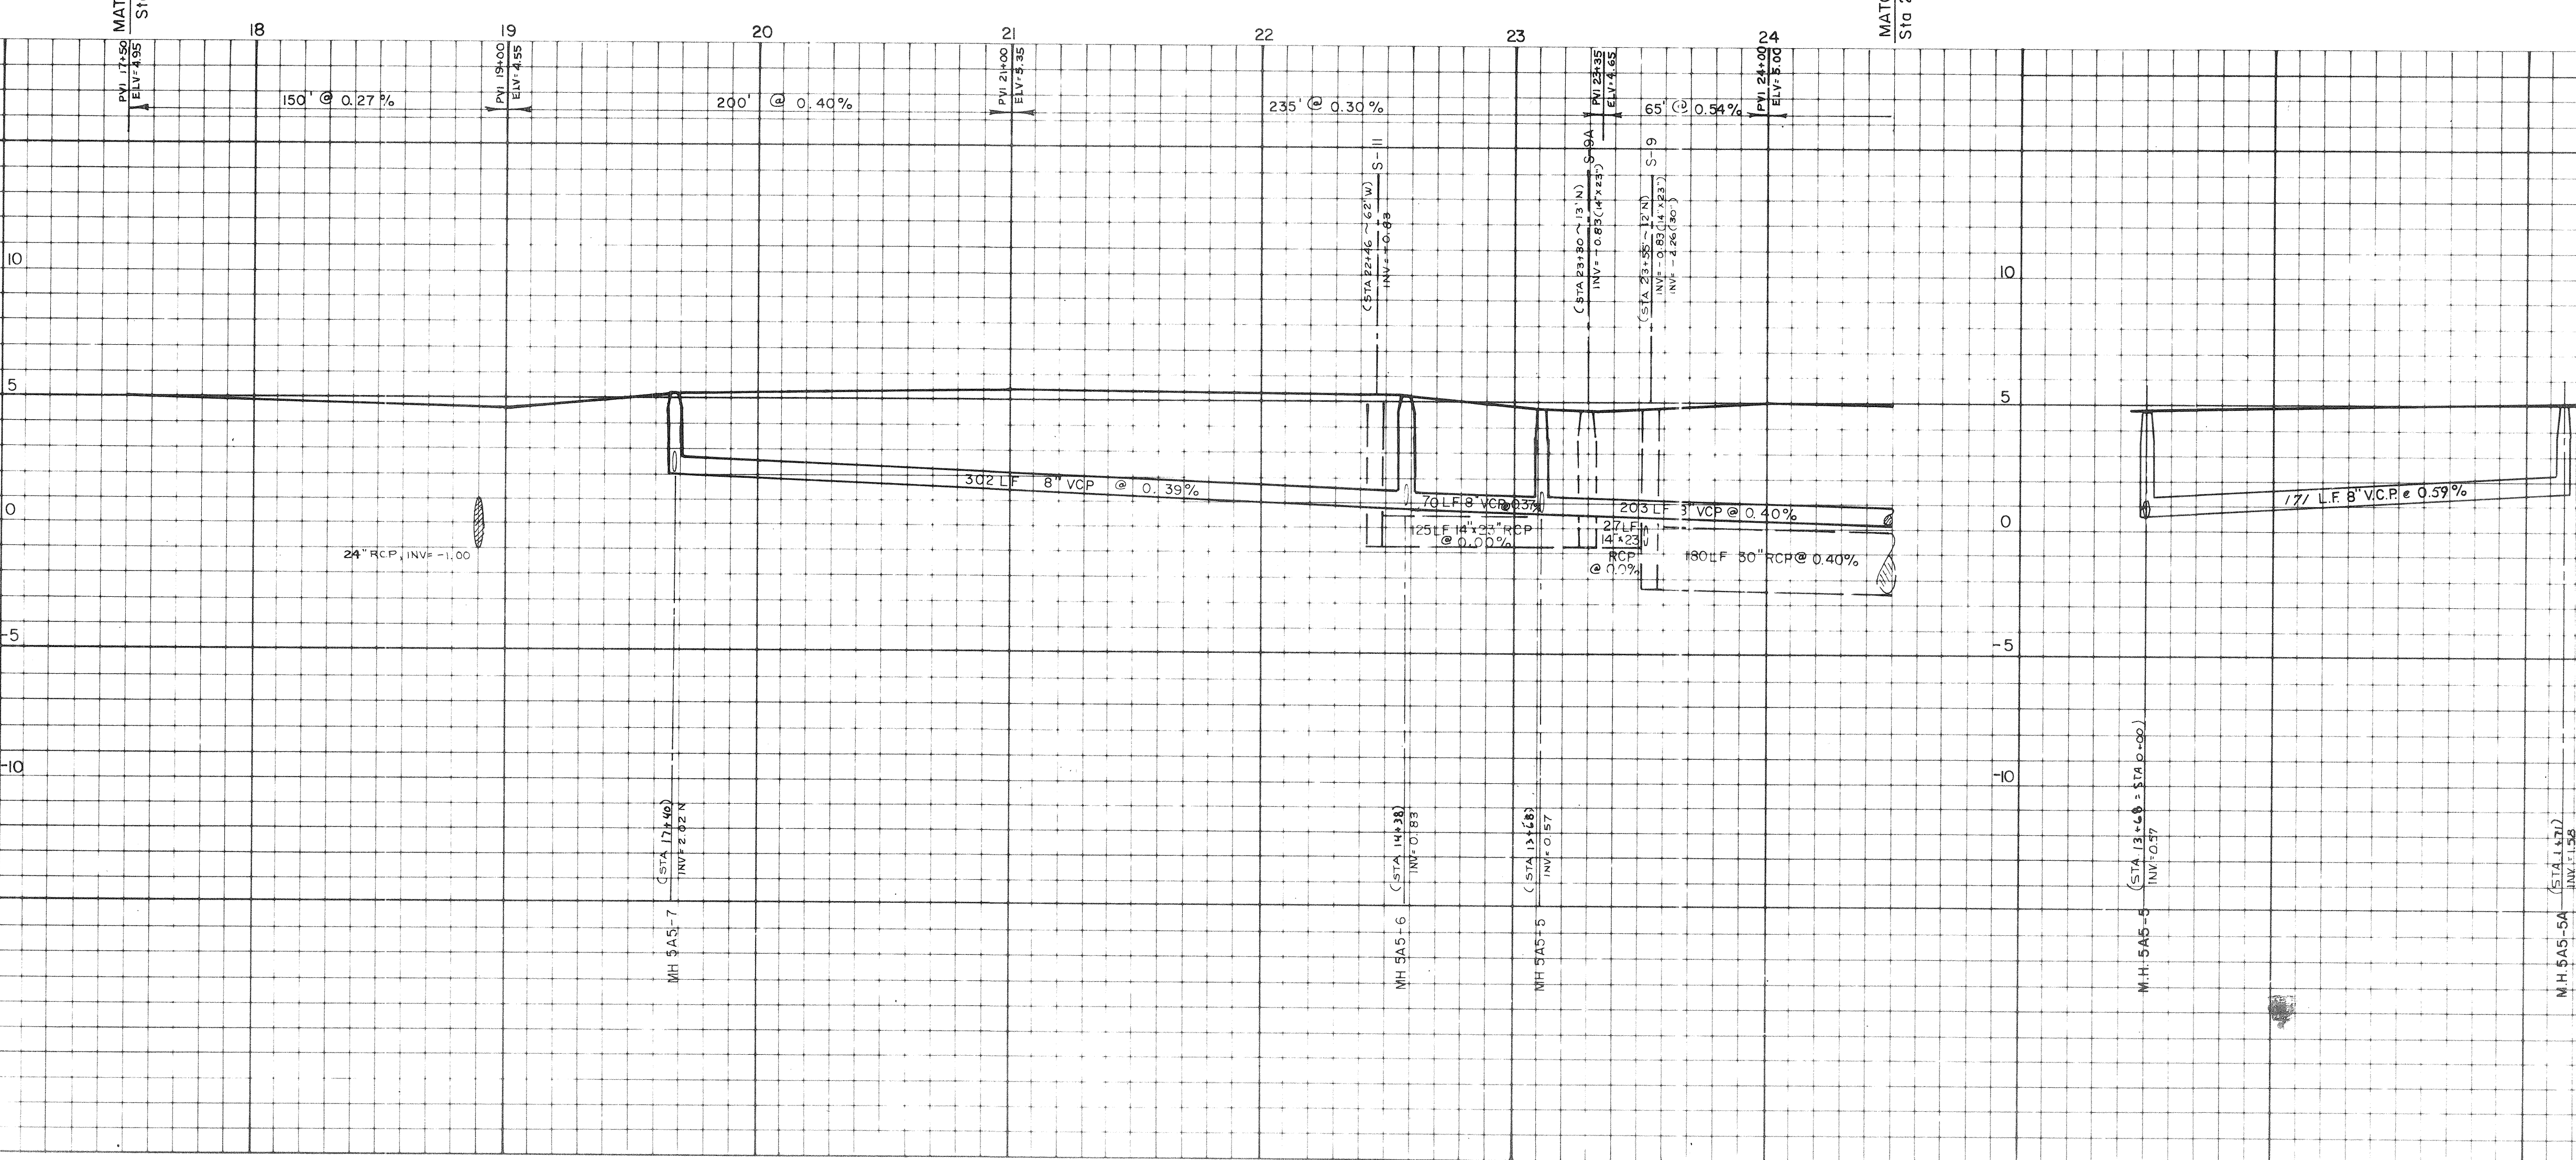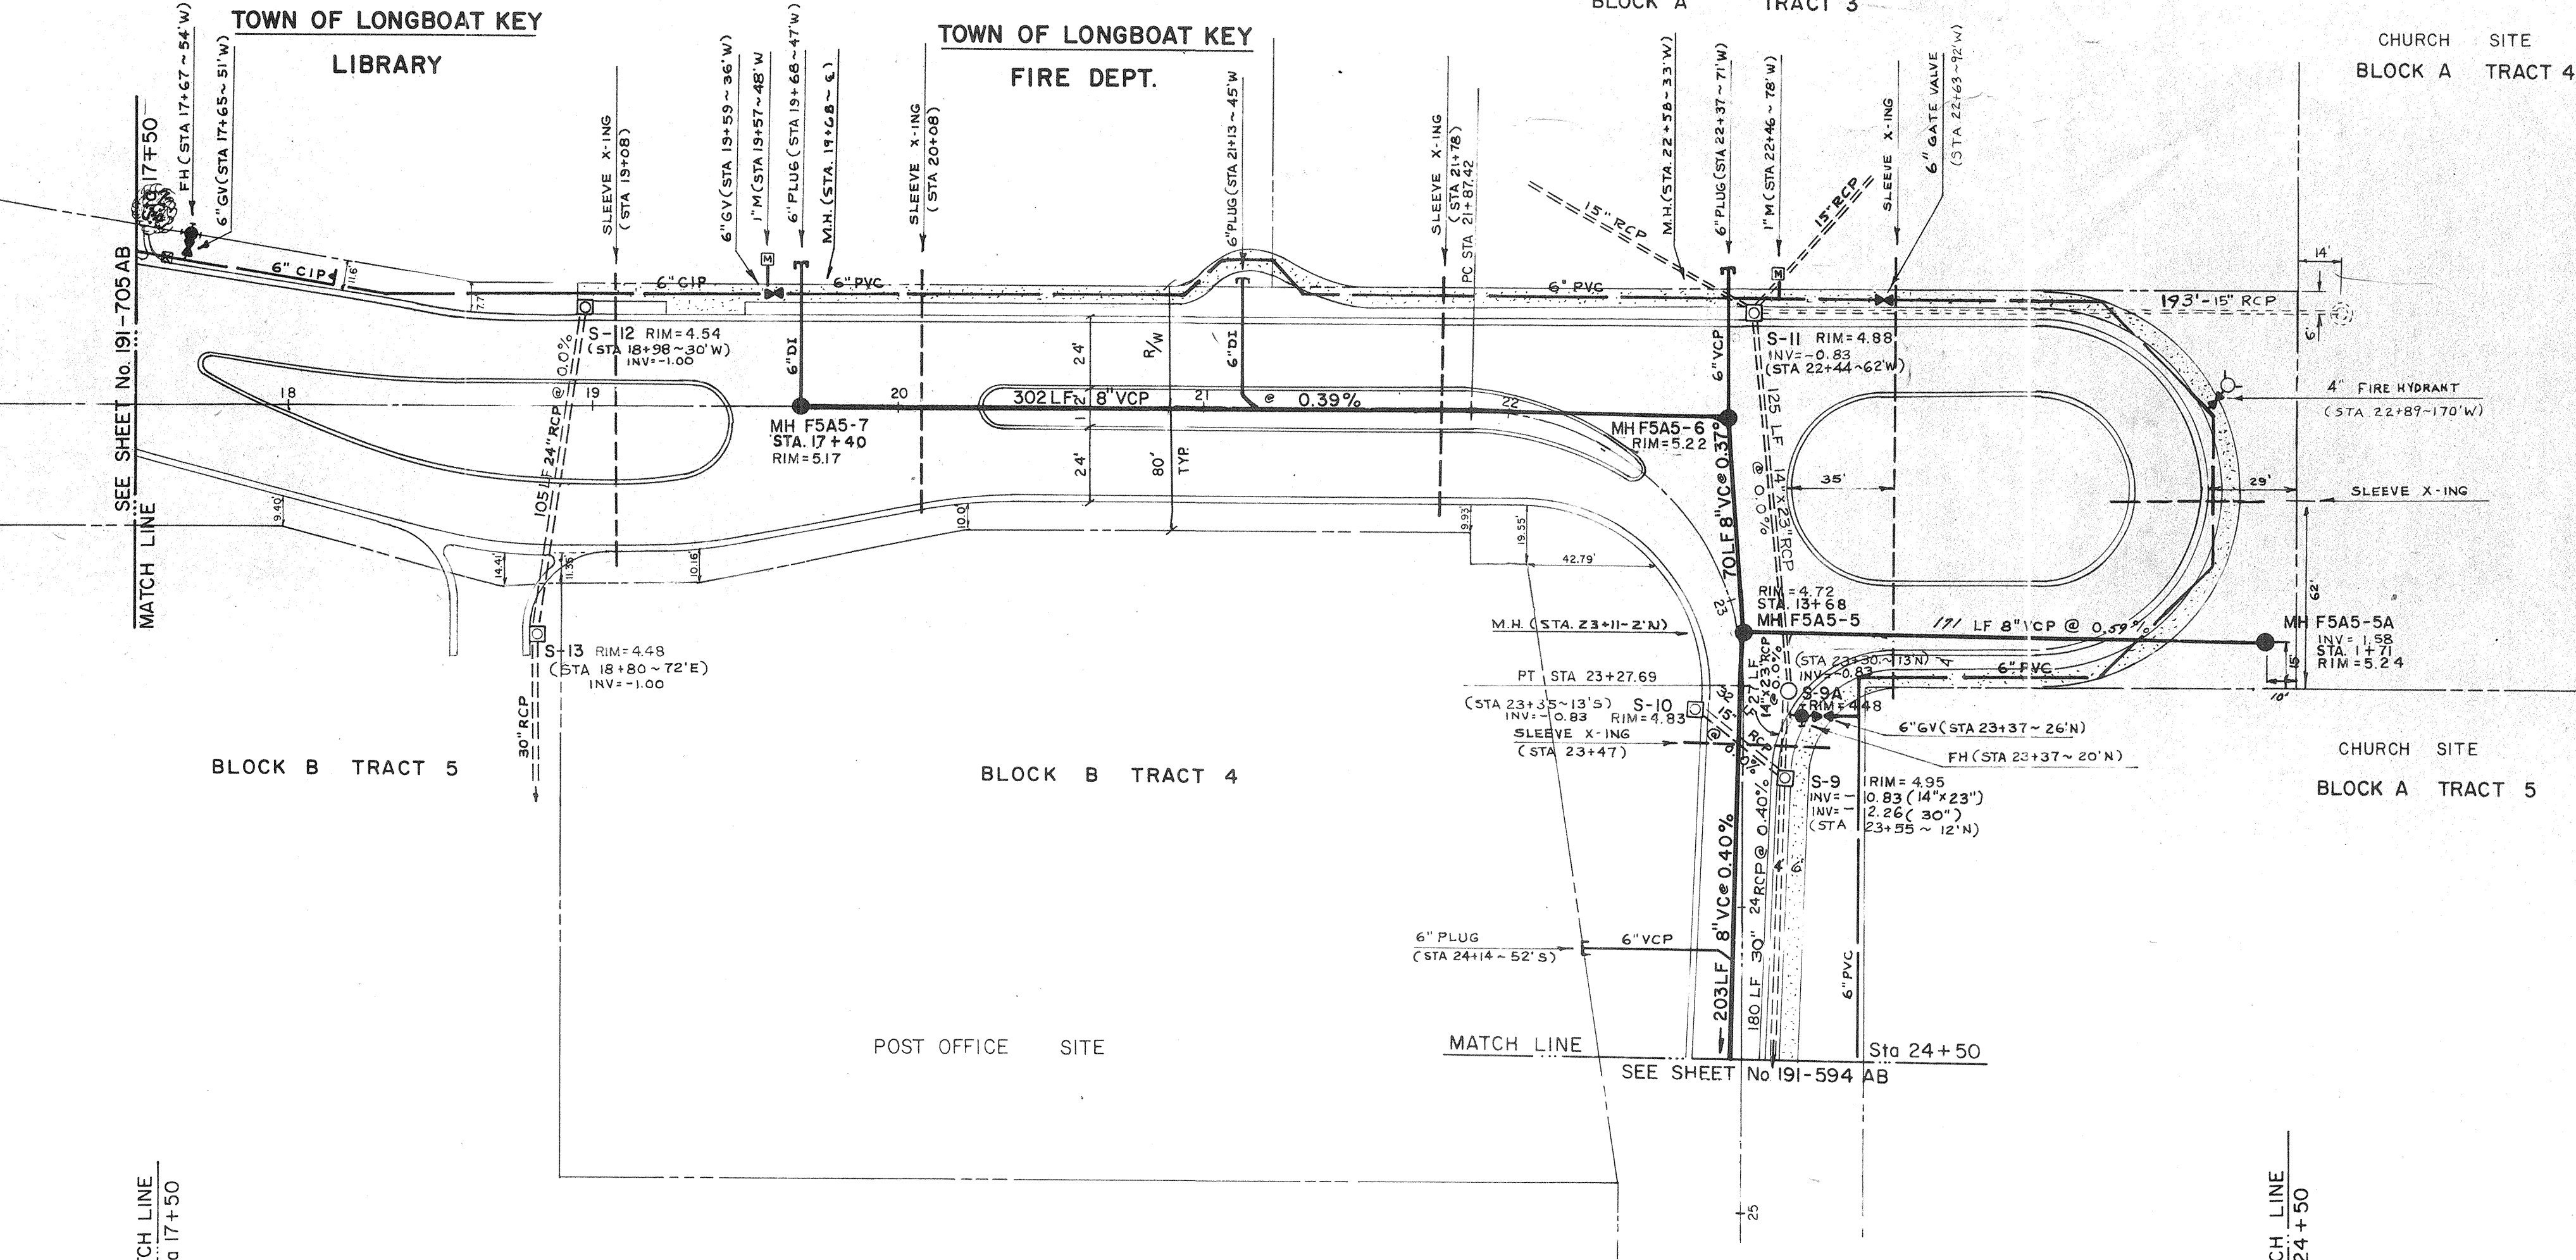

TOWN OF LONGBOAT KEY, FLORIDA		DESIGNED BY PROJECT ENGINEER	
ARVIDA CORPORATION		DATE: JAN. 1983	
BAY ISLES ROAD		CHECKED BY PROJECT NO.	
BENNETT & BISHOP INC. ENGINEERS & SURVEYORS		DRAWN BY D. DALLAS	
4509 BEE RIDGE ROAD SARASOTA, FLORIDA		BY	
SHEET NUMBER 191-593 AB		SCALE: 1" = 4' HORIZ. 1" = 4' VERT.	
REVISION		T.L.K. FILE NO.	