


BAYOU SOUND

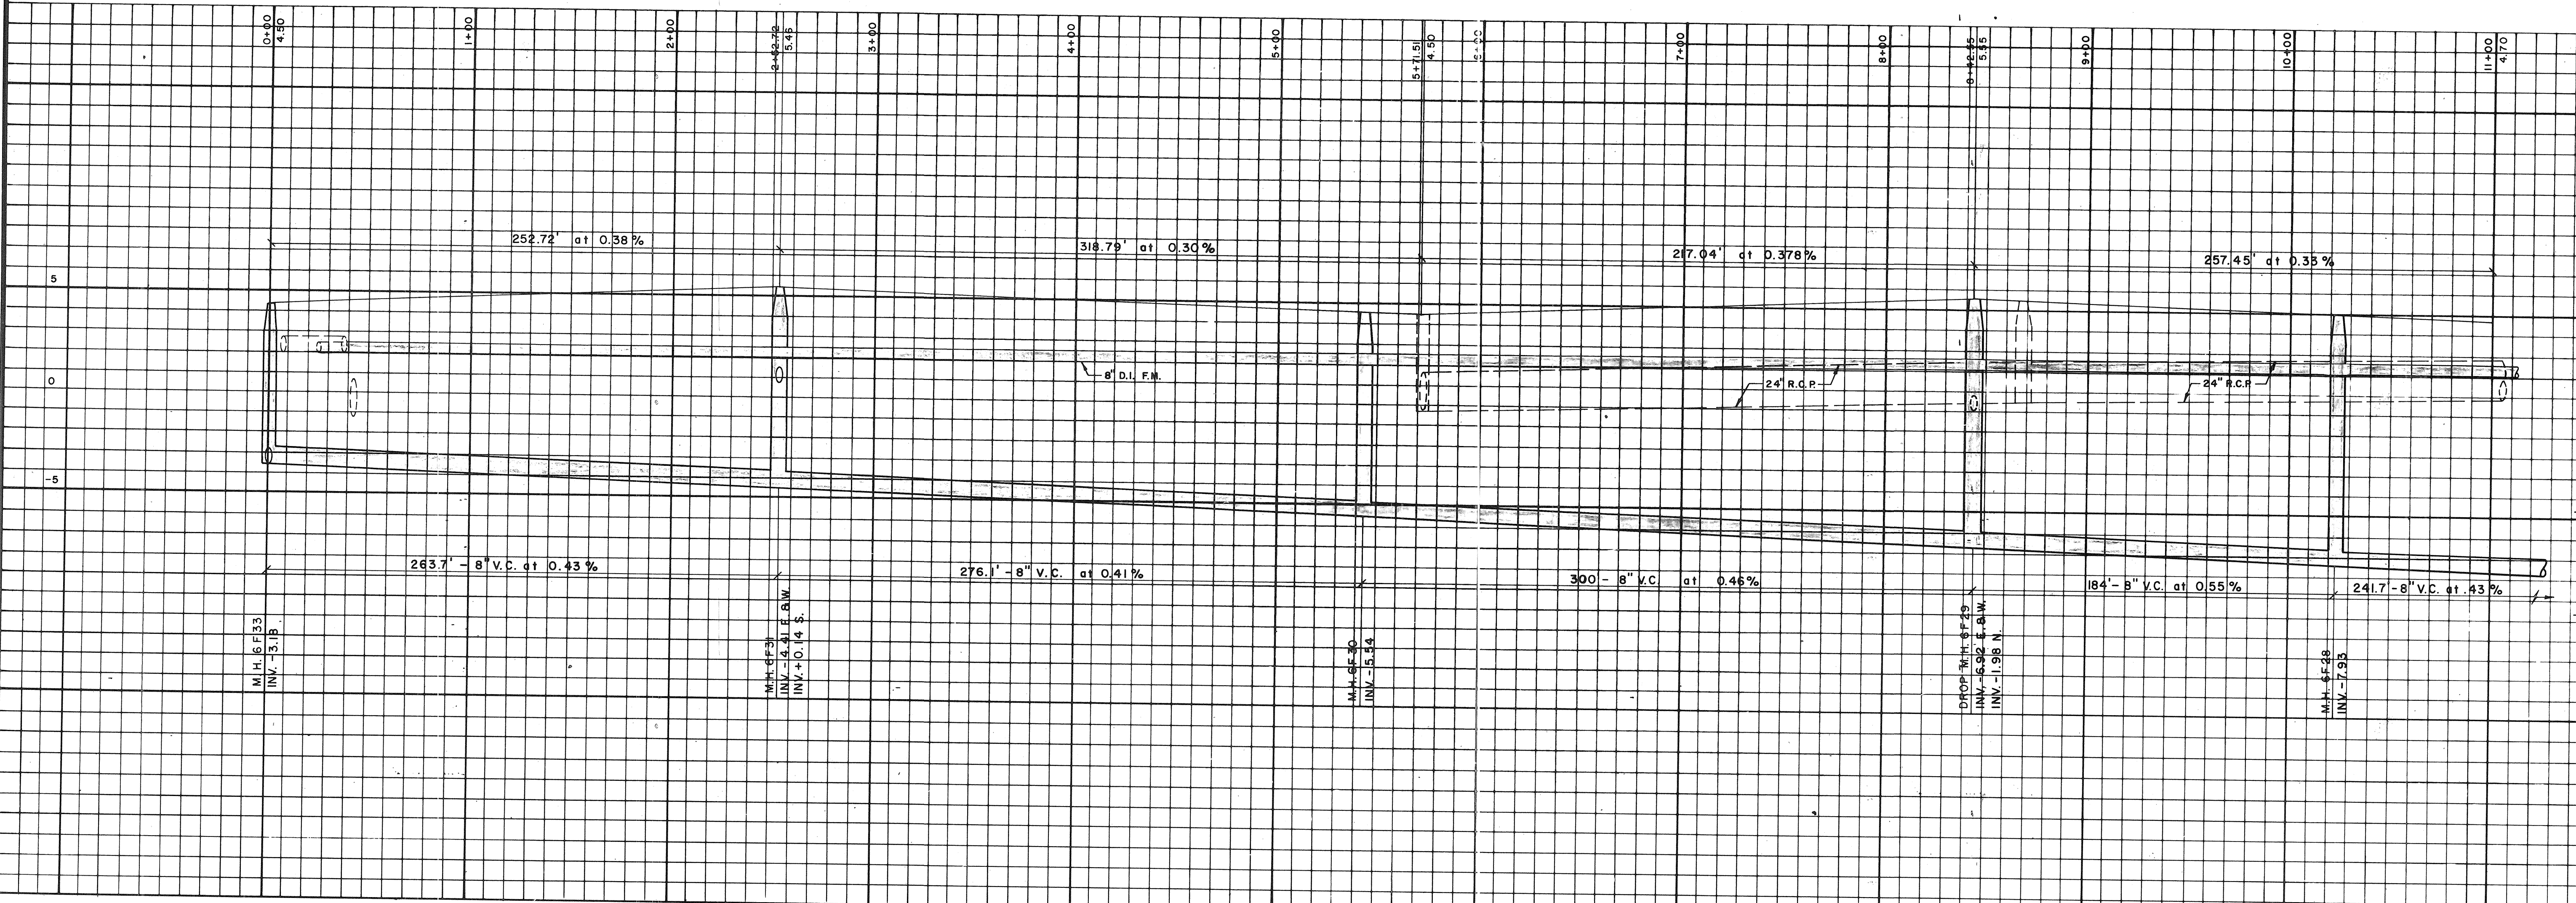

DESIGNED BY	PROJECT ENGINEER
DATE:	
CHECKED BY	PROJECT NO.
DRAWN BY	
REVISION	
L.T.R.	DATE
TOWN OF LONGBOAT KEY, FLORIDA	
ARVIDA CORPORATION	
BAY ISLES UNIT NO. 2	
WATER DISTRIBUTION & SEWAGE COLLECTION	
BENNETT & BISHOP, INC. - CONSULTING ENGINEERS & SURVEYORS - 4509 BEE RIDGE RD., SARASOTA, FLORIDA	
ENGINEER	
LOCATION	
SHEET NUMBER	191-137 AB
REVISION	

T.L.K. FILE NO.