
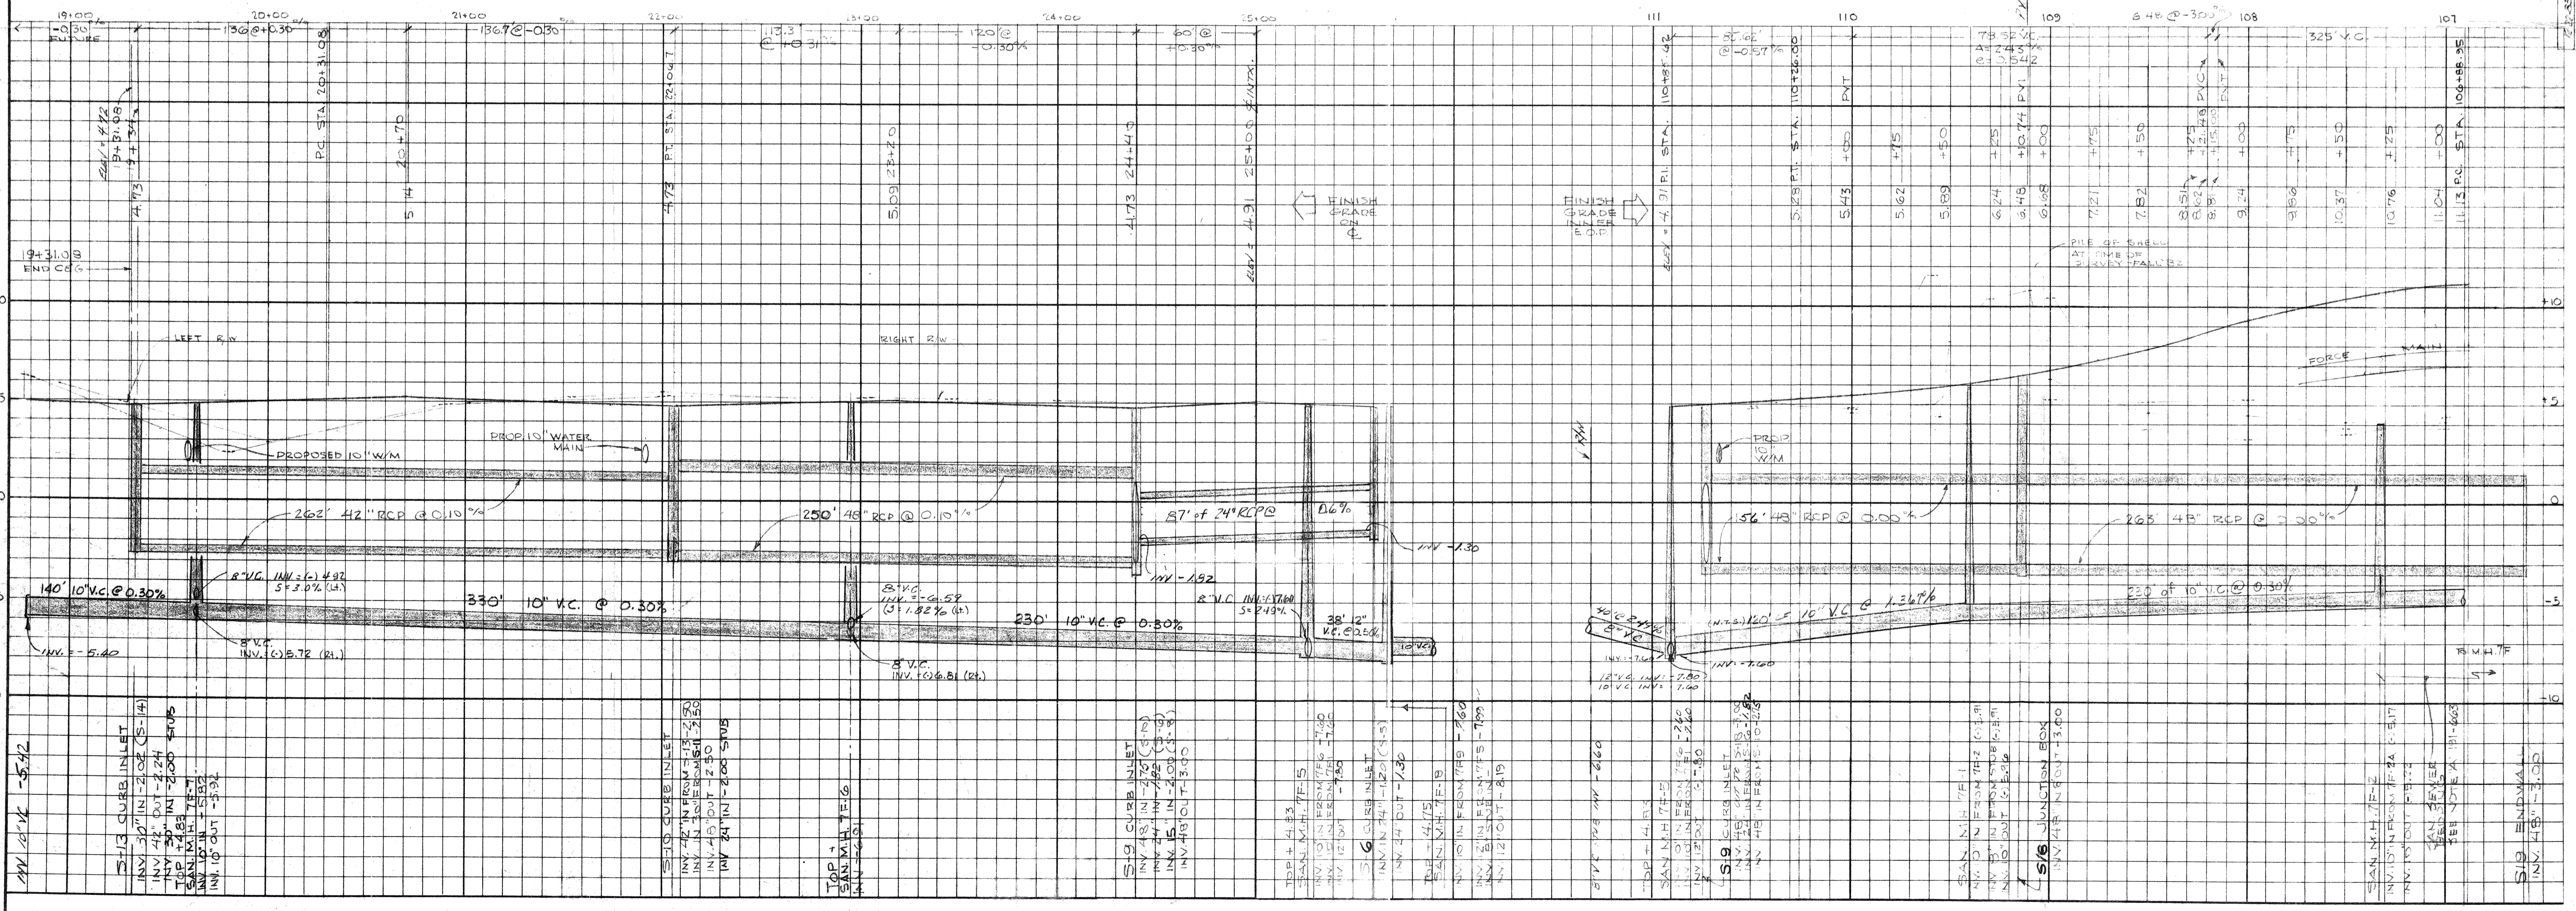


- NOTES
- PIPE SLEEVES - INSTALL IN LOCATIONS INDICATED. MIN 1" SEPARATION. MIN 36" COVER
 - TEST PIT REQUIRED. SEE NOTE 2 (DWG. 191-665)

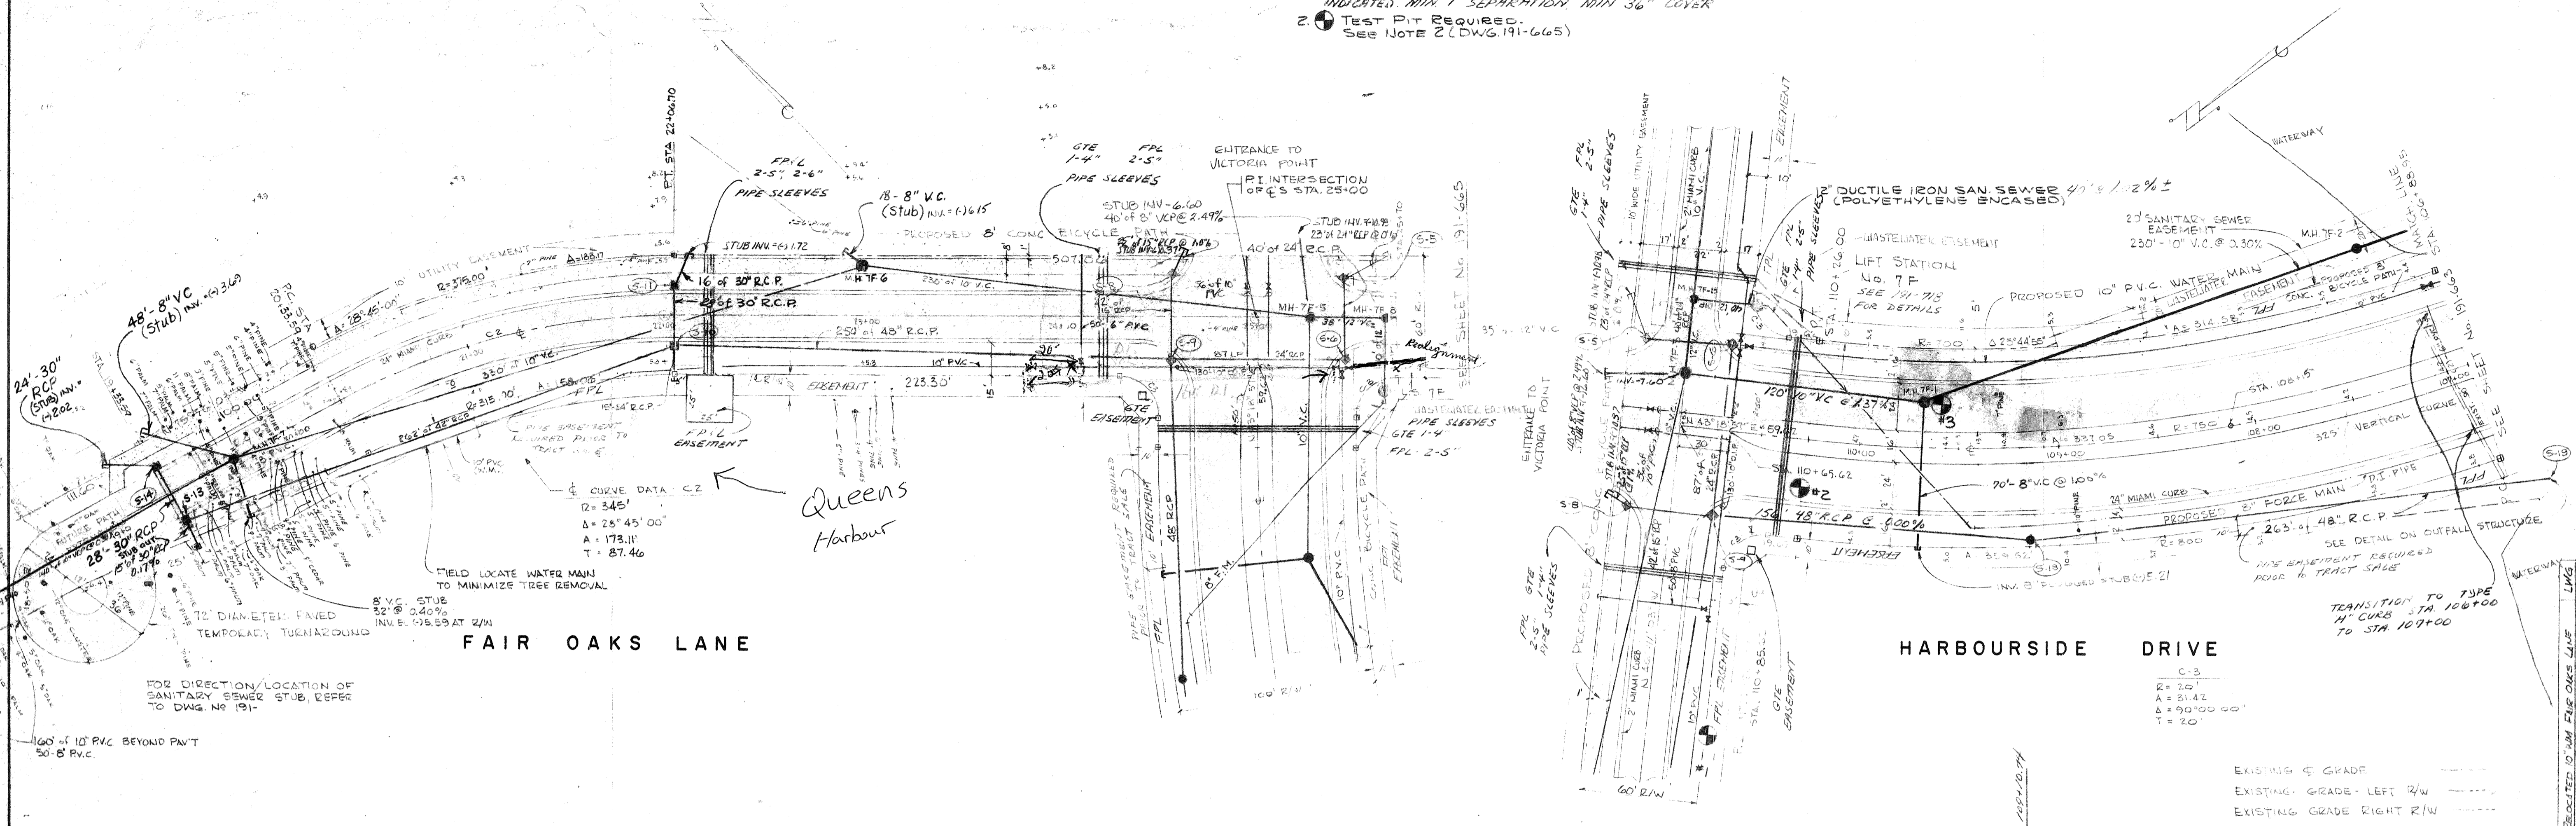

BENNETT & BISHOP
CONSULTING ENGINEERS & SURVEYORS
SARASOTA, FLORIDA

ARVIDA CORPORATION
HARBOURSIDE DRIVE and FAIR OAKS LANE
SARASOTA, FLORIDA

PLAN and PROFILE

DWG. No. 191-664

DATE	SCALE	REVISION	BY	CHK	APP
01/15/00	AS SHOWN	1	MB	MB	MB
