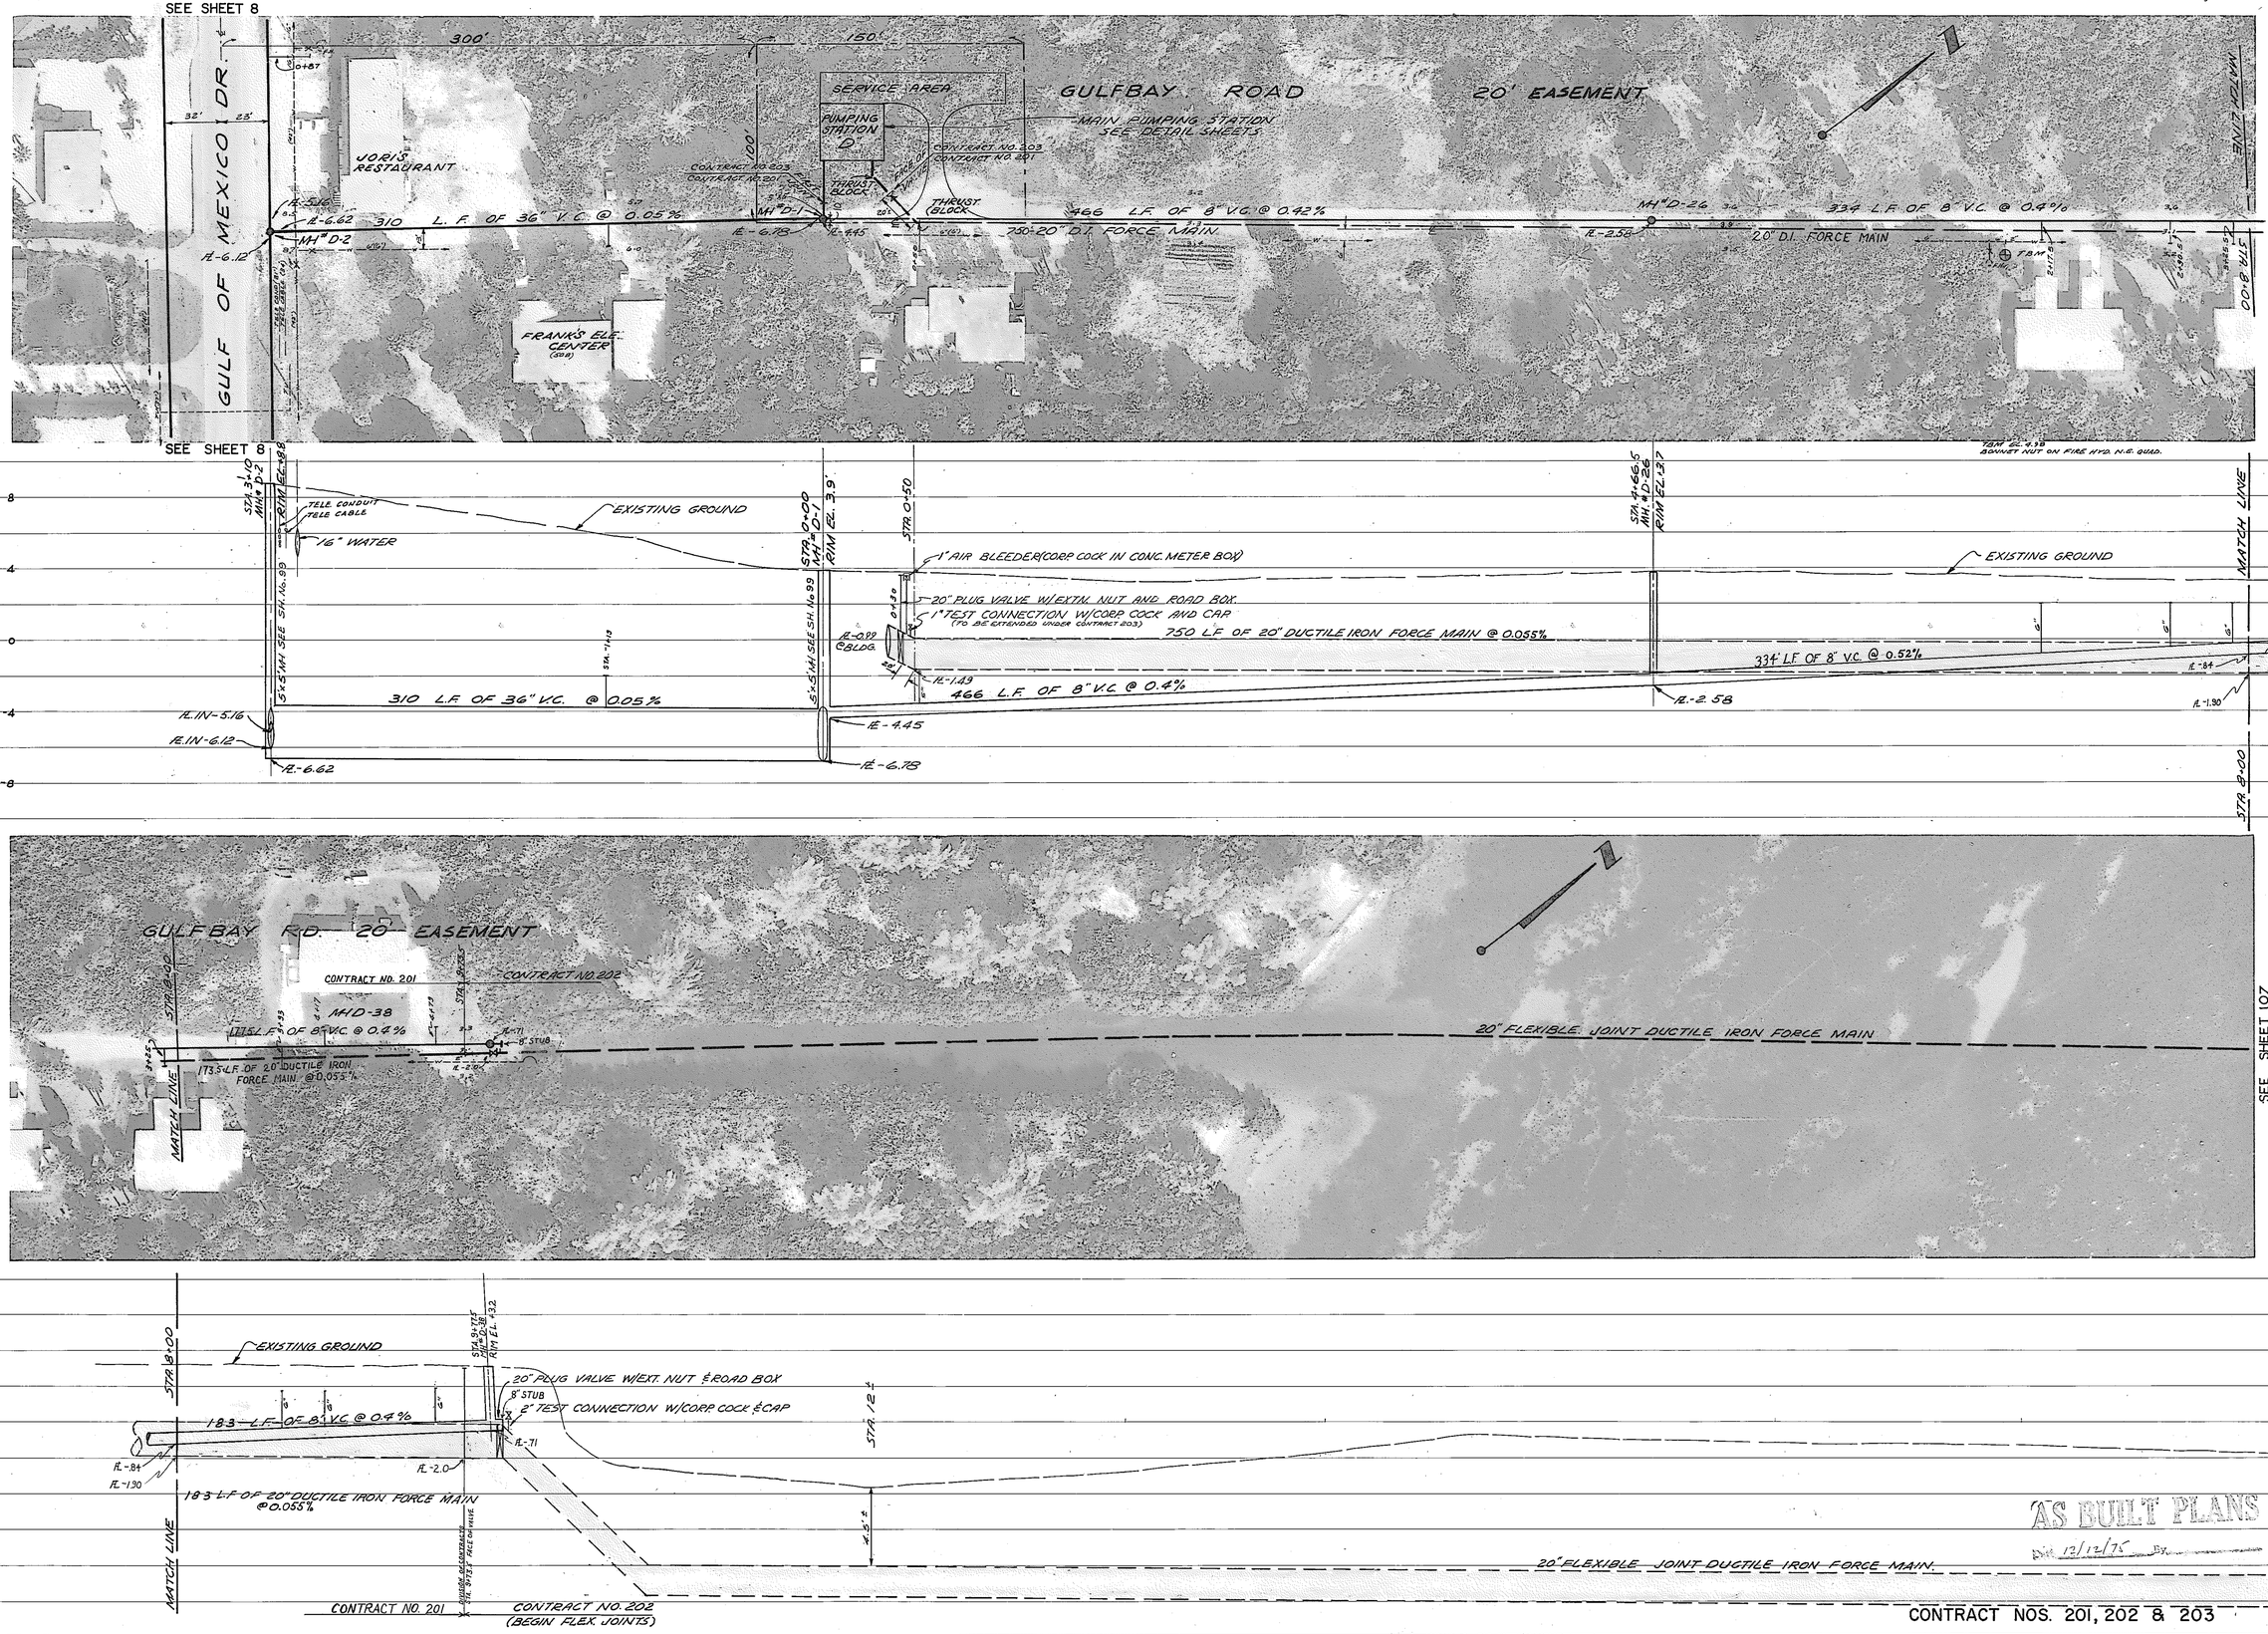

LTR.	DATE	REVISION	BY
A	7-18-73	ADDED LIFT STA. L.S. 20" & VALVE VAULT.	L.D.L.
B	5-15-74	GRAV. LINE & FM GRADES CHANGED & MOVED SLIGHTLY FOR "AS BUILT".	A.J.M.
C	12-8-75	AS BUILT	R.E.W.

PHOTO: BOSWORTH AERIAL SURVEYS SEPT. 1972

APPROVED BY: J. DAVID WEAGE, P.E. FLORIDA REGT. NO. 18801

DESIGNED BY: J.D.W., E.M.W., L.D.L.

DATE: 4-13-73

SCALE: HORIZ. 1"=40' VERT. 1"=4'

DRAWN BY: J.L.

CHECKED BY: J.D.W., M.W., E.E.

PROJECT NO. 1217-S

FOR: TOWN OF LONGBOAT KEY, FLORIDA

STA. 19+94.5

GULFBAY ROAD

WASTEWATER COLLECTION SYSTEM

SMALLY, WELLFORD & NALVEN — CONSULTING ENGINEERS — SARASOTA, FLORIDA

SHEET NUMBER 7

REVISION C

INDEX NO. E-1217-212