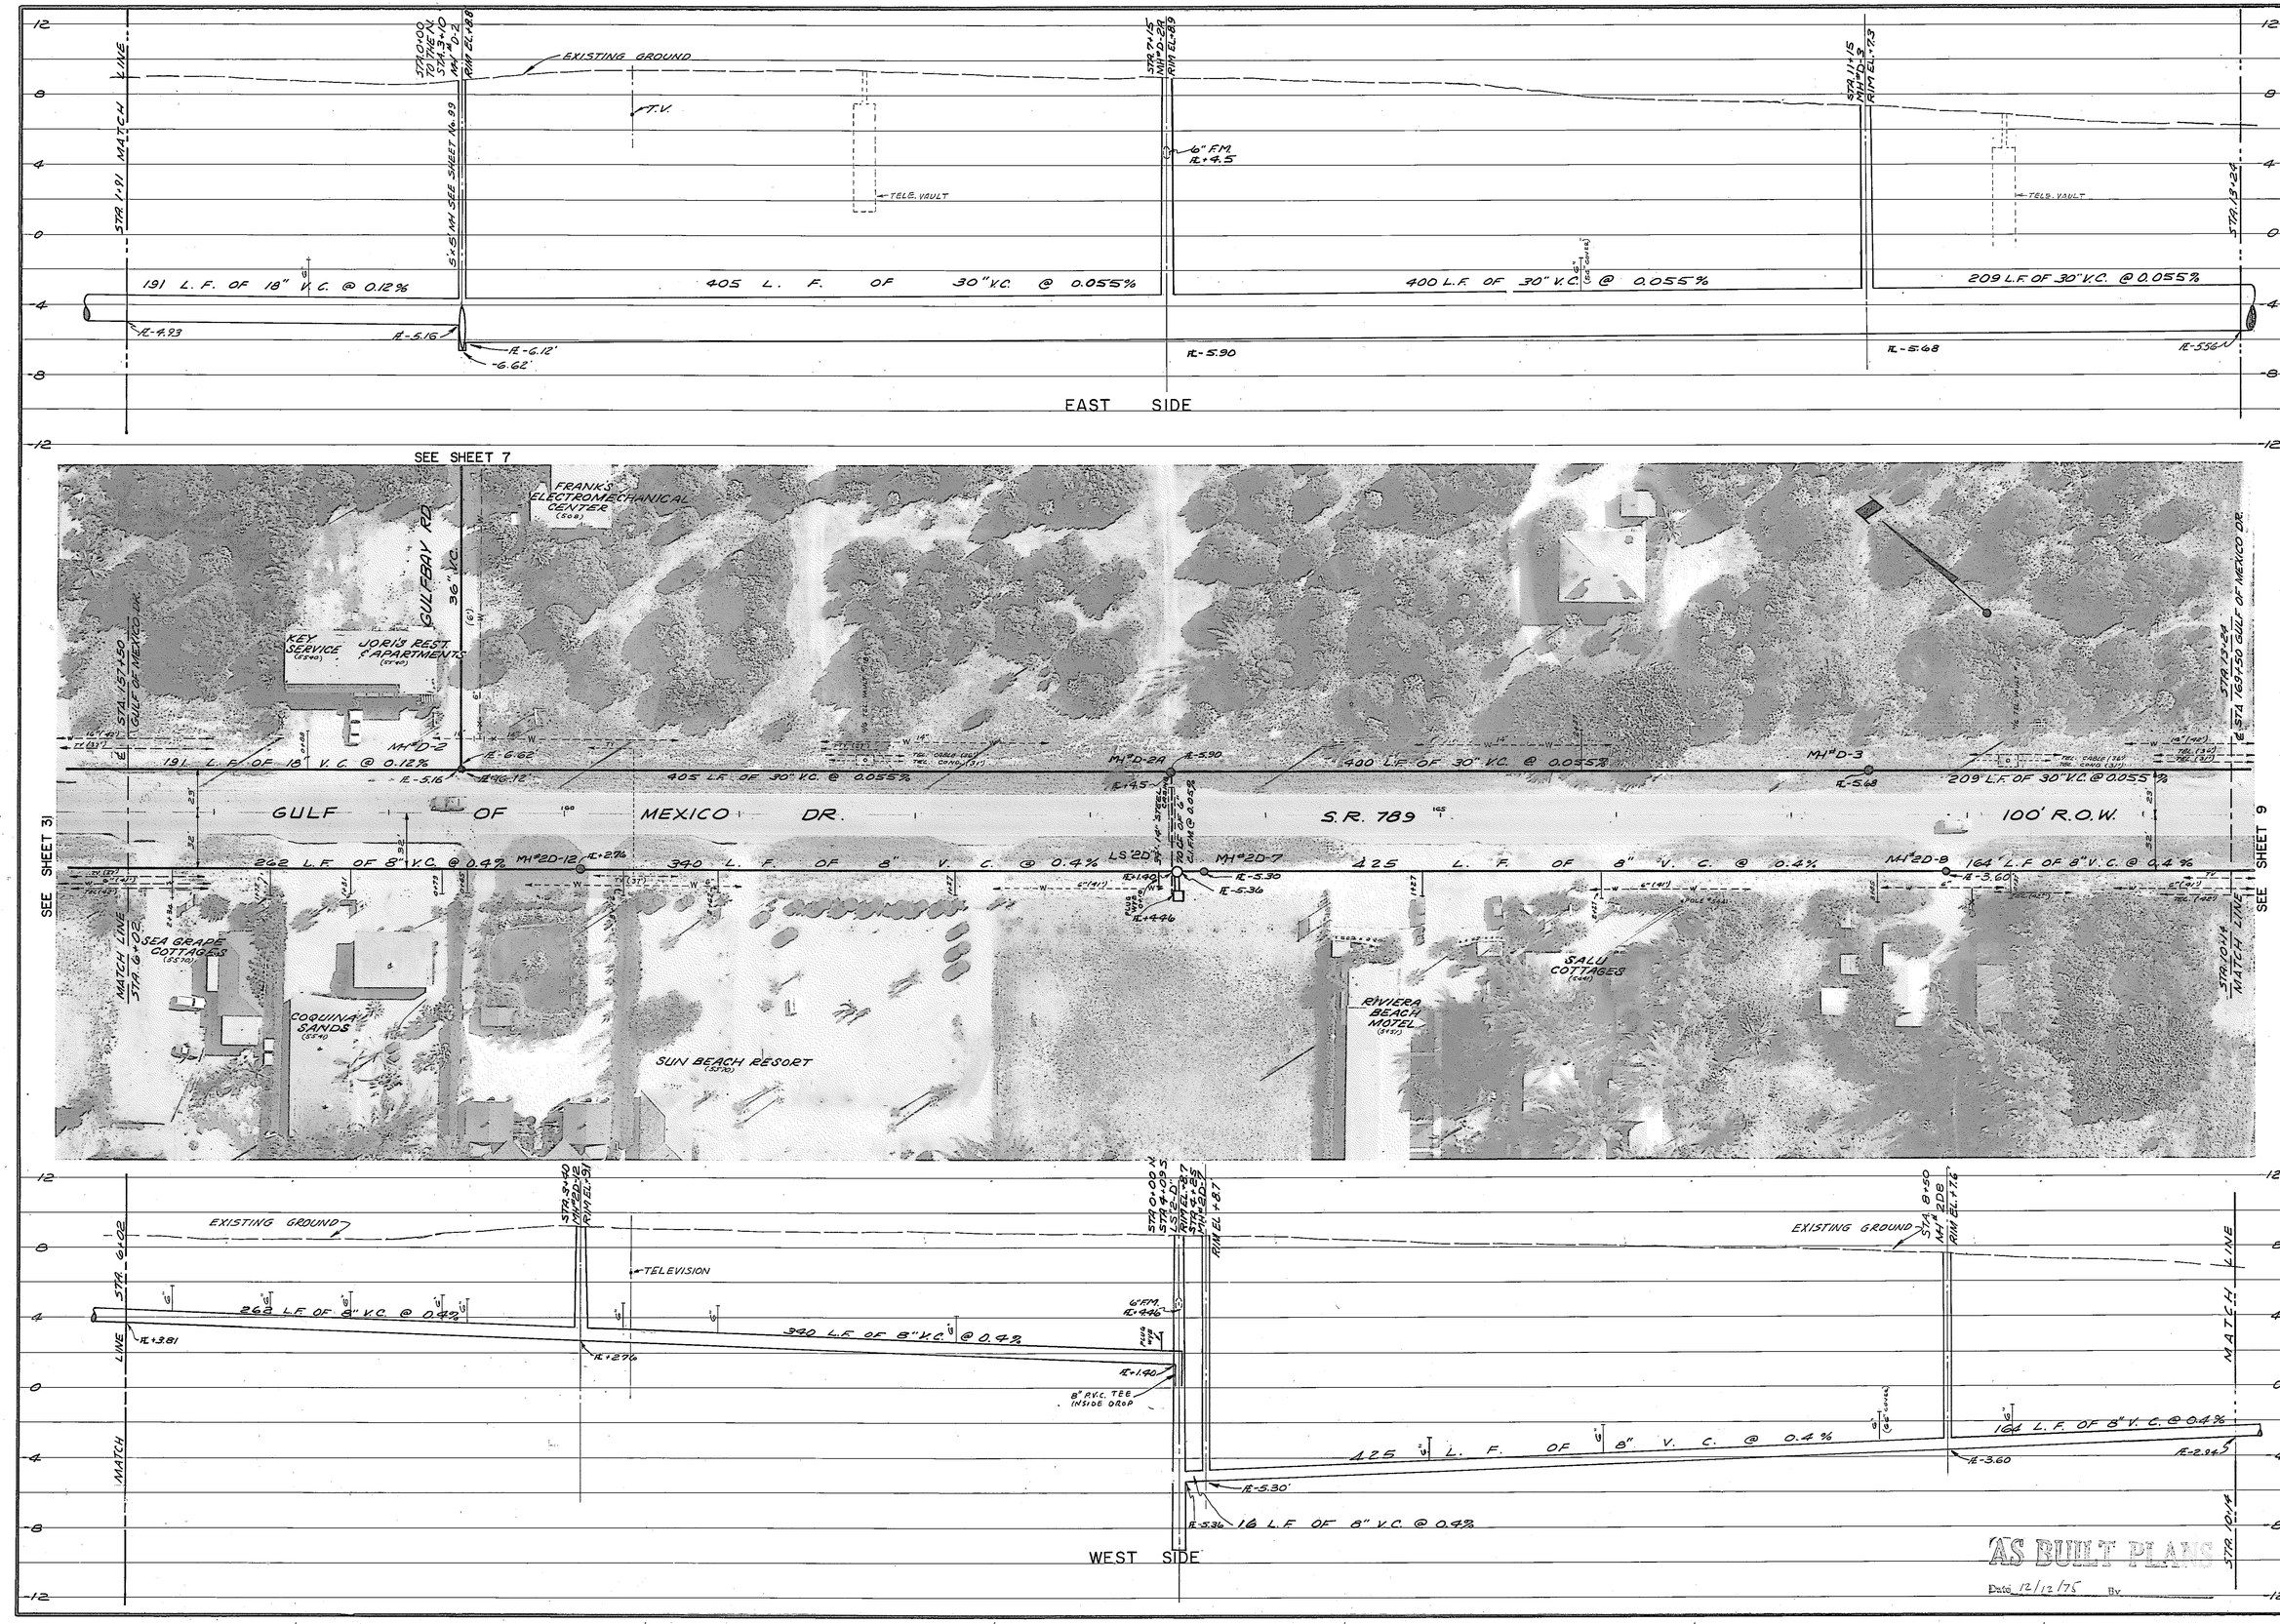

LTR.	DAT	REVISION	BY
A	7-18-73	REMOVED & M.D. CROSSING FROM PROFILE	L.D.L.
B	10-22-74	RELOCATE L.S. "2-D"; ADD MH #2D-12, MH #D-2A & MH #D-3	L.D.L.
C	2-19-75	AS BUILT	P.C.W.

PHOTO: BOWORTH & HALL SURVEYS SEPT. 1972

APPROVED BY J. DAVID WEAGE, P.E. FLORIDA LICENSE NO. 13501

DESIGNED BY J.D.W. F.W.N. J.L.C.

DATE: 4-13-73

SCALE: HORZ. 1" = 40' VERT. 1" = 4'

CHECKED BY J.D.W. F.W.N. J.L.C. E.C.

DRAWN BY P.C.W.

PROJECT NO. 1217-S

CONSULTING ENGINEERS — SARASOTA, FLORIDA

SMALLY, WELLFORD & NALVEN

FOR: TOWN OF LONGBOAT KEY, FLORIDA

GULF OF MEXICO DRIVE
W. MH 2D-1 TO MH 2D-8, E. MH D-2 TO MH D-3
WASTEWATER COLLECTION SYSTEM

SHEET NUMBER 8

REVISION "C"

INDEX NO. E-1217-213