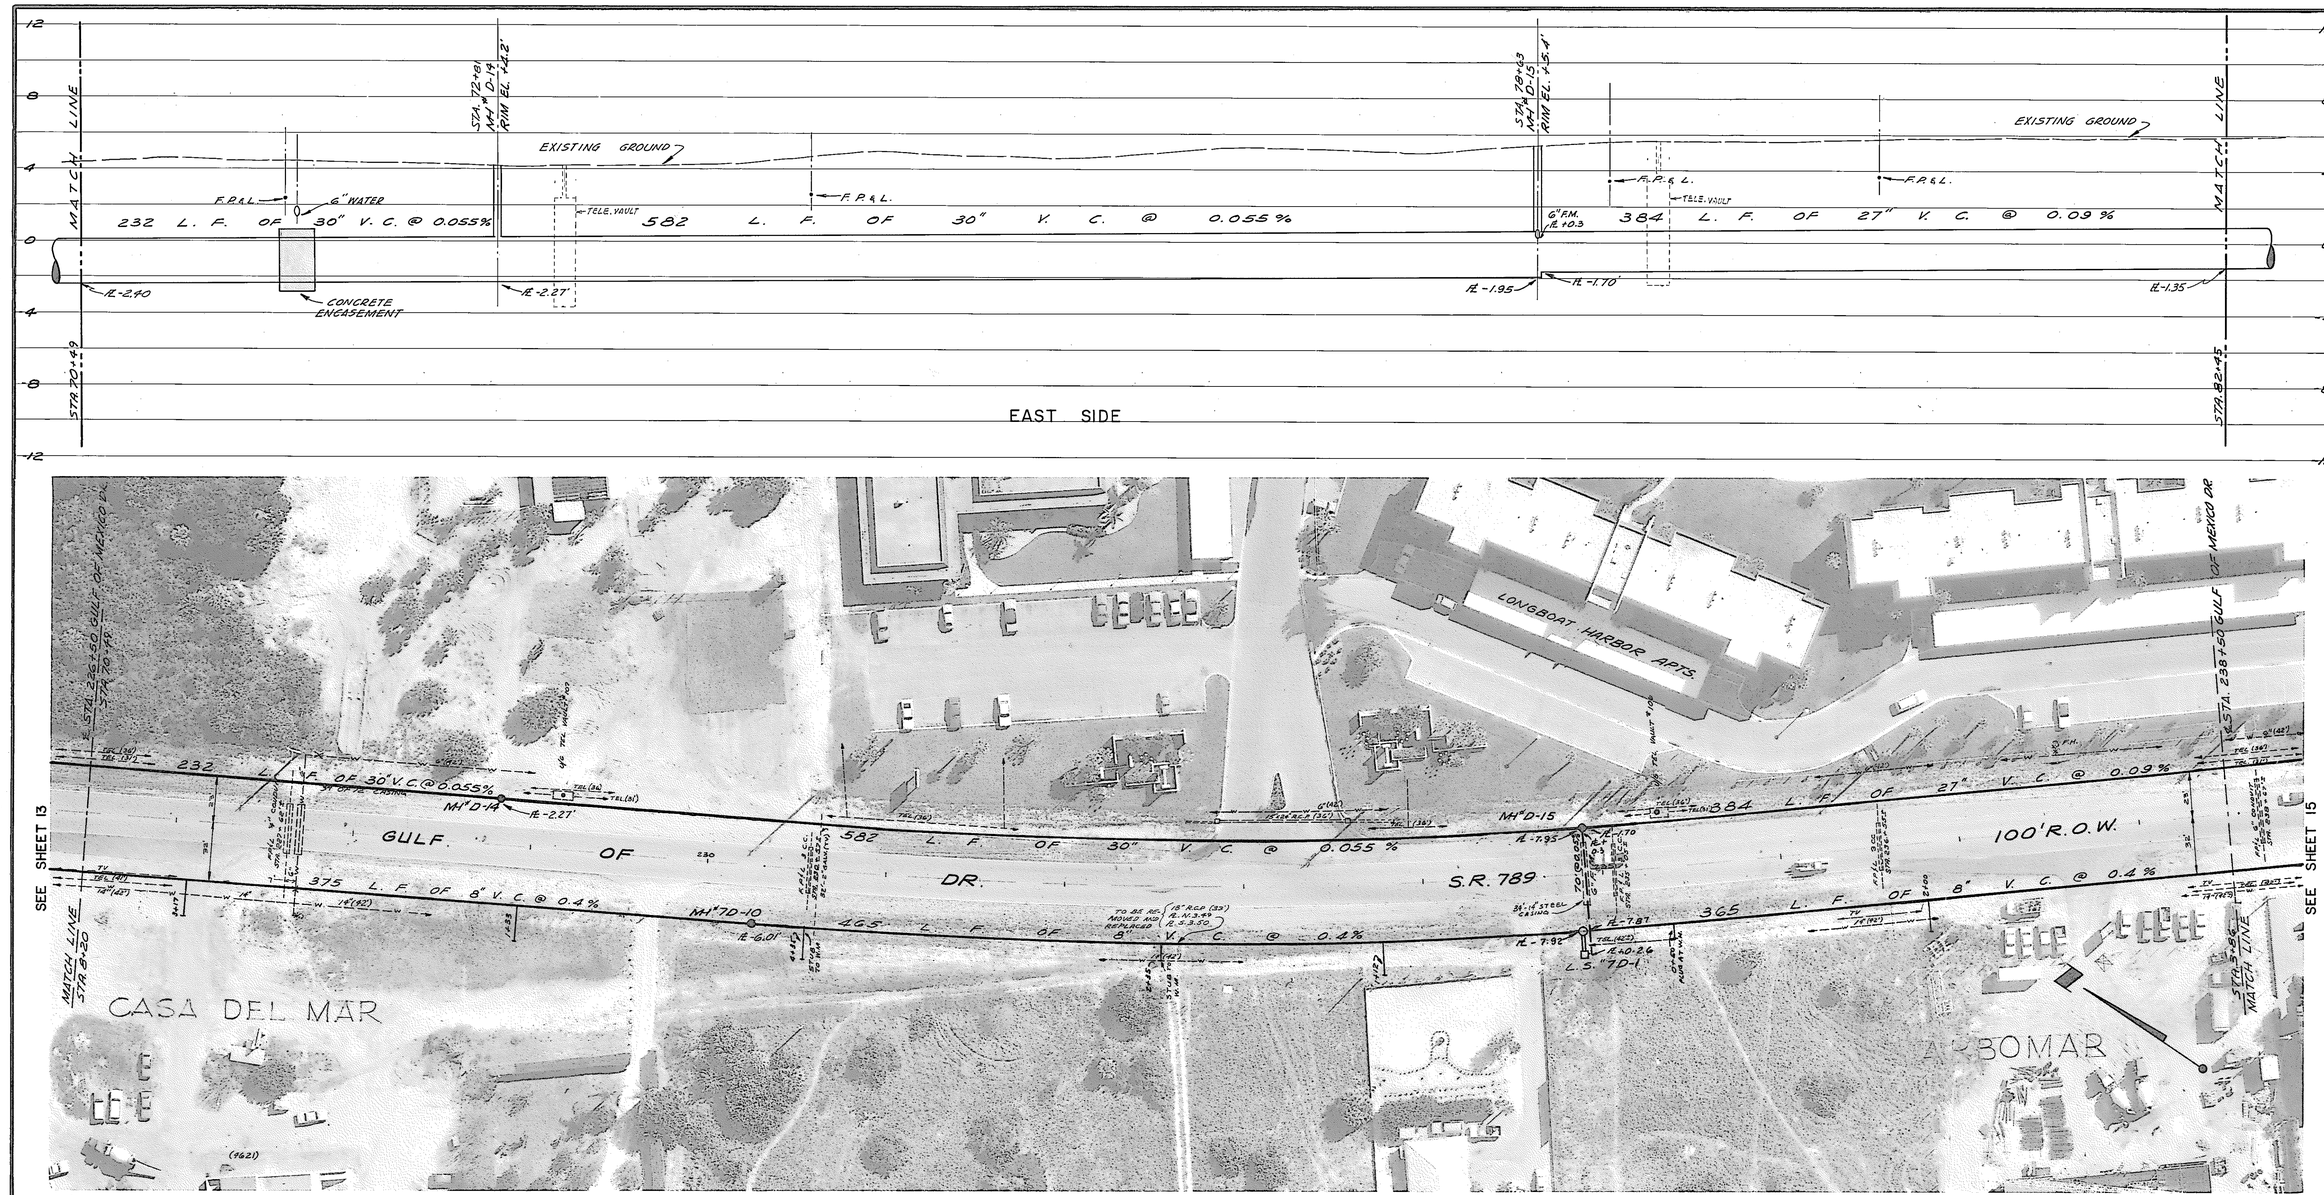

PHOTO - BOSWORTH AERIAL SURVEYS SEPT. 1972	APPROVED BY
DESIGNED BY J.D.M., E.M.W. L.D.L.	J. DAVID WEAGE, P.E. FLORIDA CERT. NO. 13801
DATE: 4-13-73	PROJECT NO. 1217-S
SCALE: HORIZ. 1"=40' VERT. 1"=4'	
DRAWN BY P.C.W.	CHECKED BY J.G. E.M.W.

LTR.	DATE	REVISION	BY
"A"	7/7/73	APPROVED SERVICES	P.C.W.
"B"	12/8/75	AS BUILT	P.C.W.

FOR: TOWN OF LONGBOAT KEY, FLORIDA
GULF OF MEXICO DRIVE
W. MH 7D-10 TO MH 7D-1, E. MH D-14 TO MH D-15
WASTEWATER COLLECTION SYSTEM

SMALLY, WELLFORD & NALVEN — CONSULTING ENGINEERS — SARASOTA, FLORIDA

SHEET NUMBER 14

REVISION "B"

INDEX NO. E-1217-219