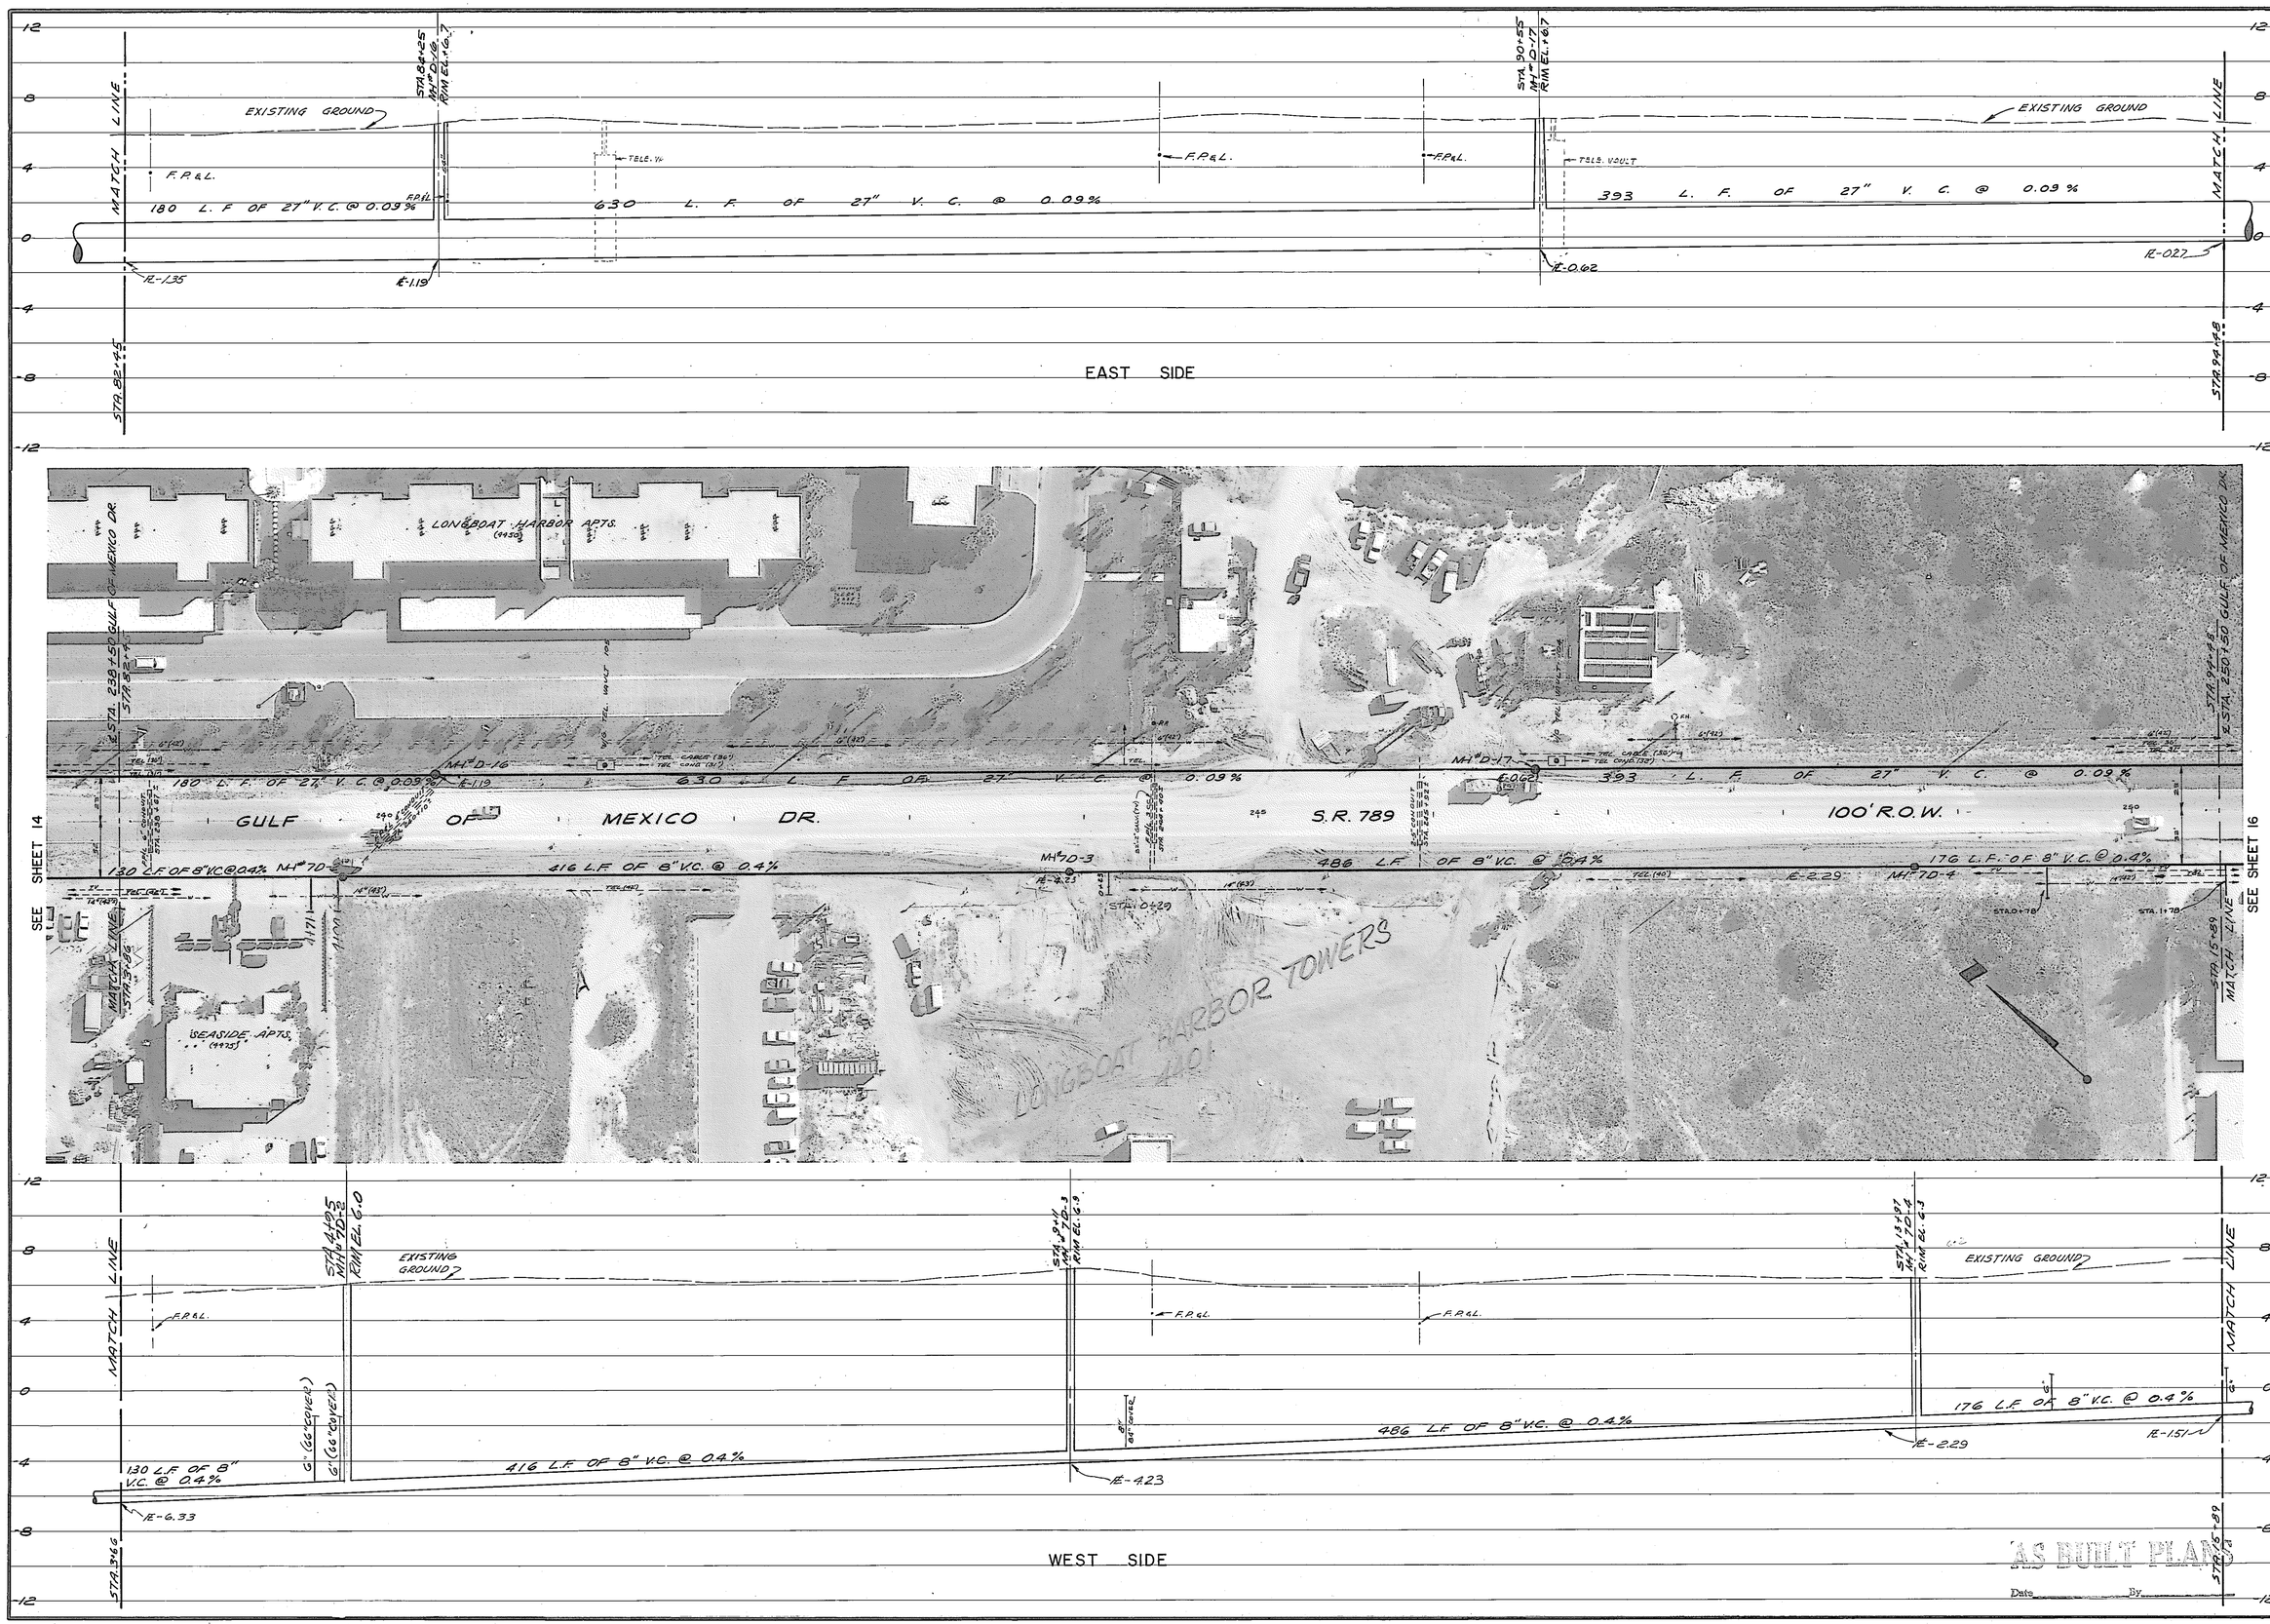

LTR.	DATE	REVISION	BY
A	7-18-73	ADDED F.P.&L. CROSSING STA. 240+10	I.D.L.
B	7-8-75	AS BUILTS - RELOCATED MH D-16, D-17, 70-2, & 70-3	P.C.W.

PHOTO: BURNETTE AERIAL SURVEYS SEPT. 1972

DESIGNED BY J.D.W. / J.M.W. / J.C.

APPROVED BY J. DAVID WEAGE, P.E. FLORIDA REG. NO. 19081

SCALE: HORZ. 1" = 40' VERT. 1" = 4'

DATE: 4-13-73

DRAWN BY P.C.W.

CHECKED BY J.J.S. / J.M.W. / E.C.

PROJECT NO. 1217-S

FOR: TOWN OF LONGBOAT KEY, FLORIDA

GULF OF MEXICO DRIVE
W. MH 7D-2 TO MH 7D-4, E. MH D-16 TO MH D-17
WASTEWATER COLLECTION SYSTEM

SMALLY, WELLFORD & NALVEN — CONSULTING ENGINEERS — SARASOTA, FLORIDA

SHEET NUMBER 15

REVISION 'B'

INDEX NO. E-1217-220