INDEX NO. E-1217-225

SMALLY, WELLFORD & NALVEN — CONSULTING ENGINEERS — SARASOTA, FLORIDA

SHEET NUMBER 20

REVISION | BY | DATE | APPROVED

LTR.	REVISION	BY	DATE	APPROVED
A	MOVED L.S. 3+25' / ADDED VALVE BOX	J.D.W.	7-18-73	
B	ADDED SEWERS	J.D.W.	7-14-73	

FOR: TOWN OF LONGBOAT KEY, FLORIDA

KINGFISHER LANE, ROYAL ROAD
WASTEWATER COLLECTION SYSTEM

SCALE: HORIZ. 1"=40' VERT. 1"=4'
DRAWN BY: J.D.W., E.M.W.
CHECKED BY: J.D.W., E.C.
DATE: 4-13-73
PROJECT NO. 1217-S
DESIGNED BY: J.D.W., E.M.W., J.D.W.

PHOTO: BOSWORTH AERIAL SURVEYS
SEPT. 1972

APPROVED BY
J. DAVID WEARE, P.E.
FLORIDA CERT. NO. 9161
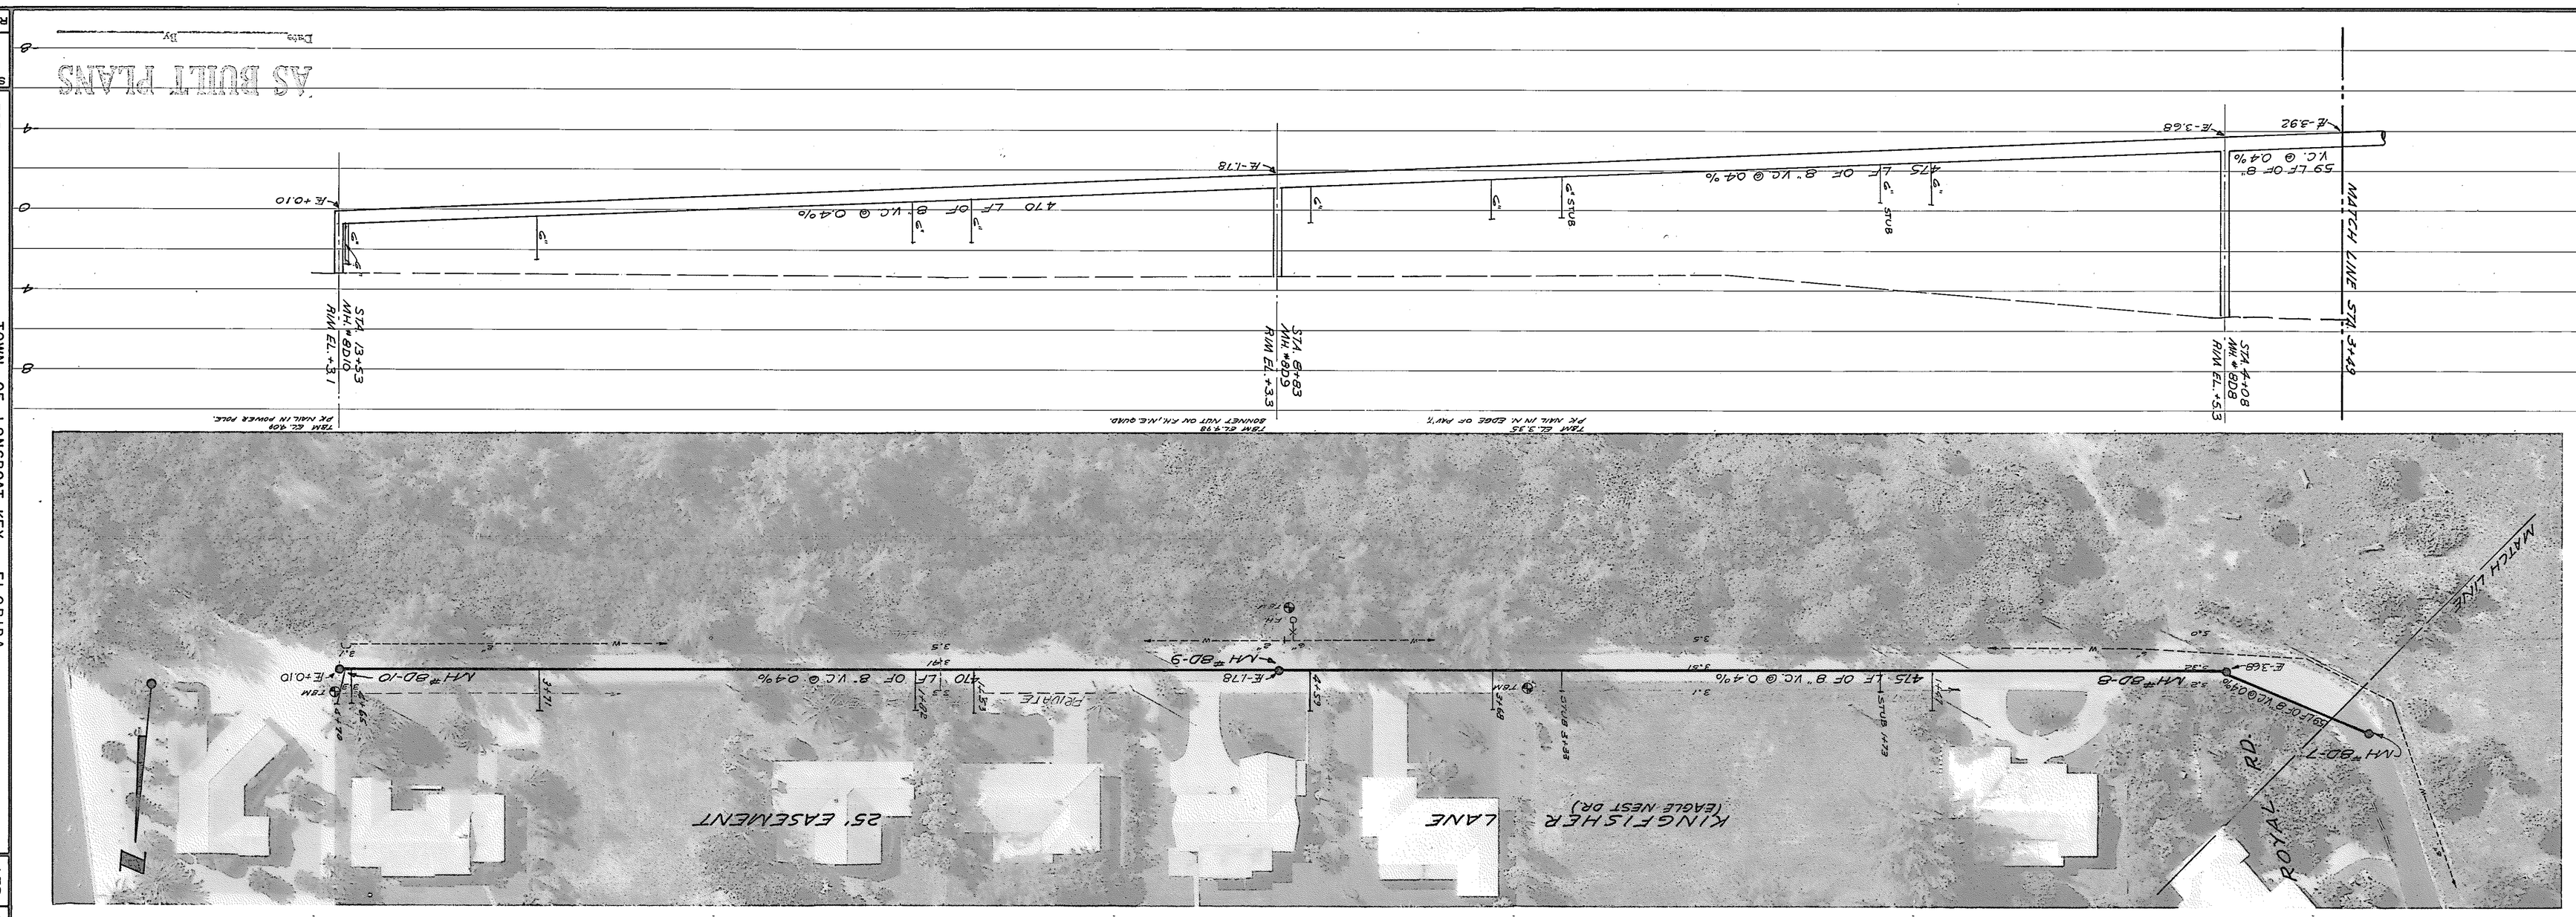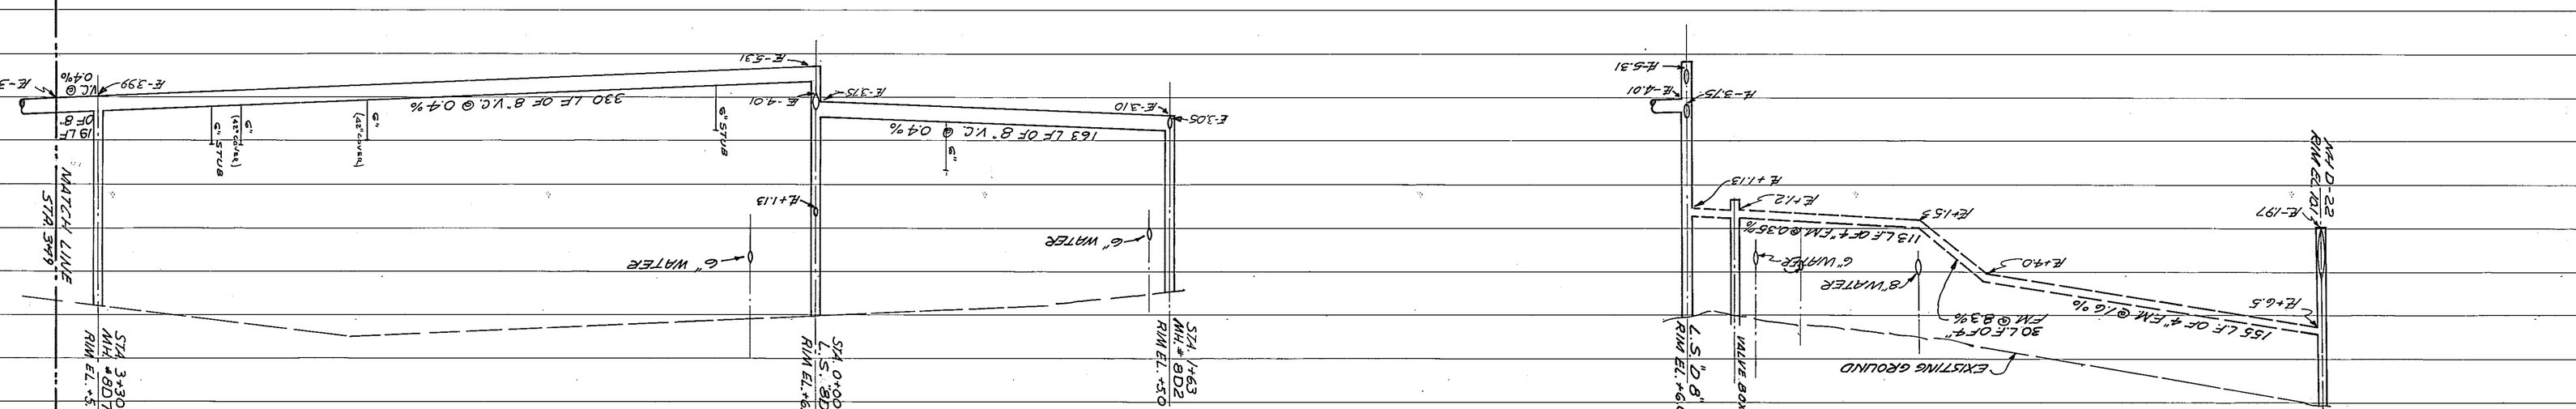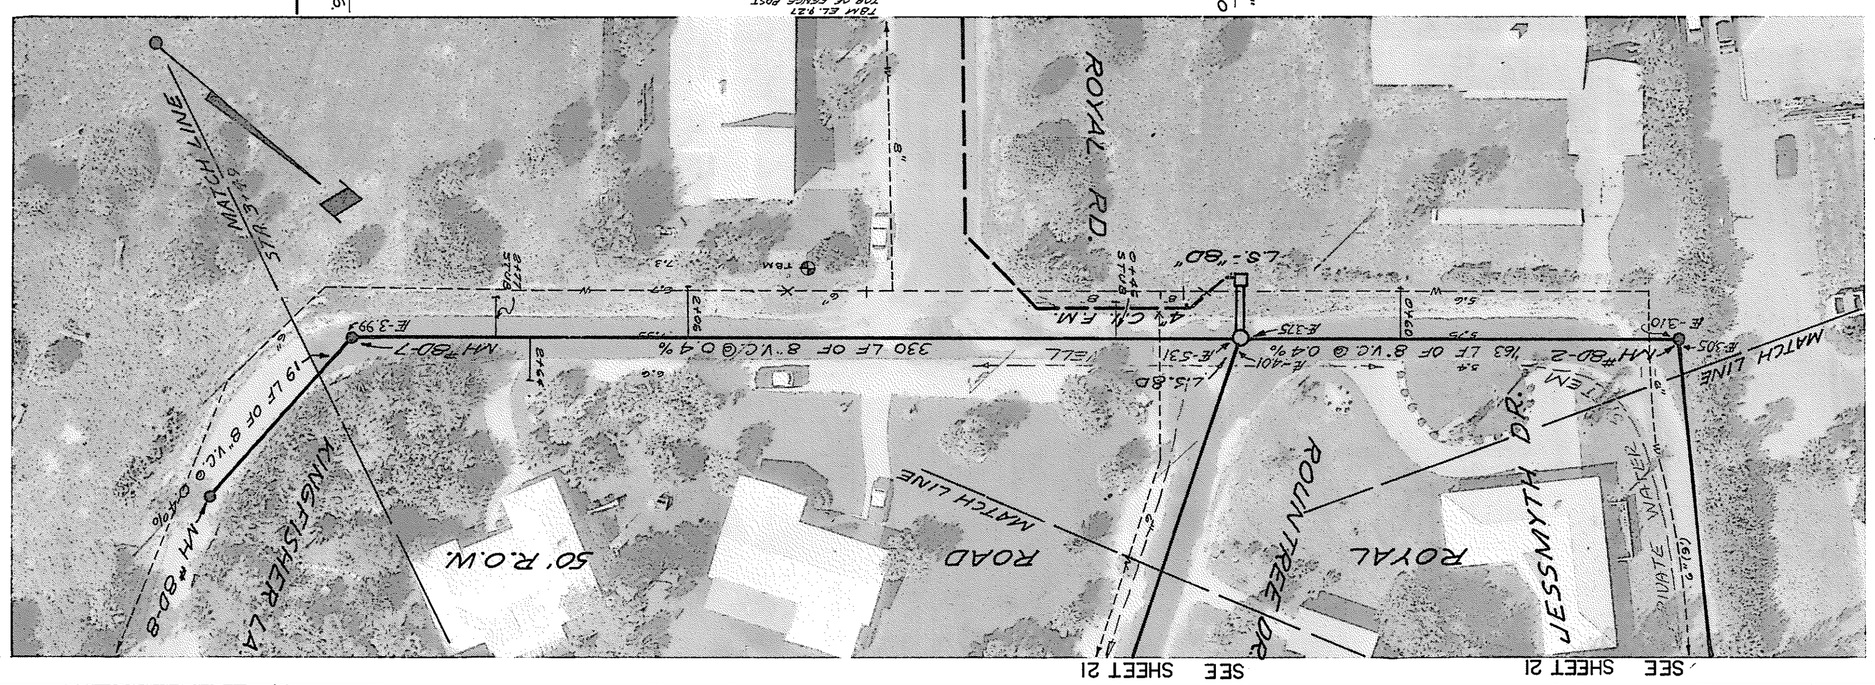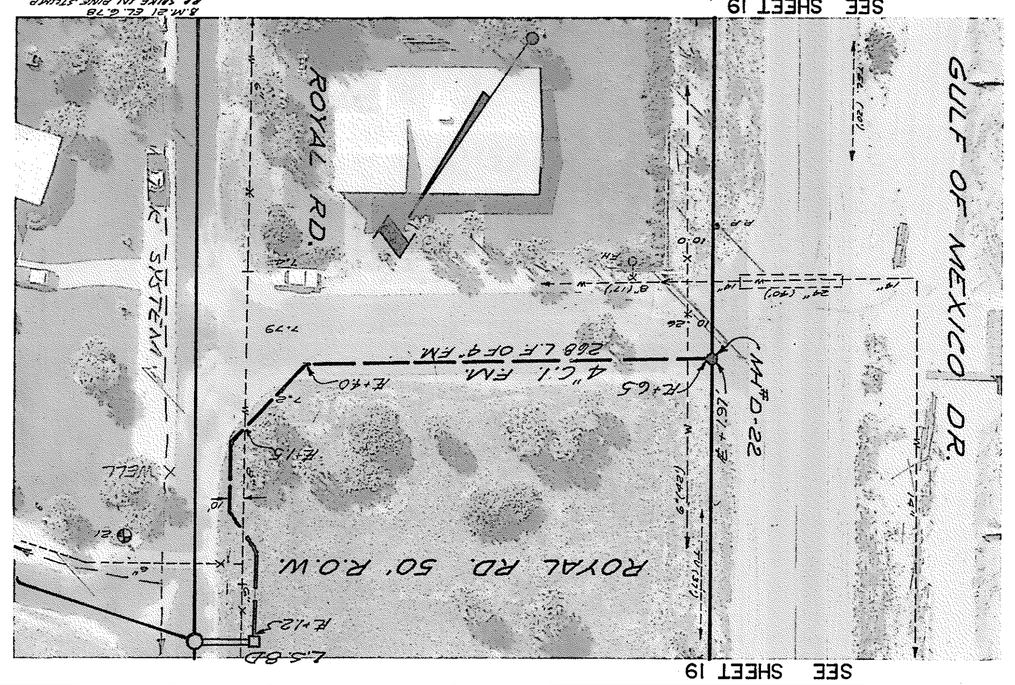
AS BUILT PLANS