


JESSMYTH DRIVE, ROUNDTREE DRIVE  
 WASTEWATER COLLECTION SYSTEM

TOWN OF LONGBOAT KEY, FLORIDA  
 FOR: JESSMYTH DRIVE, ROUNDTREE DRIVE  
 WASTEWATER COLLECTION SYSTEM

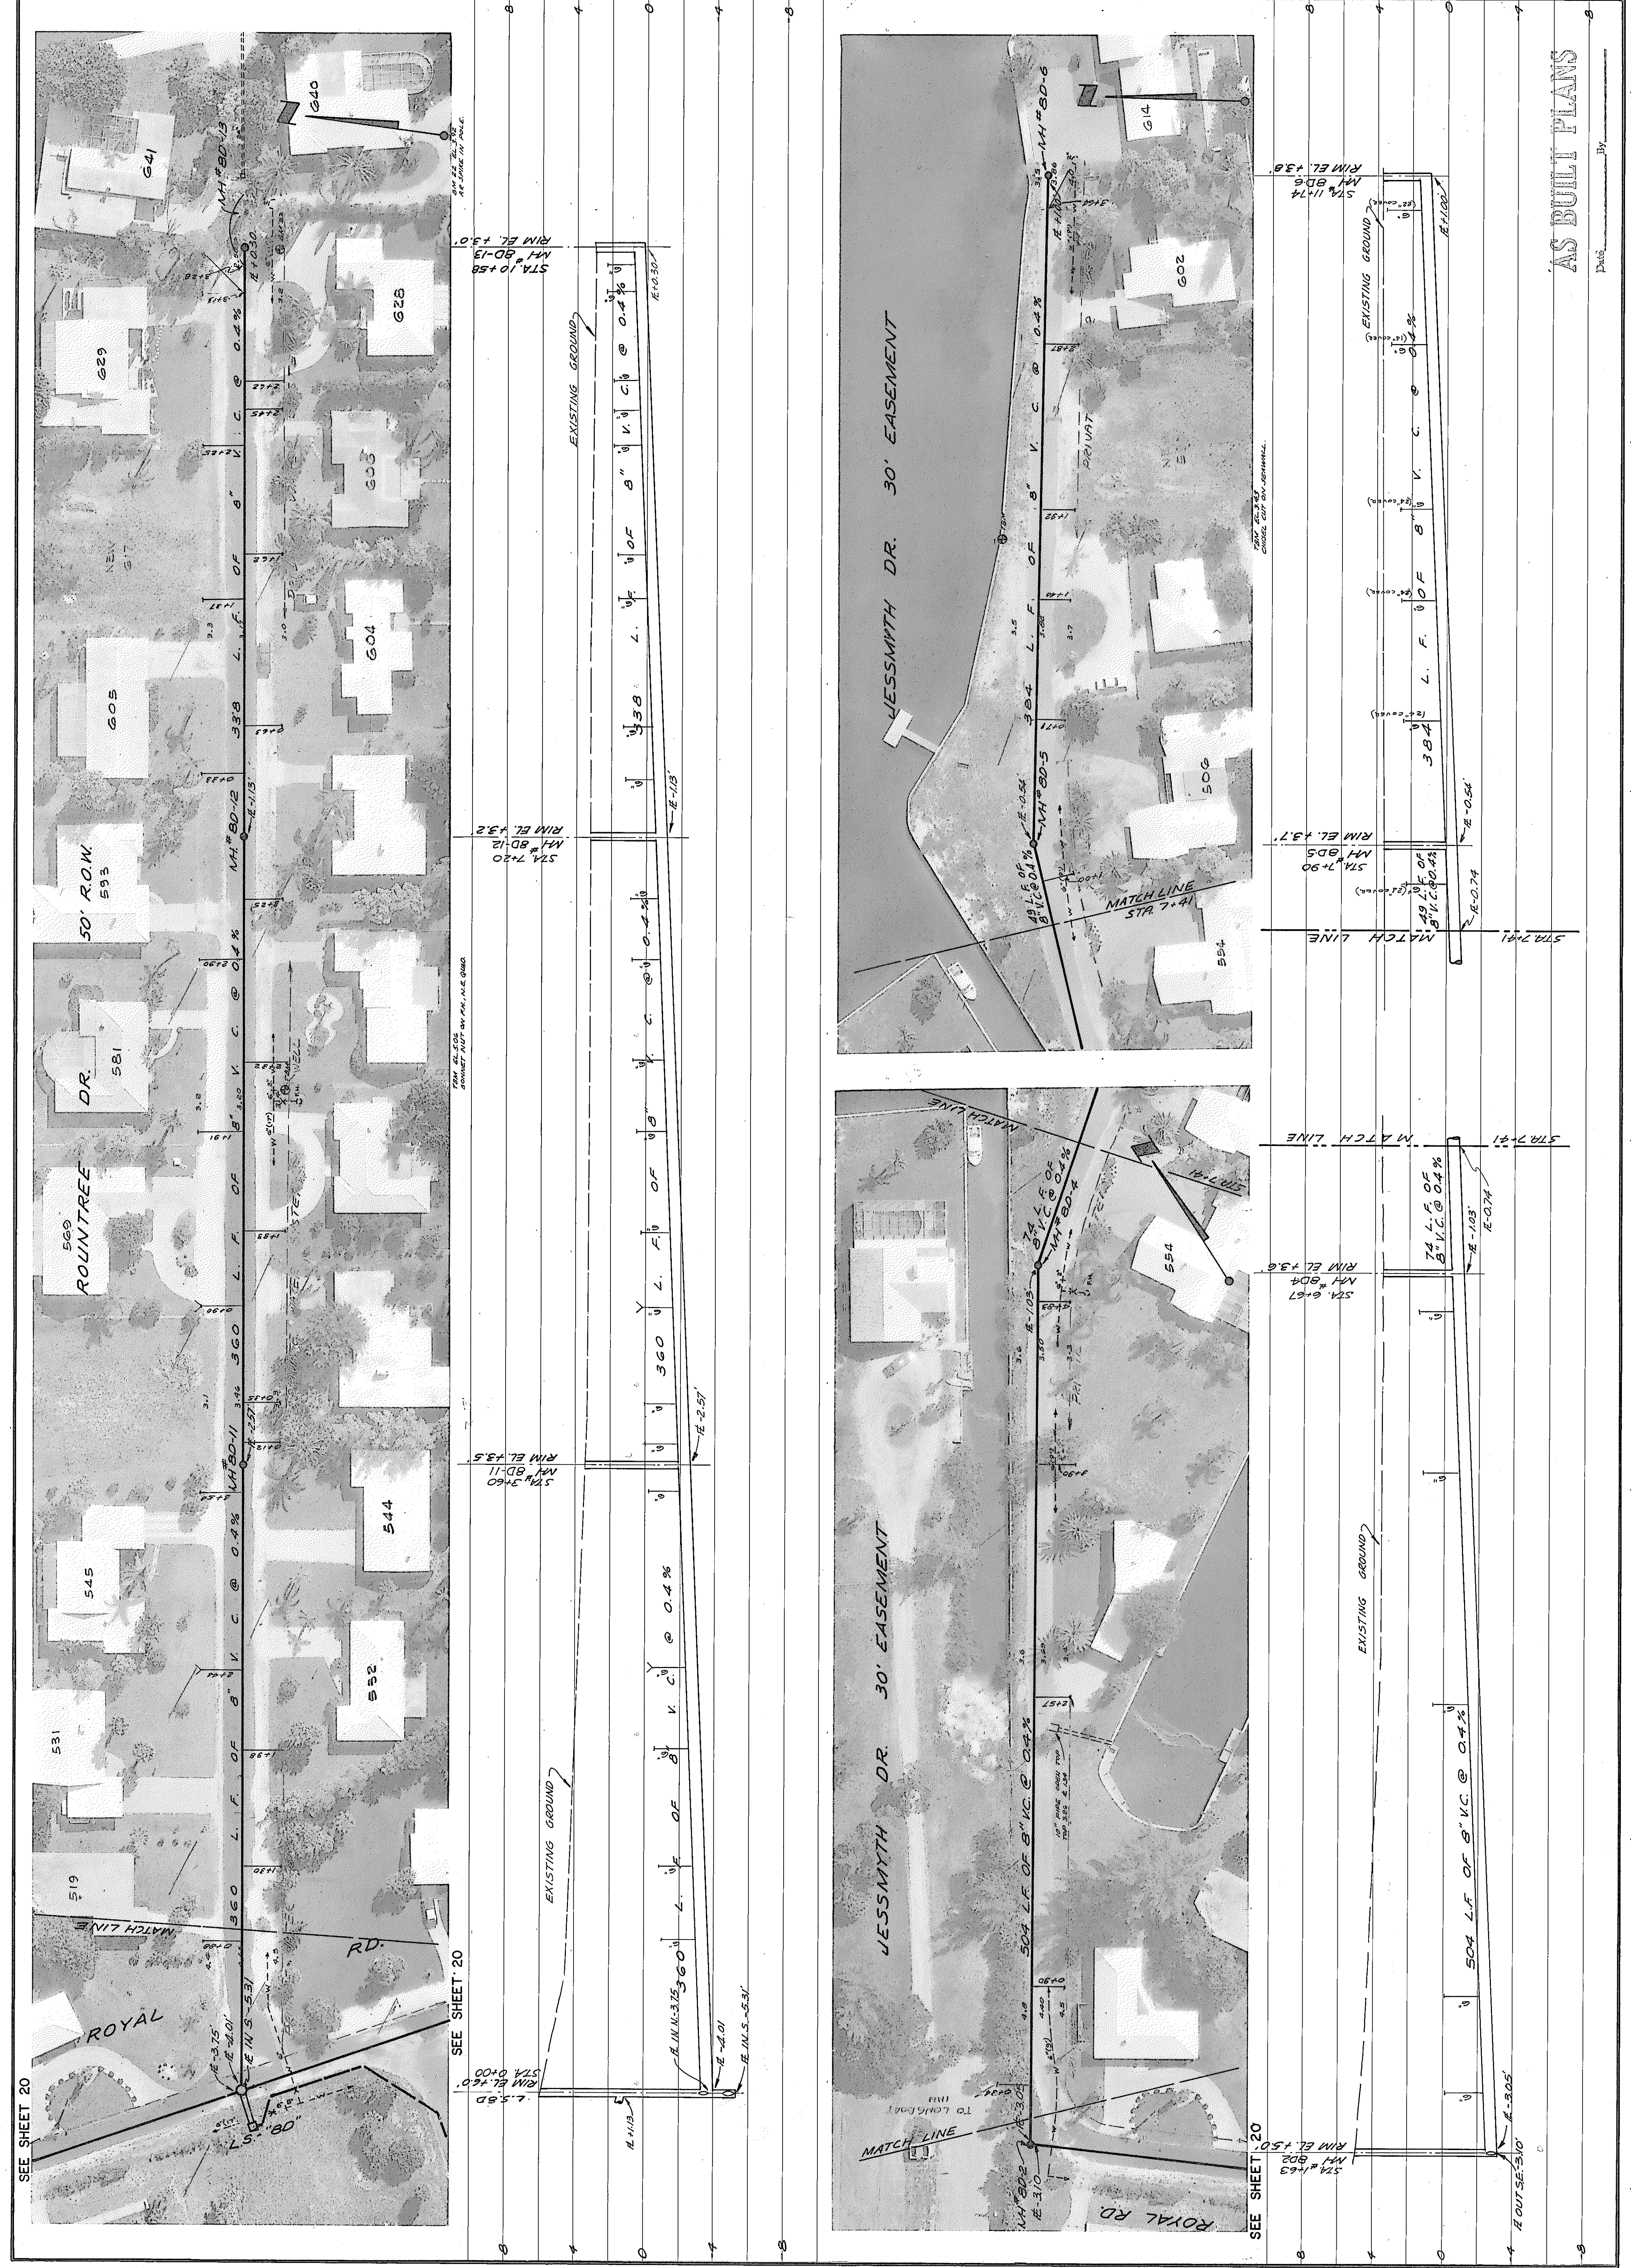

AS BUILT PLANS

Date: \_\_\_\_\_  
 By: \_\_\_\_\_

SEE SHEET 20

SEE SHEET 20

SEE SHEET 20

SEE SHEET 20