EAST SIDE

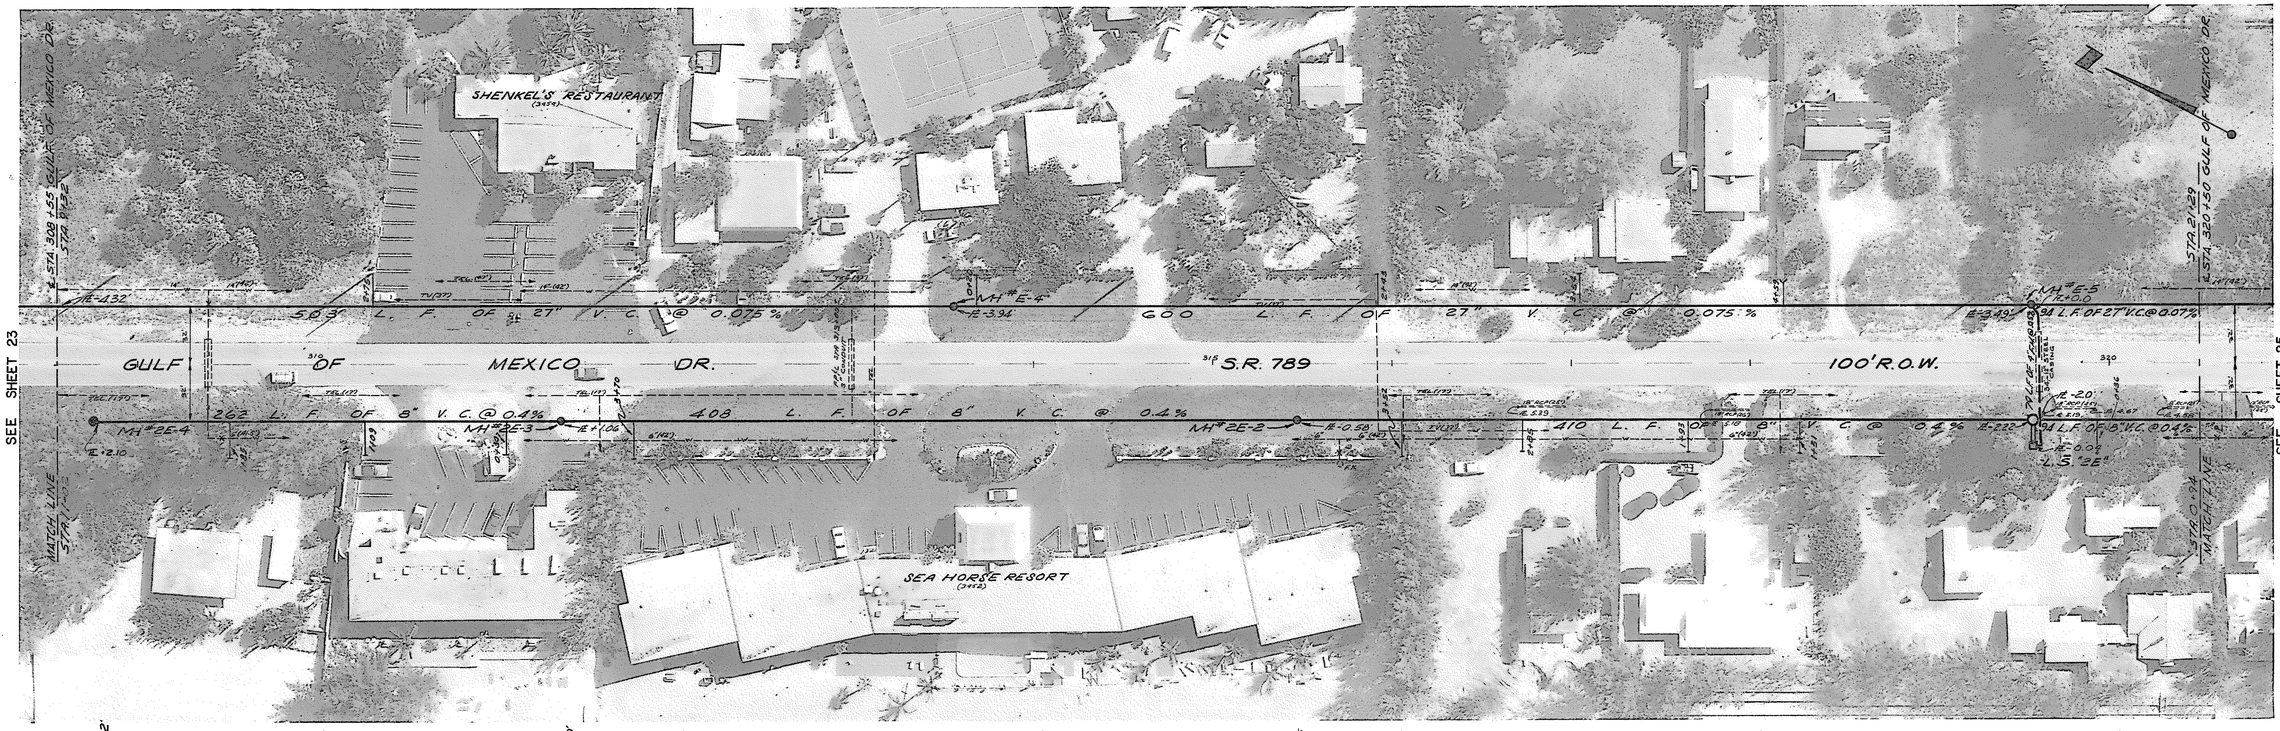

WEST SIDE

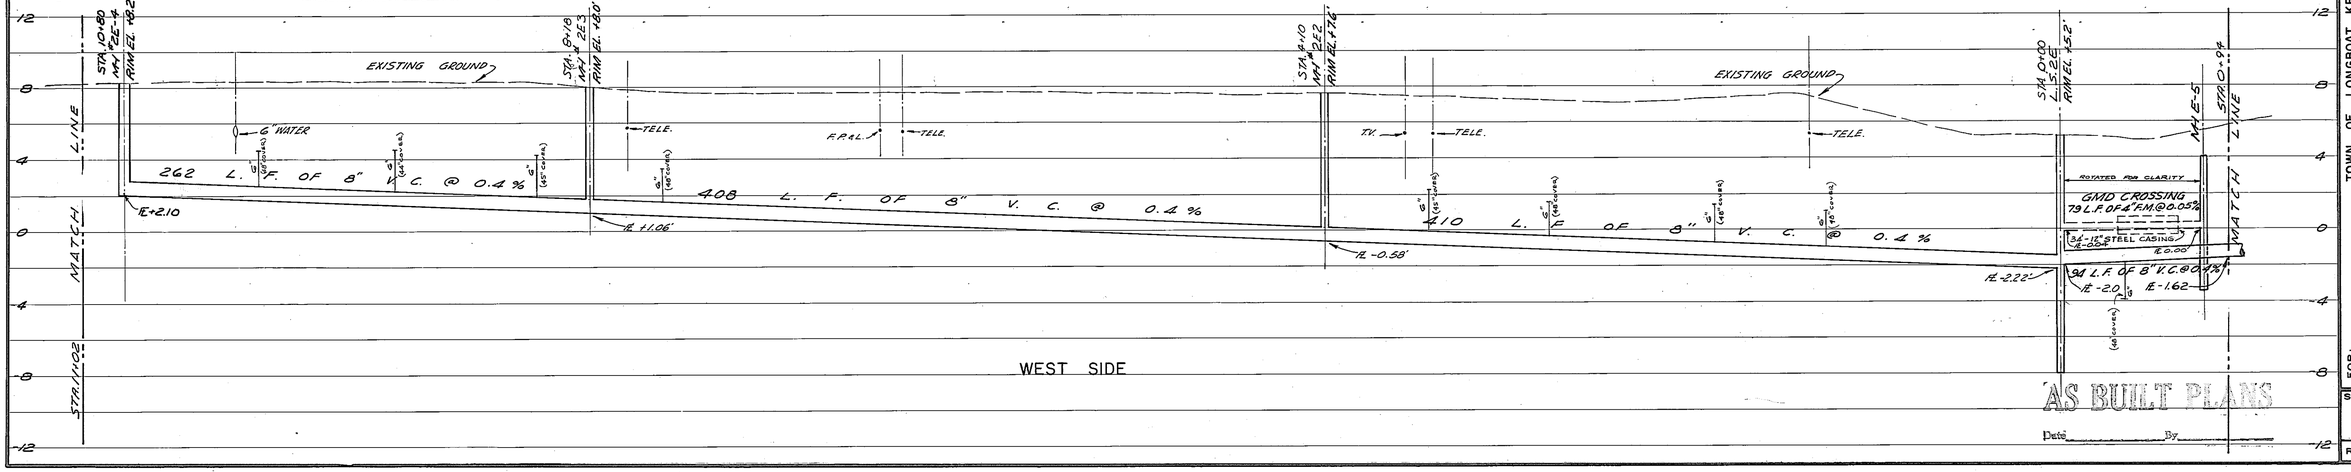

AS BUILT PLANS

Date _____ By _____

BY	REVISION	DATE	LTR.
L.O.L. P.C.W.	REDESIGN MH #E-4 AS BUILT ADDED SERVICES	1/4/72 1/8/74	"A" "B"

DESIGNED BY: PHOTO-GOSSWORTH AERIAL SURVEYS SEPT. 1972 — APPROVED BY

DATE: 4-13-73 — CHECKED BY: L.O.L. P.C.W. — PROJECT NO. 1217-S

SCALE: HORIZ. 1"=40' VERT. 1"=4' — DRAWN BY: P.C.W.

J. DAVID WEAGE, P.E. FLORIDA CERT. NO. 7809

SMALLY, WELLFORD & NALVEN — CONSULTING ENGINEERS — SARASOTA, FLORIDA

FOR: TOWN OF LONGBOAT KEY, FLORIDA

GULF OF MEXICO DRIVE
W. MH 2E-4 TO MH 2E-1, E. MH E-4 TO MH E-5
WASTEWATER COLLECTION SYSTEM

SHEET NUMBER 24

REVISION "B"

INDEX NO. E-1217-229